


MEDINA - NORWALK

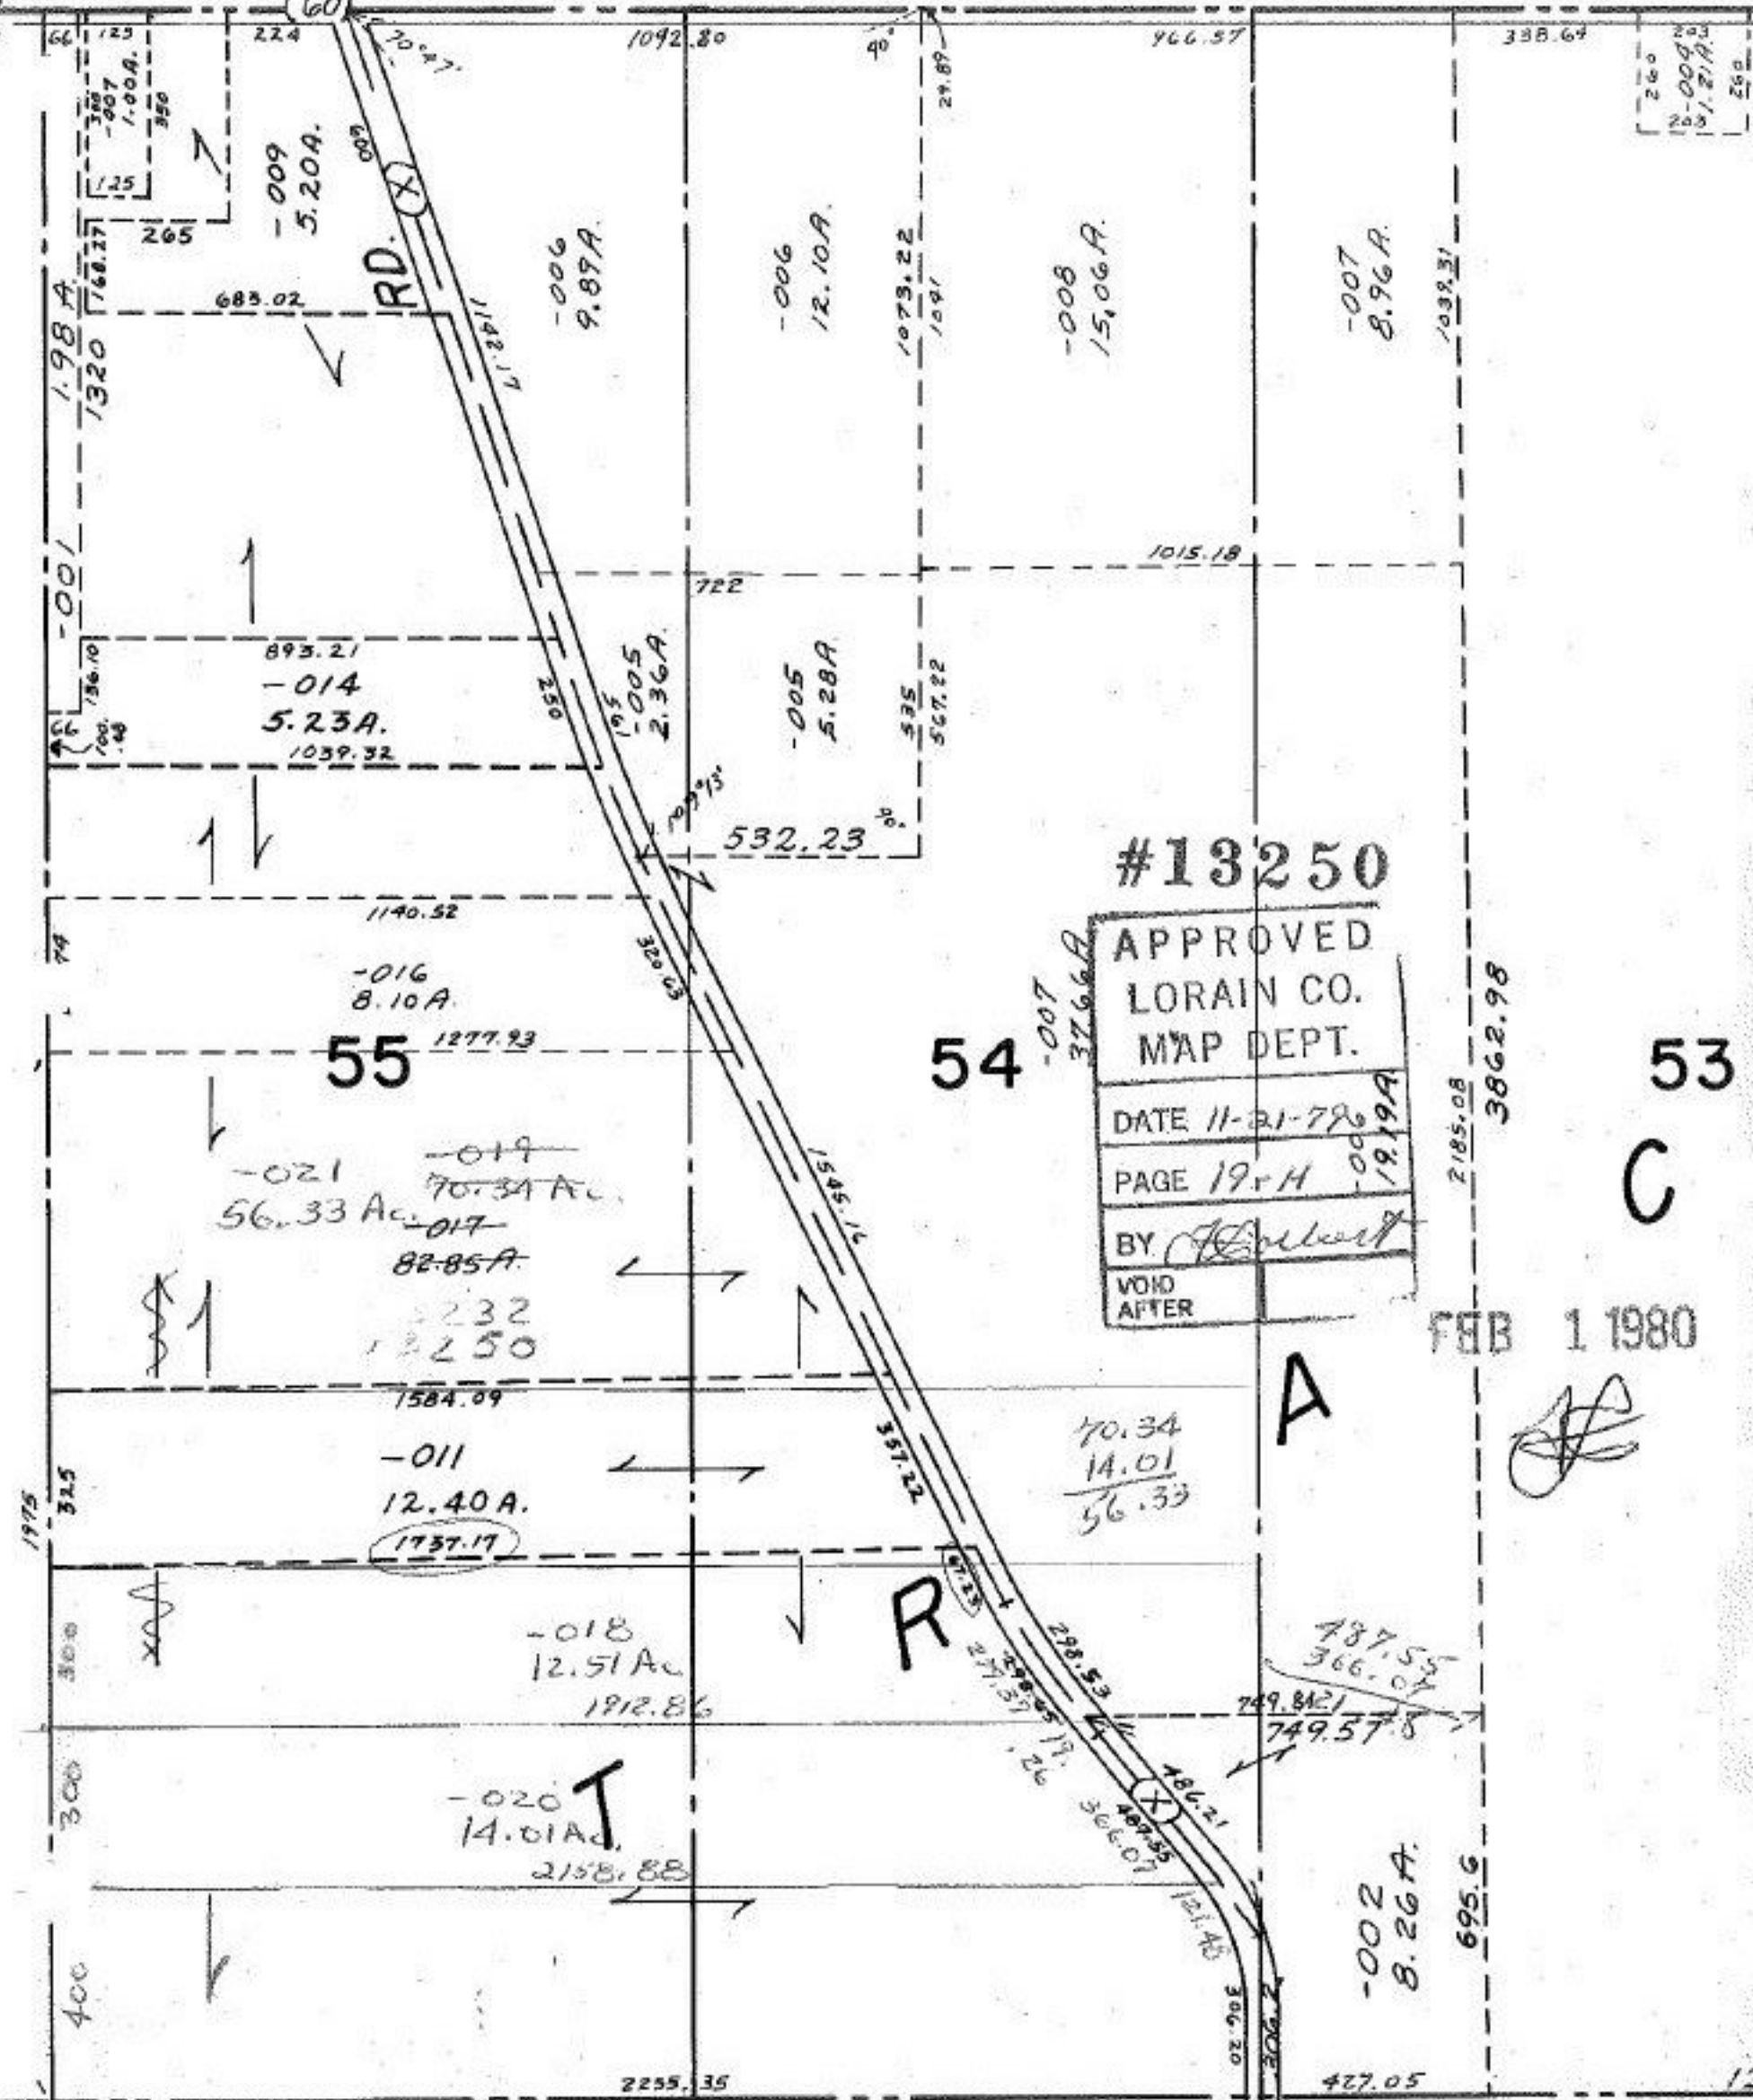

#13250

APPROVED
LORAIN CO.
MAP DEPT.

DATE 11-21-78

PAGE 19rH

BY *[Signature]*

VOID AFTER

FEB 1 1980

53
C

A

R

[Signature]