


6 WOOSTER AVON LAKE

83

1046/505
-061
0.07A
1251/110
110A

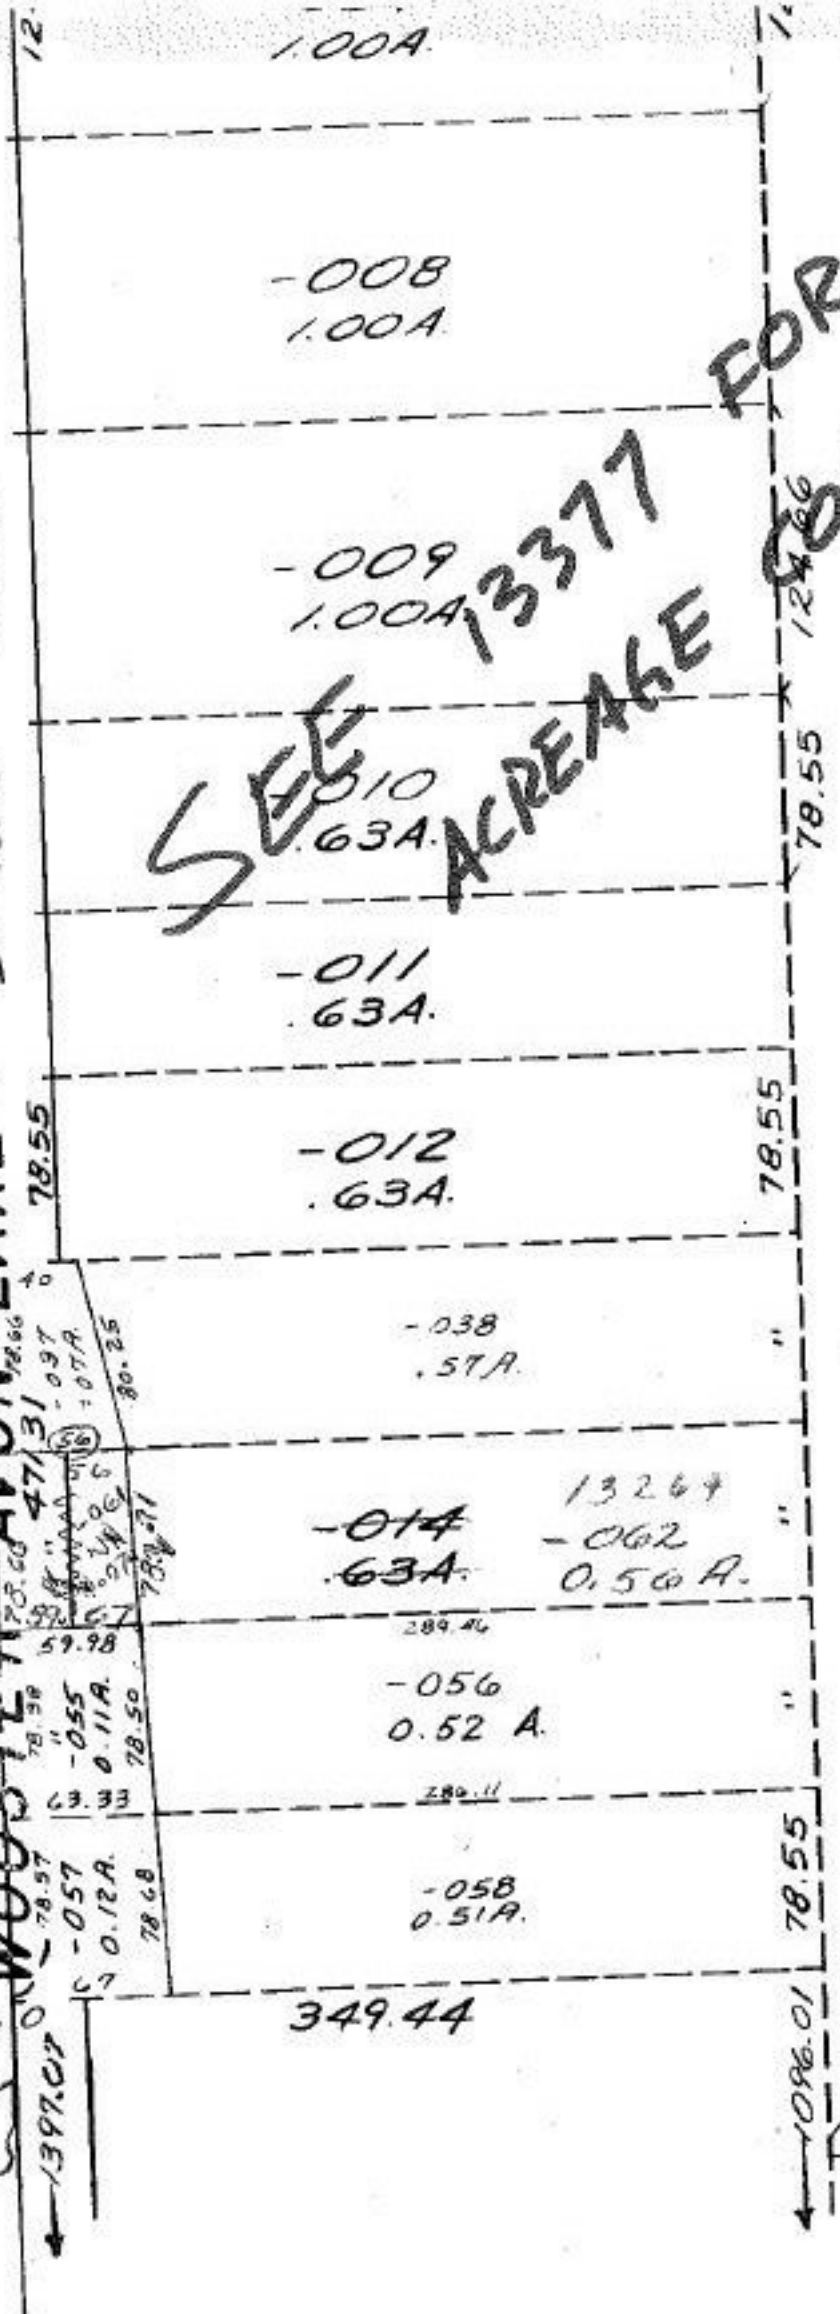

SEE ACREAGE FOR
3377 CORR.

#13264

T.M.
5-30-80

#13264

APPROVED
LORAIN CO.
MAP DEPT.
DATE 11-30-79
PAGE 7 of 24-A
BY Carolyn H
VOID AFTER

-046
Pt 4.08

1096.01
3062.93
3061.74-D.

2403.1

196.98 108.20

Pt 4.08