


GIFFORD

700

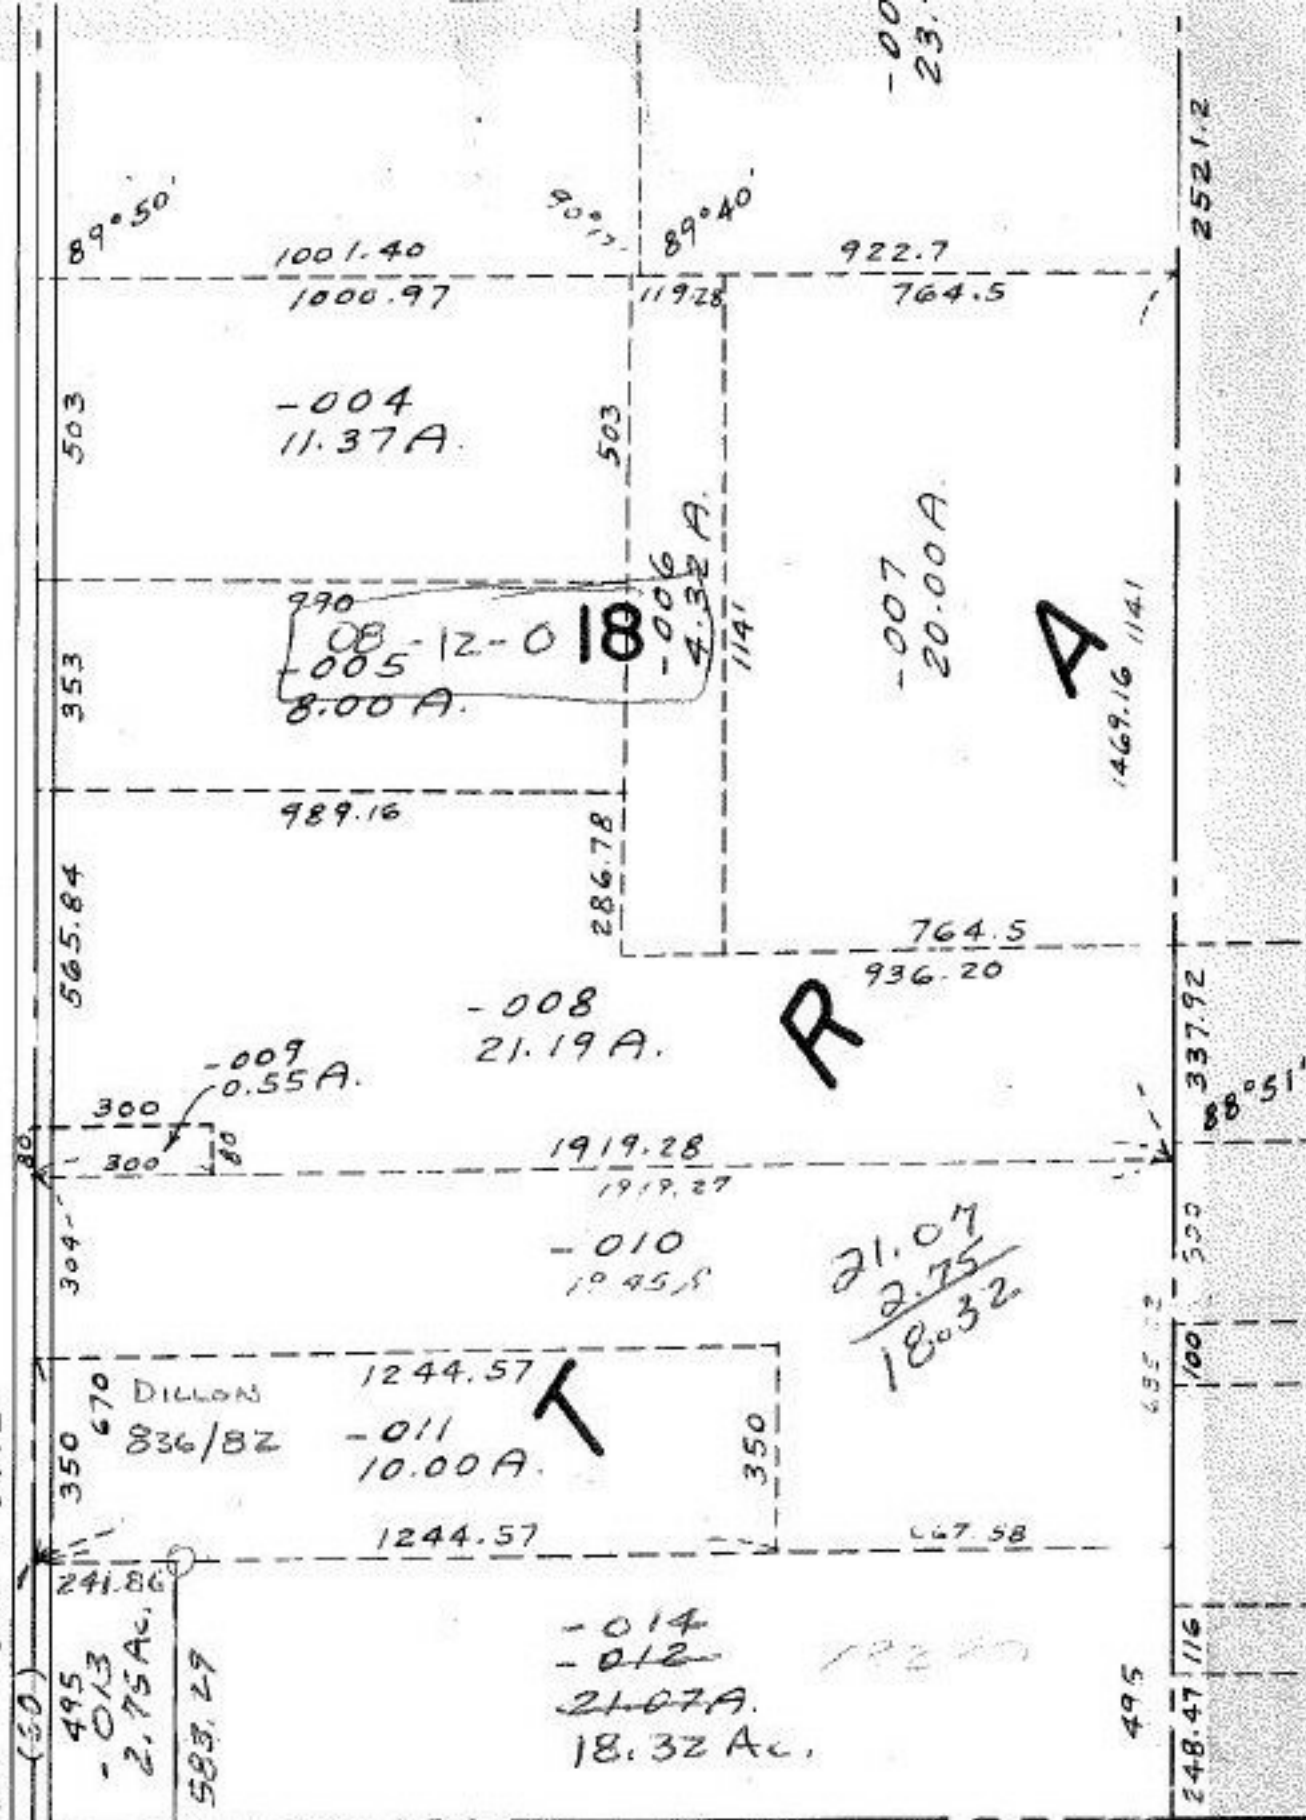

#13280

FEB 1 1980

[Handwritten Signature]

APPROVED.	
LORAIN CO.	
MAP DEPT.	
DATE 12-10-79	
PAGE 8-H	
BY <i>[Handwritten Signature]</i>	
VOID	
AFTER	