

#13283

10

#13283



APPROVED
 FEB 1 1980
 12-17-79
 03-00-017-B+A
 Carolyn
 VOID
 AFTER 13283

Pt. -020
Pt. 11.68A.

-006
3.41A.



SEE 3-00-017-A

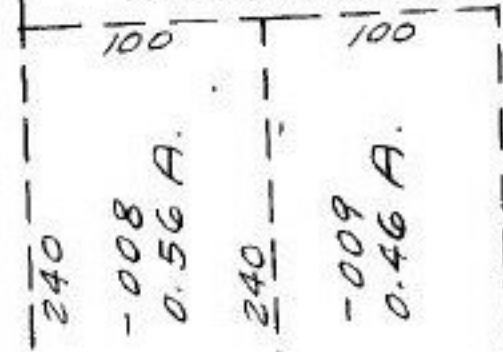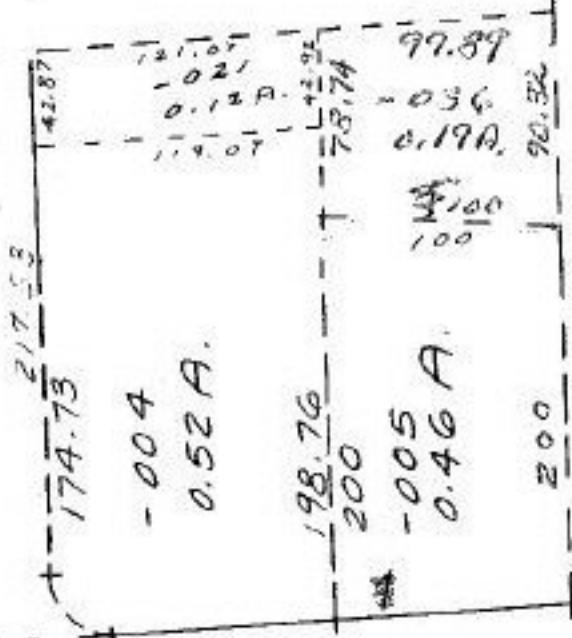

RIDGEVILLE - LORAIN

611

