

#13287

#13287

APPROVED  
LORAIN CO.  
MAP DEPT.

FEB 1979  
*[Signature]*

DATE 12-14-79

PAGE 5-00-014-B


d-A

BY T. M. Mail

VOID  
AFTER

AGREEMENT CORRECTION -035  
COMBINATION -033 & -013

SEE 5-00-015-A

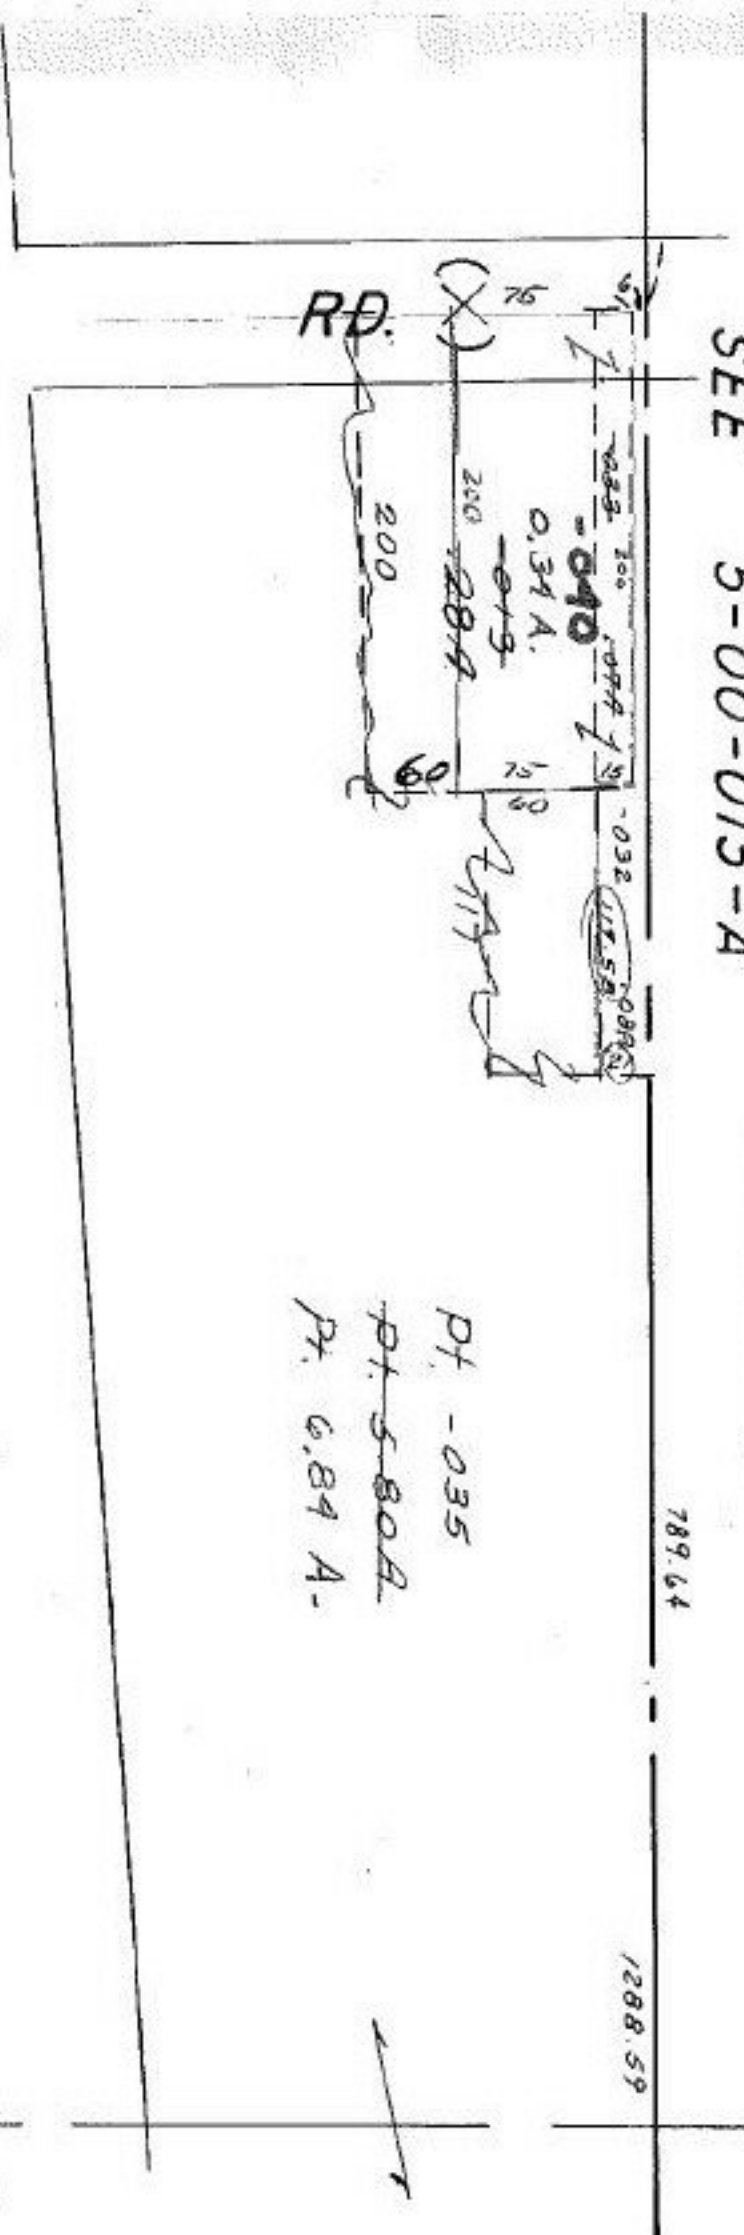

0.34 A.

0.32

117.58

0.08

0.08