


#13322

ANNEX
COMM
65

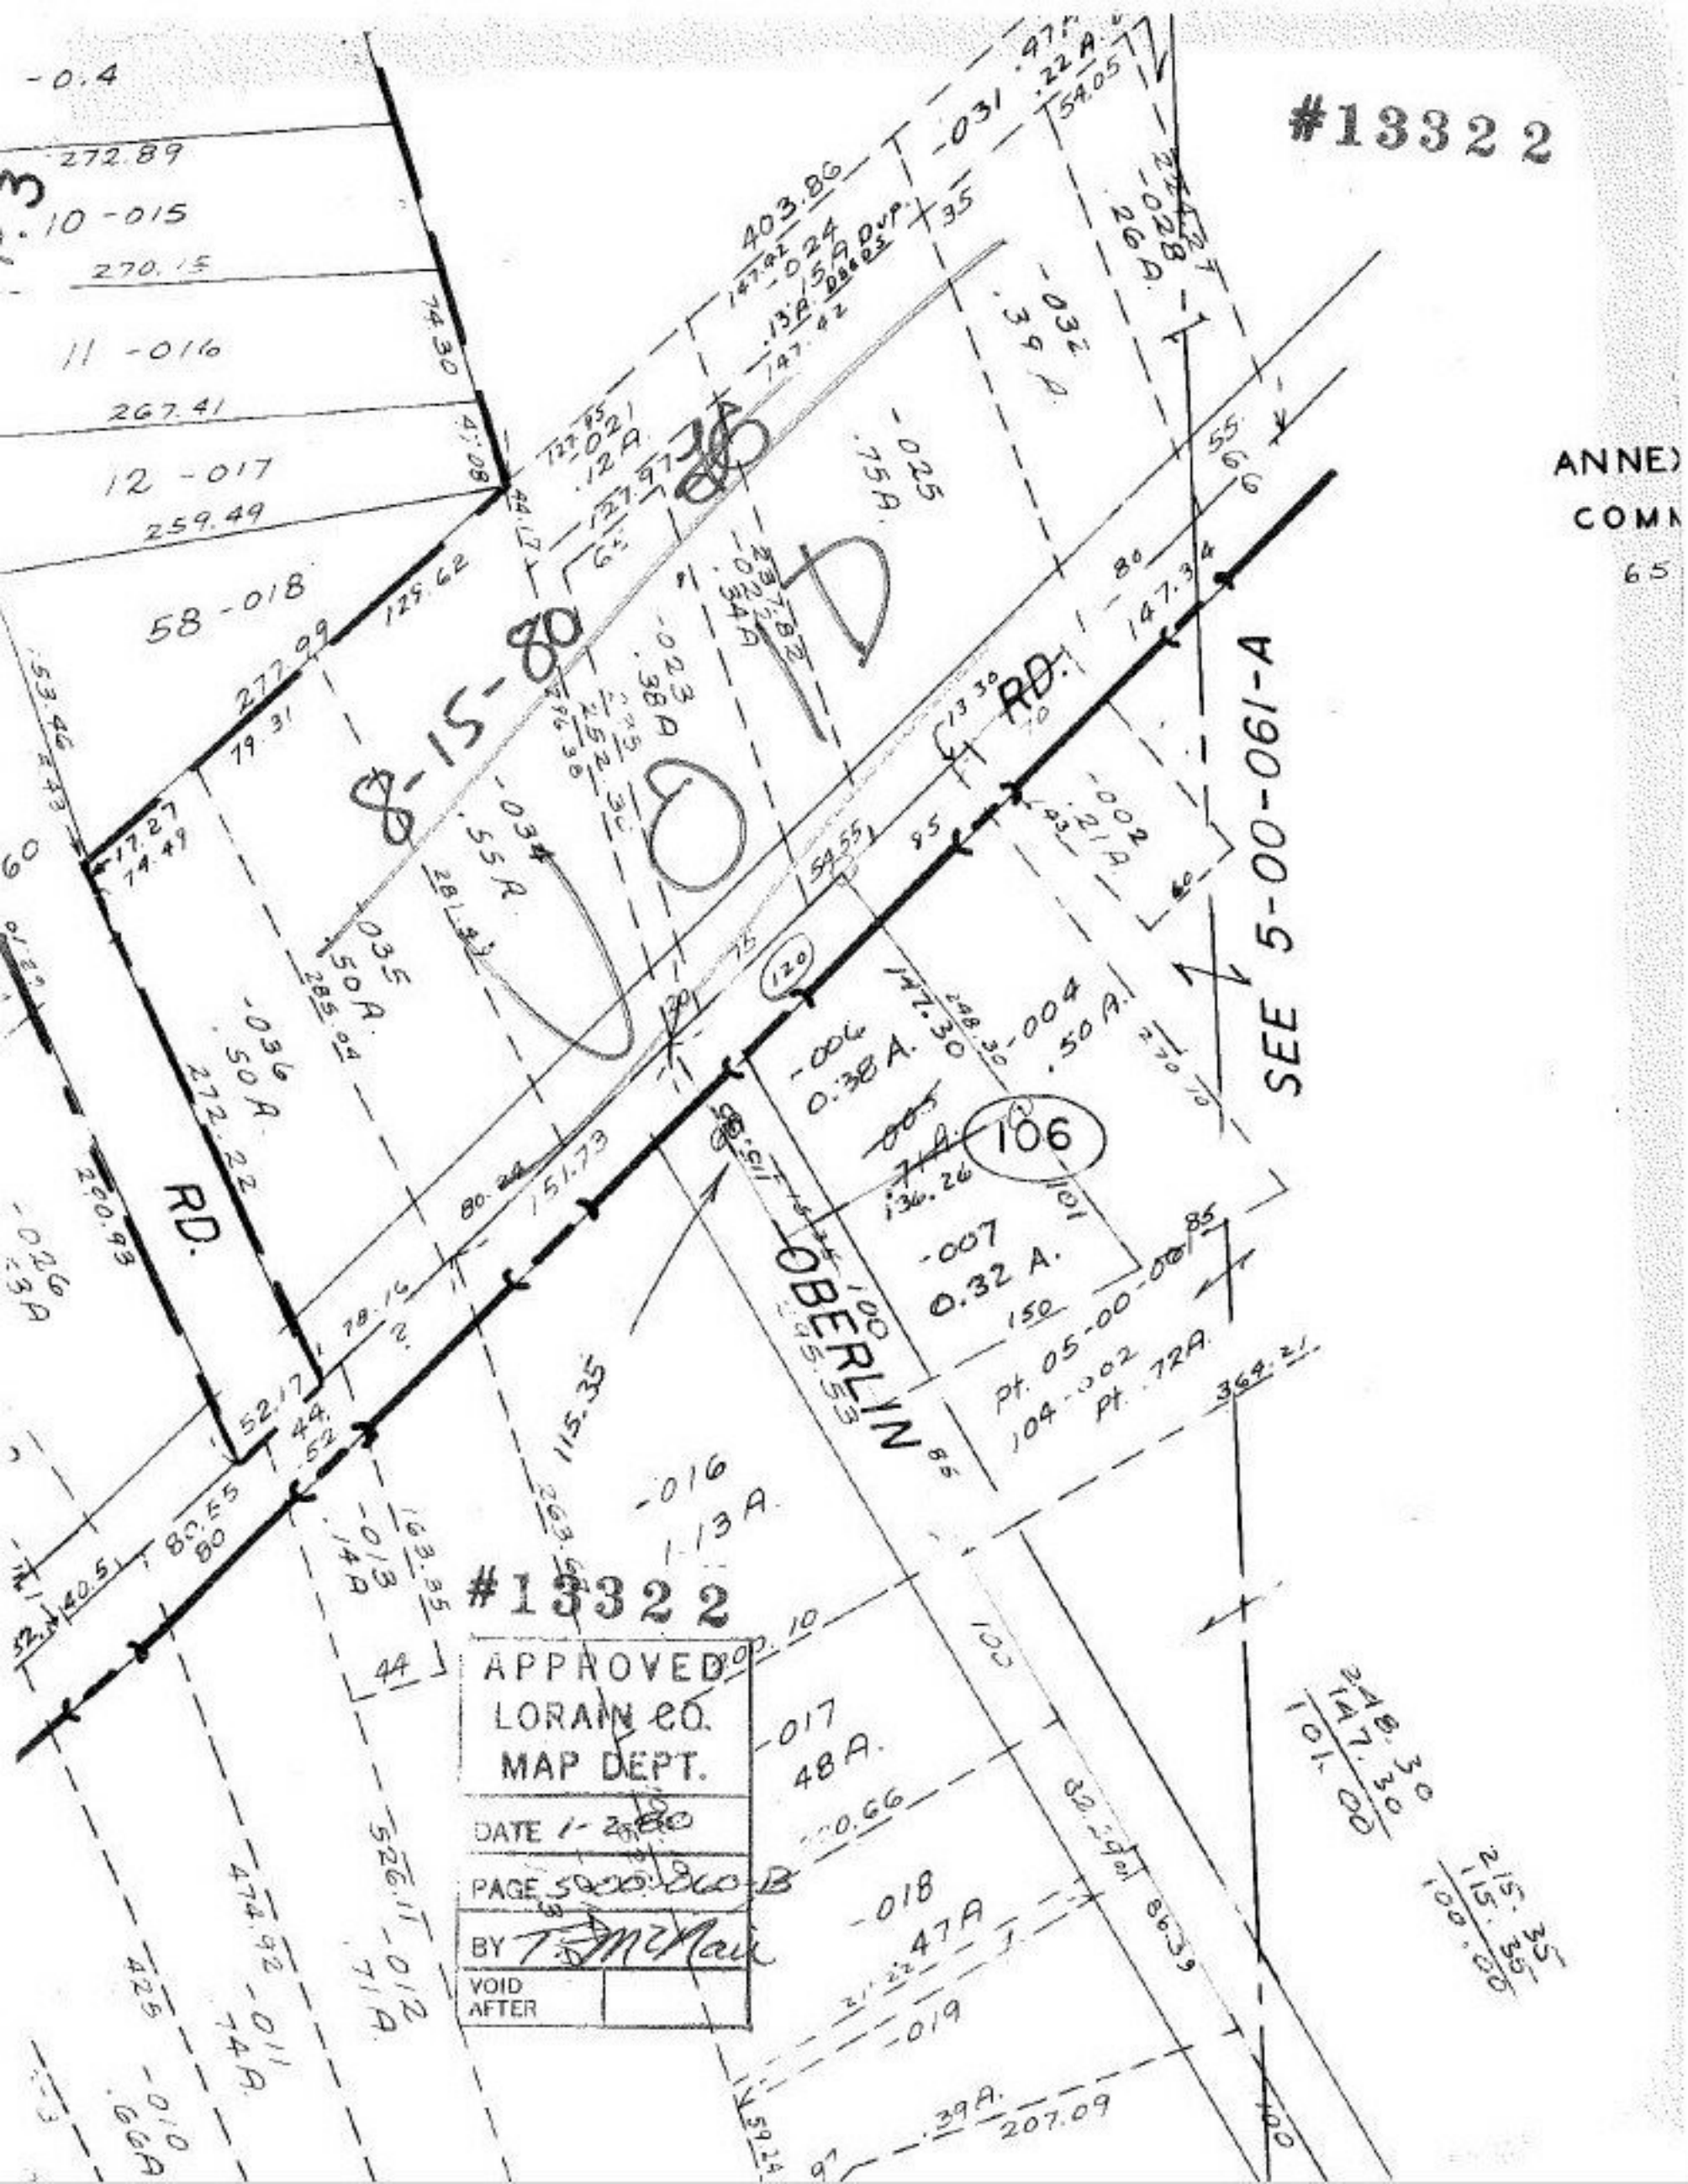

8-15-80

SEE 5-00-061-A

OBERLIN

#13322

APPROVED
LORAIN CO.
MAP DEPT.

DATE 1-2-80

PAGE 5000-200-B

BY T. M. [Signature]

VOID
AFTER

$\frac{248.30}{101.10}$
 $\frac{215.35}{100.00}$