

MEADOW

12. FEET

76.50	17	76.50
18		
18		
19		
20		
21		
76.50		


689.21

SEE 10/17/07-00-008-A

136.01  
114.0  
110.0  
8A.03

#13335  
#13336  
-046  
6.44 R.  
T.M.  
5.29.80

APPROVED
LORAIN CO.
MAP DEPT.
DATE 1-10-80
PAGE 7-00-008-C
BY <i>[Signature]</i>
VOID AFTER

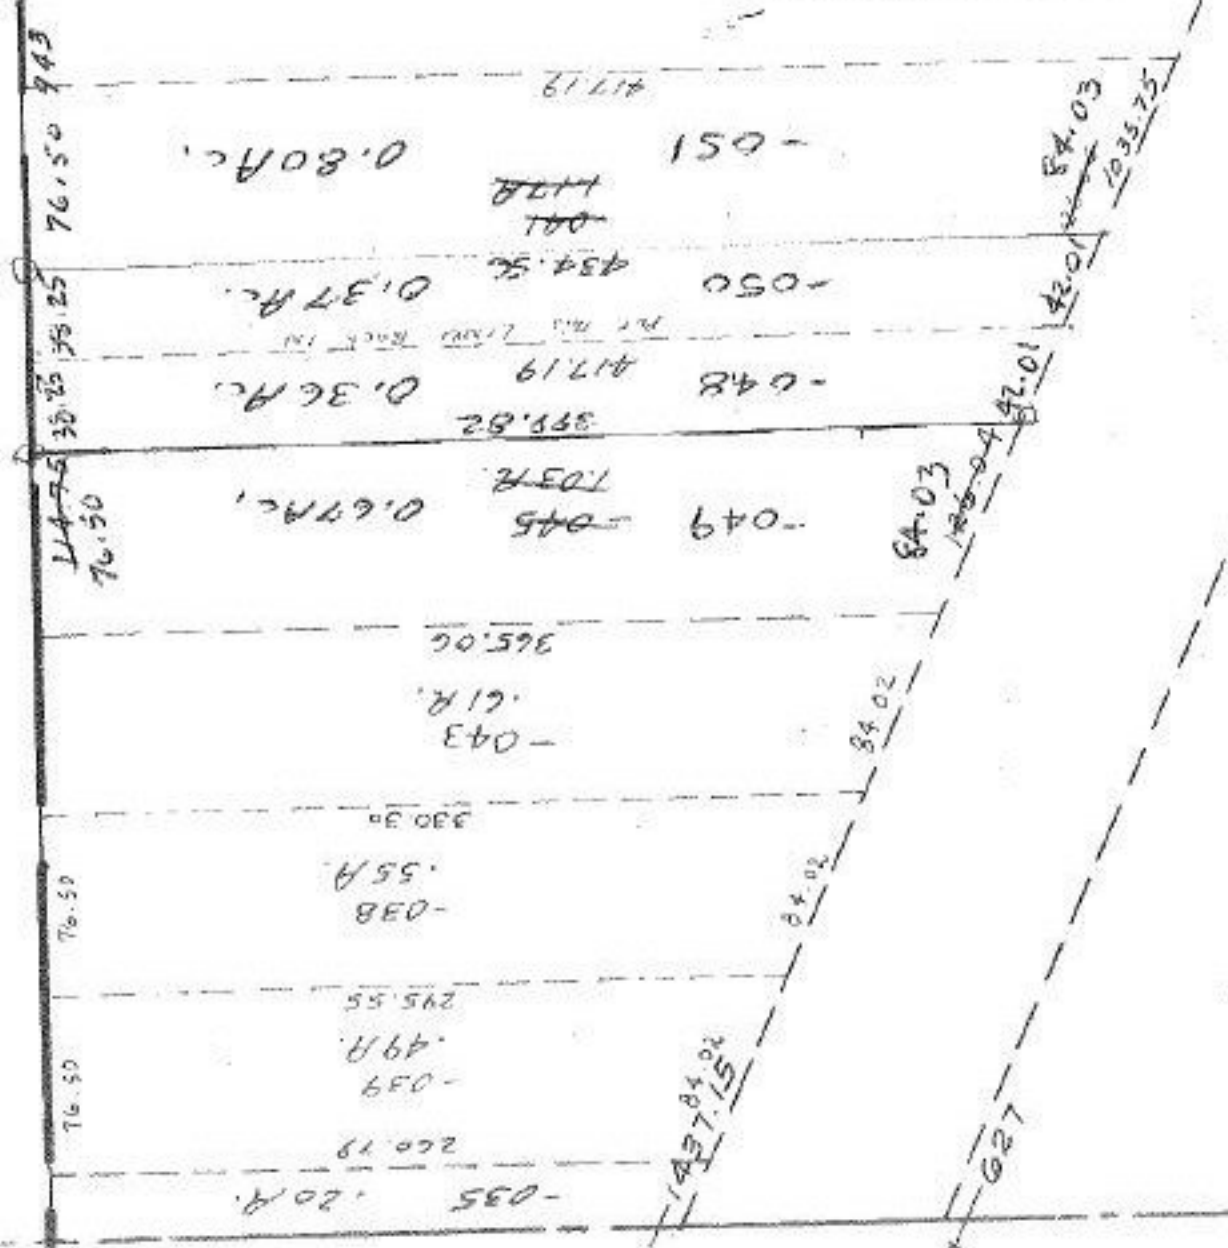

Px 07.00-008-115-008  
Px 6.25  
036.27  
219.60  
174  
117.7  
213.7