


COUNTY

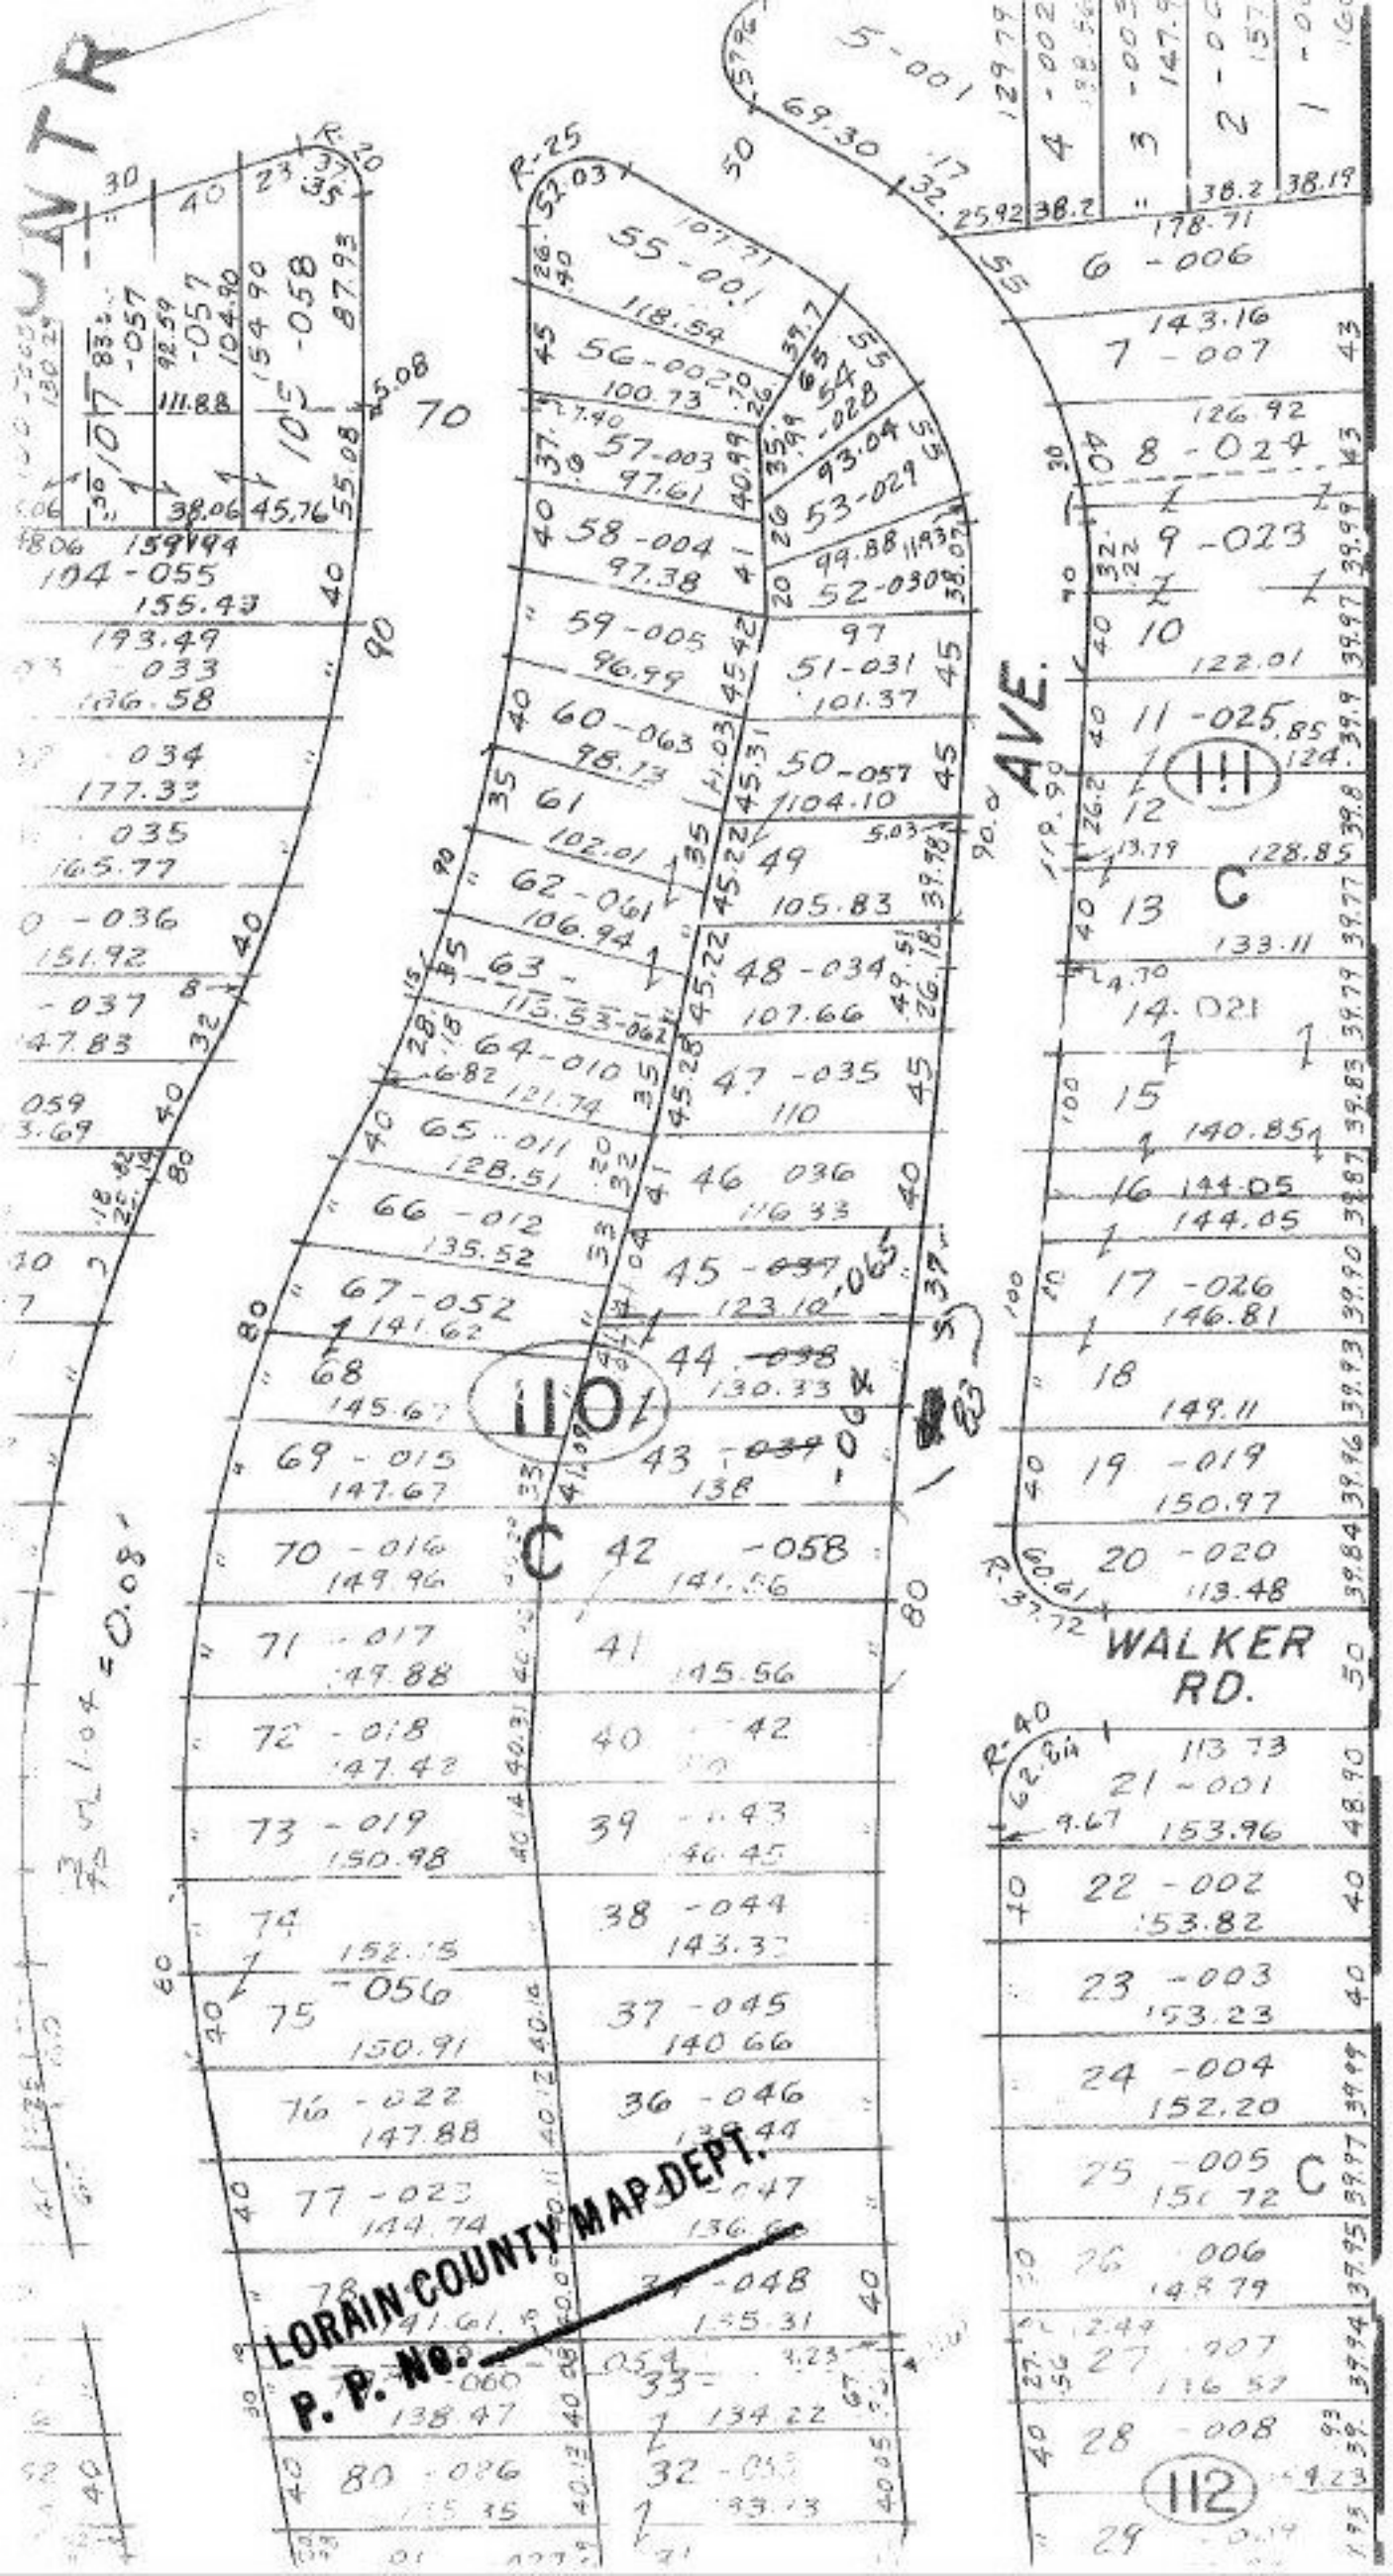

#13349
 APPROVED
 LORAIN CO.
 MAP DEPT.
 DATE 1-16-80
 PAGE 3-00-035
 BY *[Signature]*
 VOID AFTER

T.M.
 5.22-80

LORAIN COUNTY MAP DEPT.
 P. P. No.