

#13361

SEE 9-00

875.82
925t

-0.10
1.50

4.58 TO
19-00 095-500-001
8.51 A

R. R.

#13361

APPROVED
LORAIN CO.
MAP DEPT.

DATE 1-24-80

PAGE 9-00-094-B

BY T. McRae

VOID AFTER

T.M.
5.1.80


-0.27
0.75 A.

95
~~0.21~~
0.75 A.

M U D N.
93

-0.09 42
1.00 F.

-0.24
1.08 A

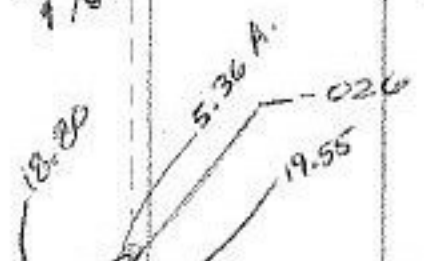

92
P 9

VOID
50

ST.

103 62
201 29
320
68 89

37.65
37.21
57.96

2 ND.
160.24
0.03

178.39
151.16

-0.12
0.51 A.

-0.06
26 F.
202.1
205

228
214.50

-0.02

121.06
90.30 90.30 59.68

-0.07

564.96

T'S
178.41

V 3

103

0.9

679.80