

#13373

1004  
3.19A


148  
149  
157

#13373

|                 |
|-----------------|
| APPROVED        |
| LORAIN CO.      |
| MAP DEPT.       |
| DATE 1-30-80    |
| PAGE 50 OF 99-C |
| BY T. McMan     |
| VOID AFTER      |

T.M.  
5-27-80

-078 A.  
2.02 A.

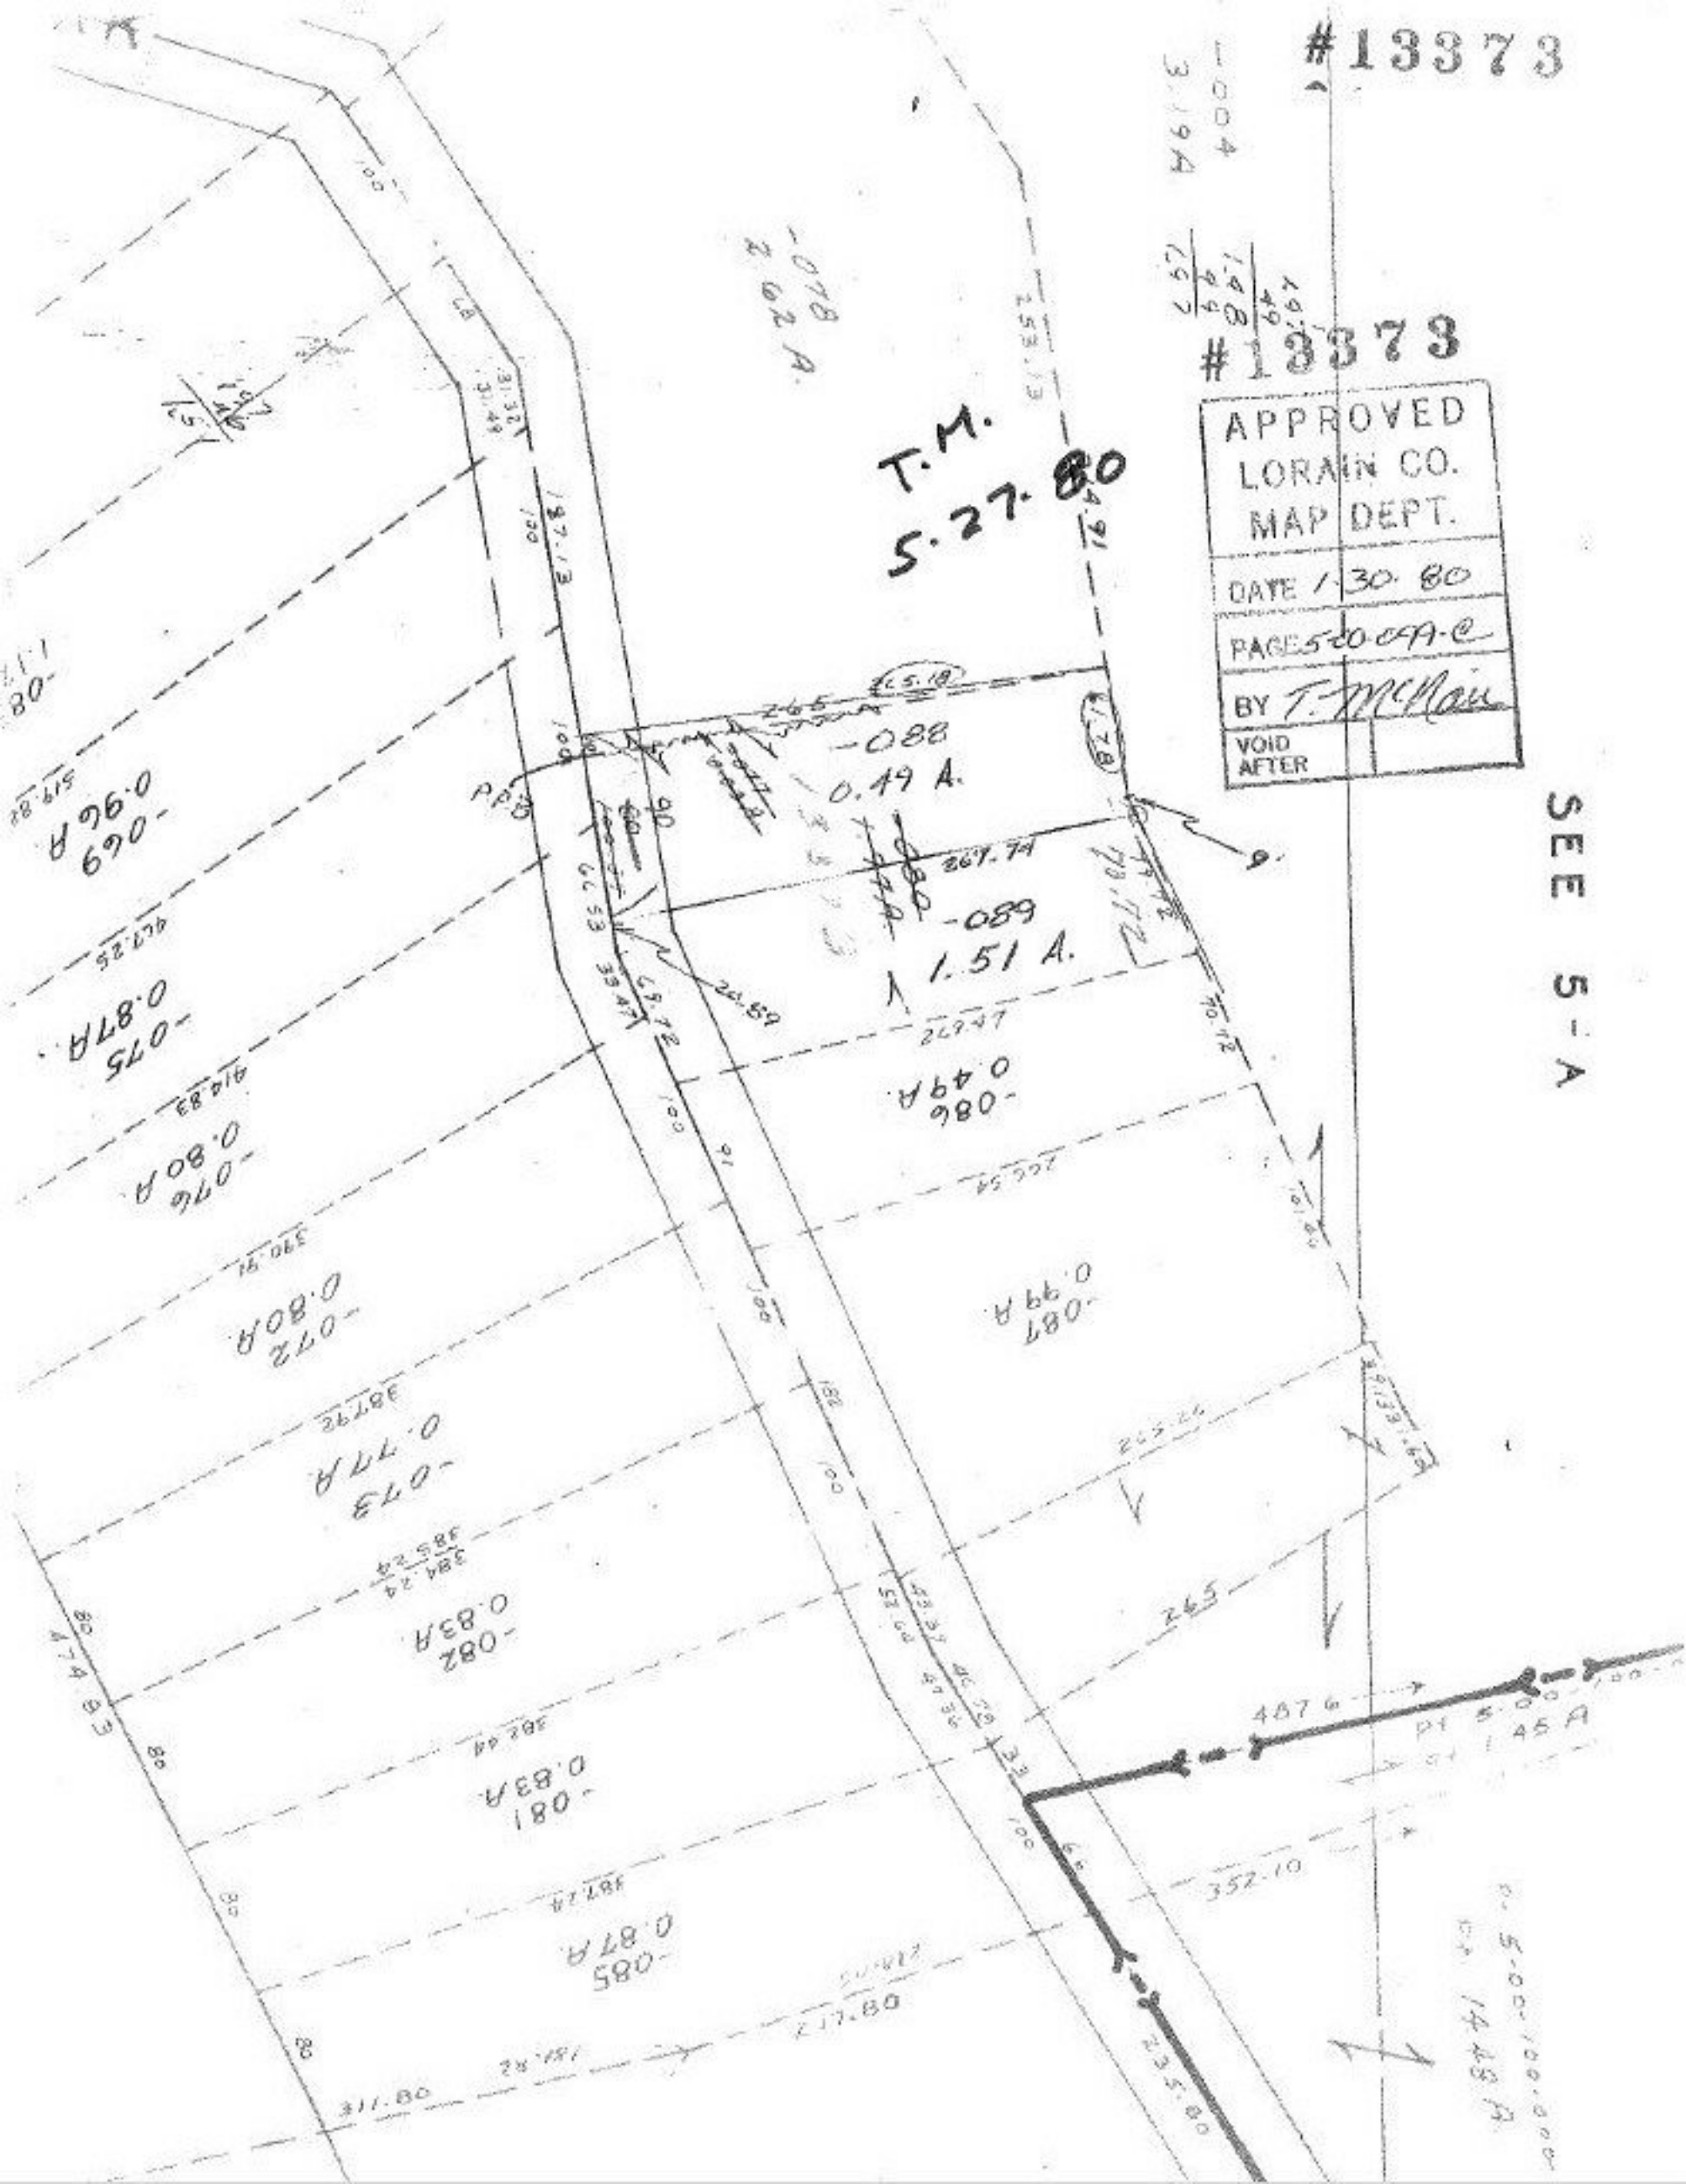

SEE 5-A

0-5-00-100-000  
0-1448 A.