


07-00-017-112-030
100 X 133

07-00-018-103-079
64 X 133

07-00-018-103-075
76 X 133

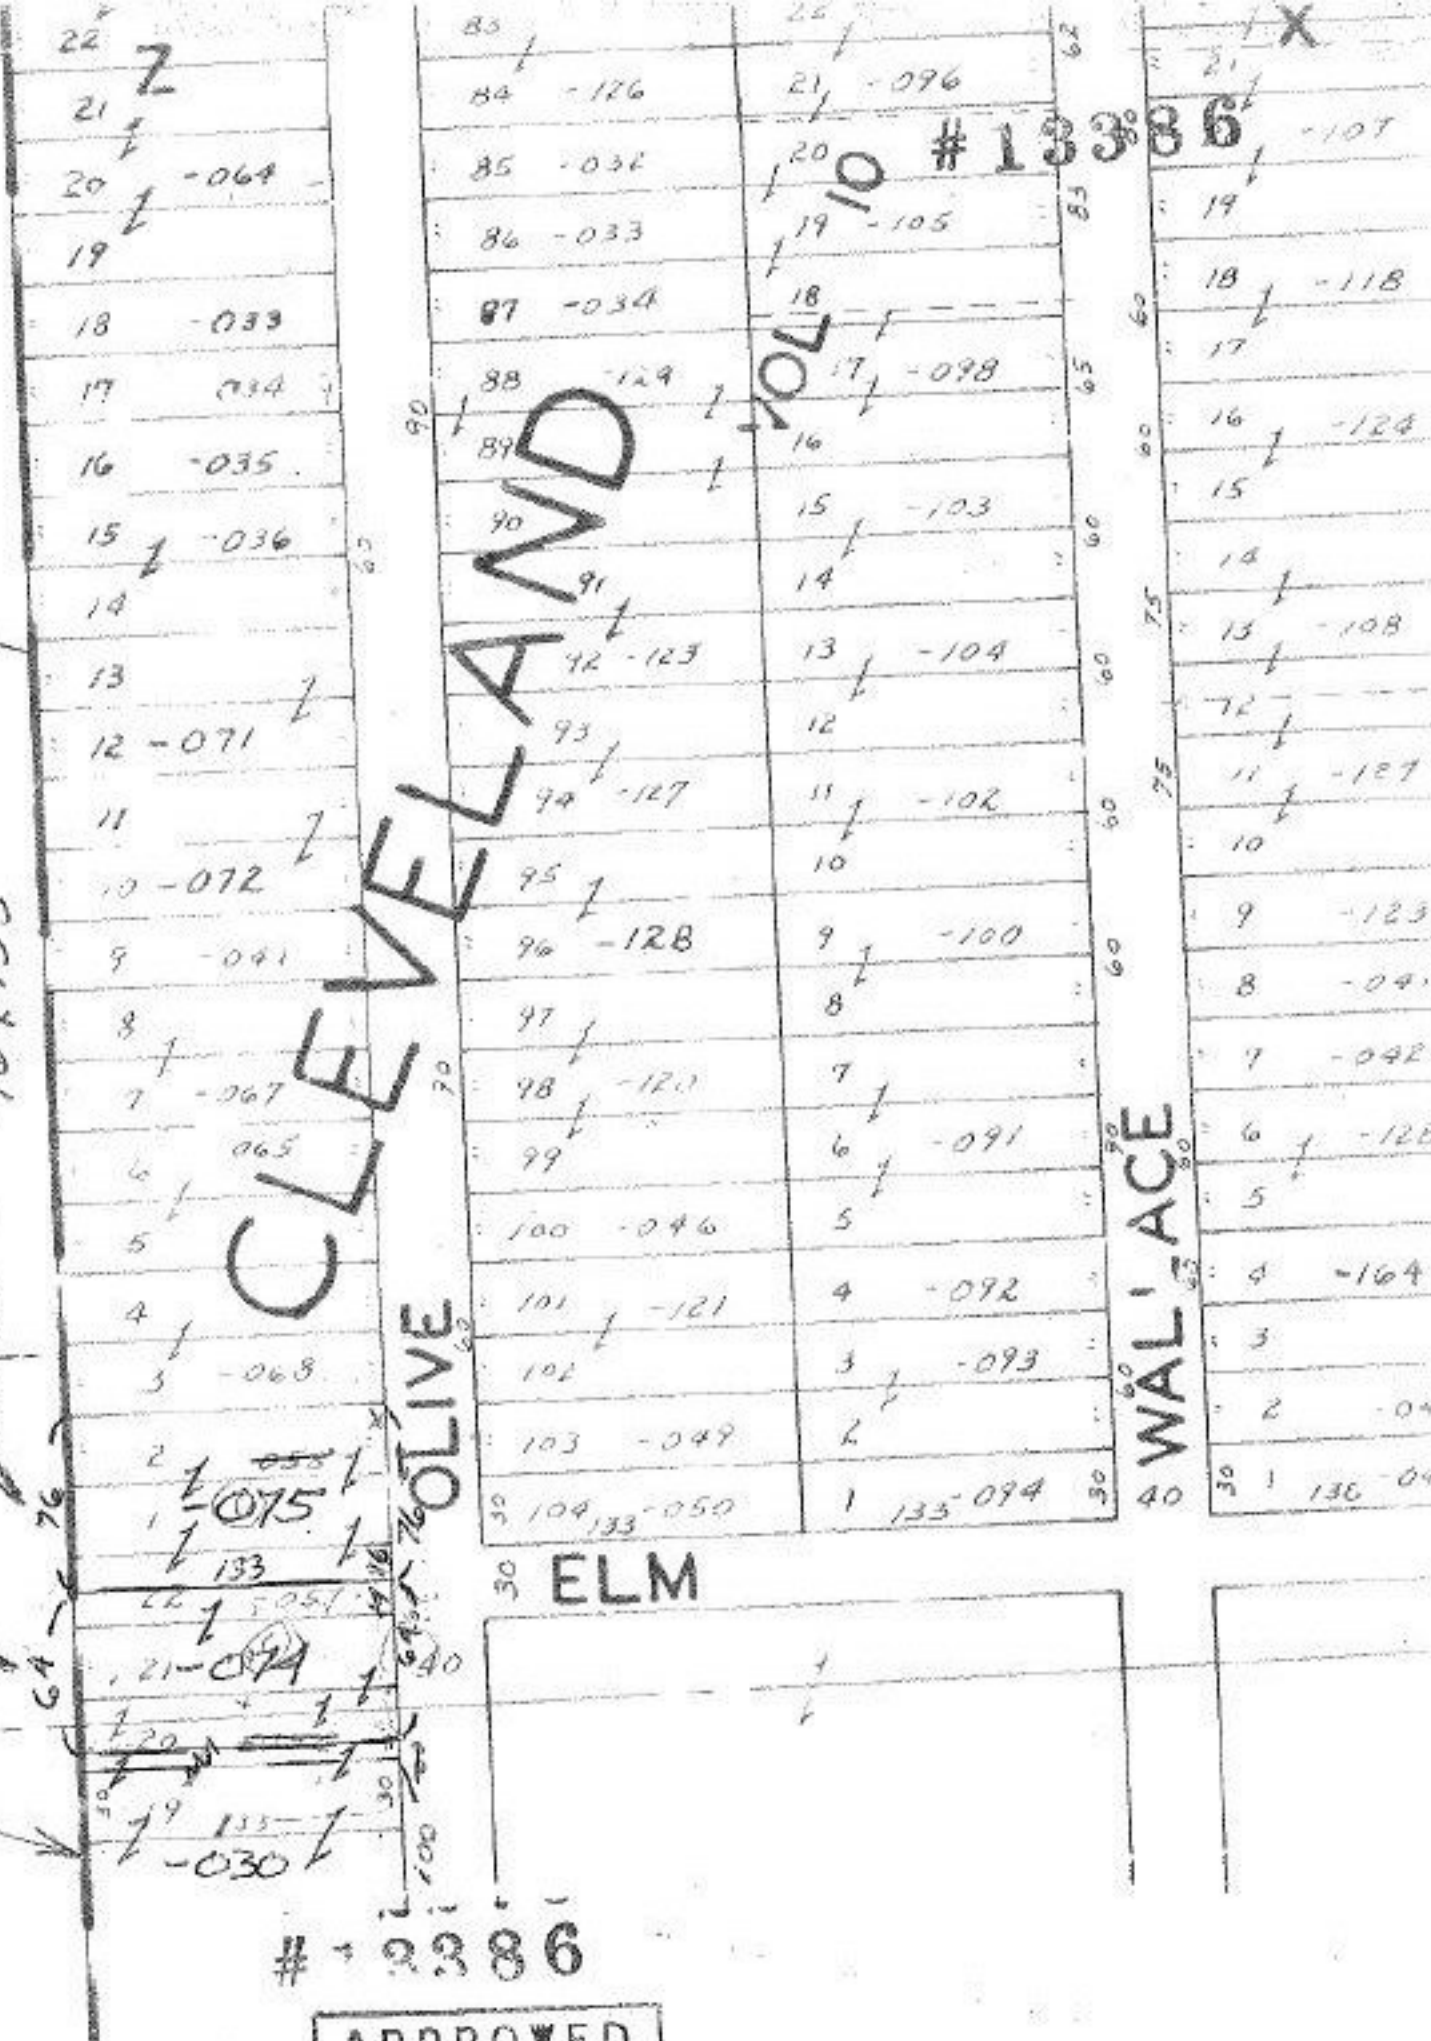

T.M.
5-30-80

APPROVED
LORAIN CO.
MAP DEPT.
DATE 2-20-80
PAGE 7-00-018-D
BY T.M. [Signature]
VOID AFTER

RIDGEV
SCALE 1" = 100'