


Pt. 07-00-015-110-051
Pt. 30.31 A.

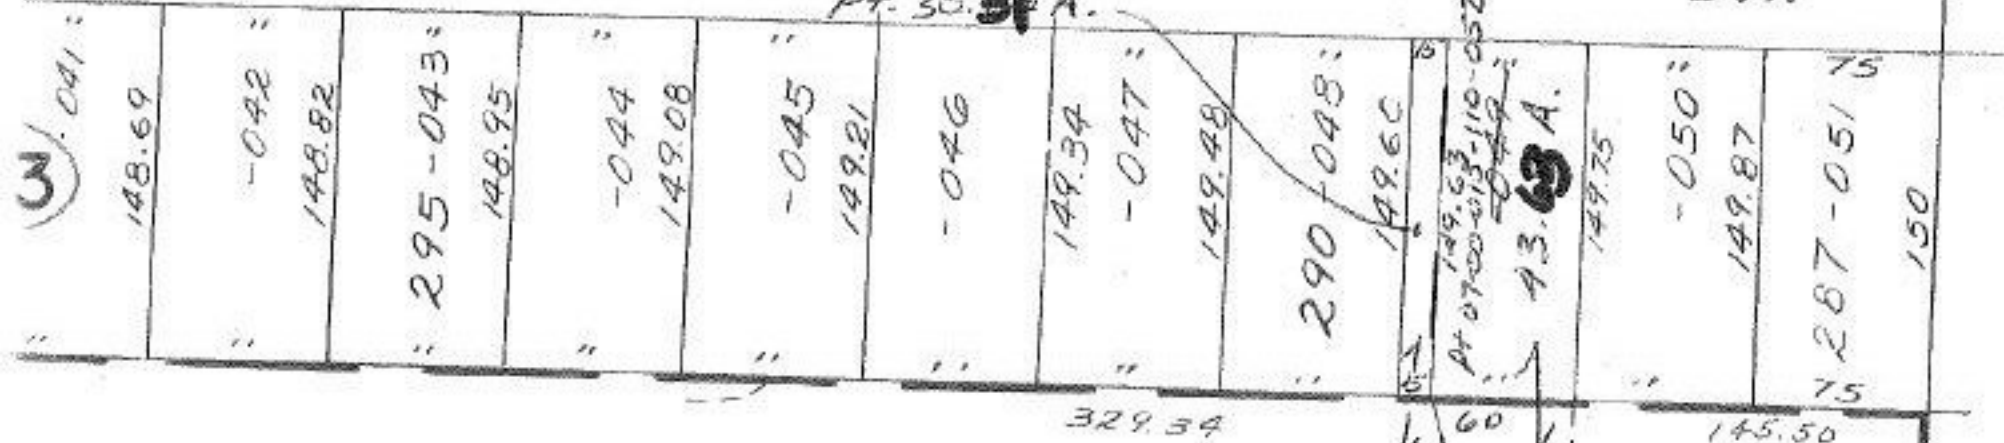

#133 93

APPROVED	
LORAIN CO.	
MAP DEPT.	
DATE 2-6-80	
PAGE 7-00-015-B	
BY T. M. Hain	
VOID	
AFTER	

T.M.
5-29-80

Pt. 07-00-015-110-051

Pt. 30.31 A

~~042~~
~~24.60A~~

-040
2.16 A.

~~978.94~~ 510
958.94

258.82

169.85