


#13401

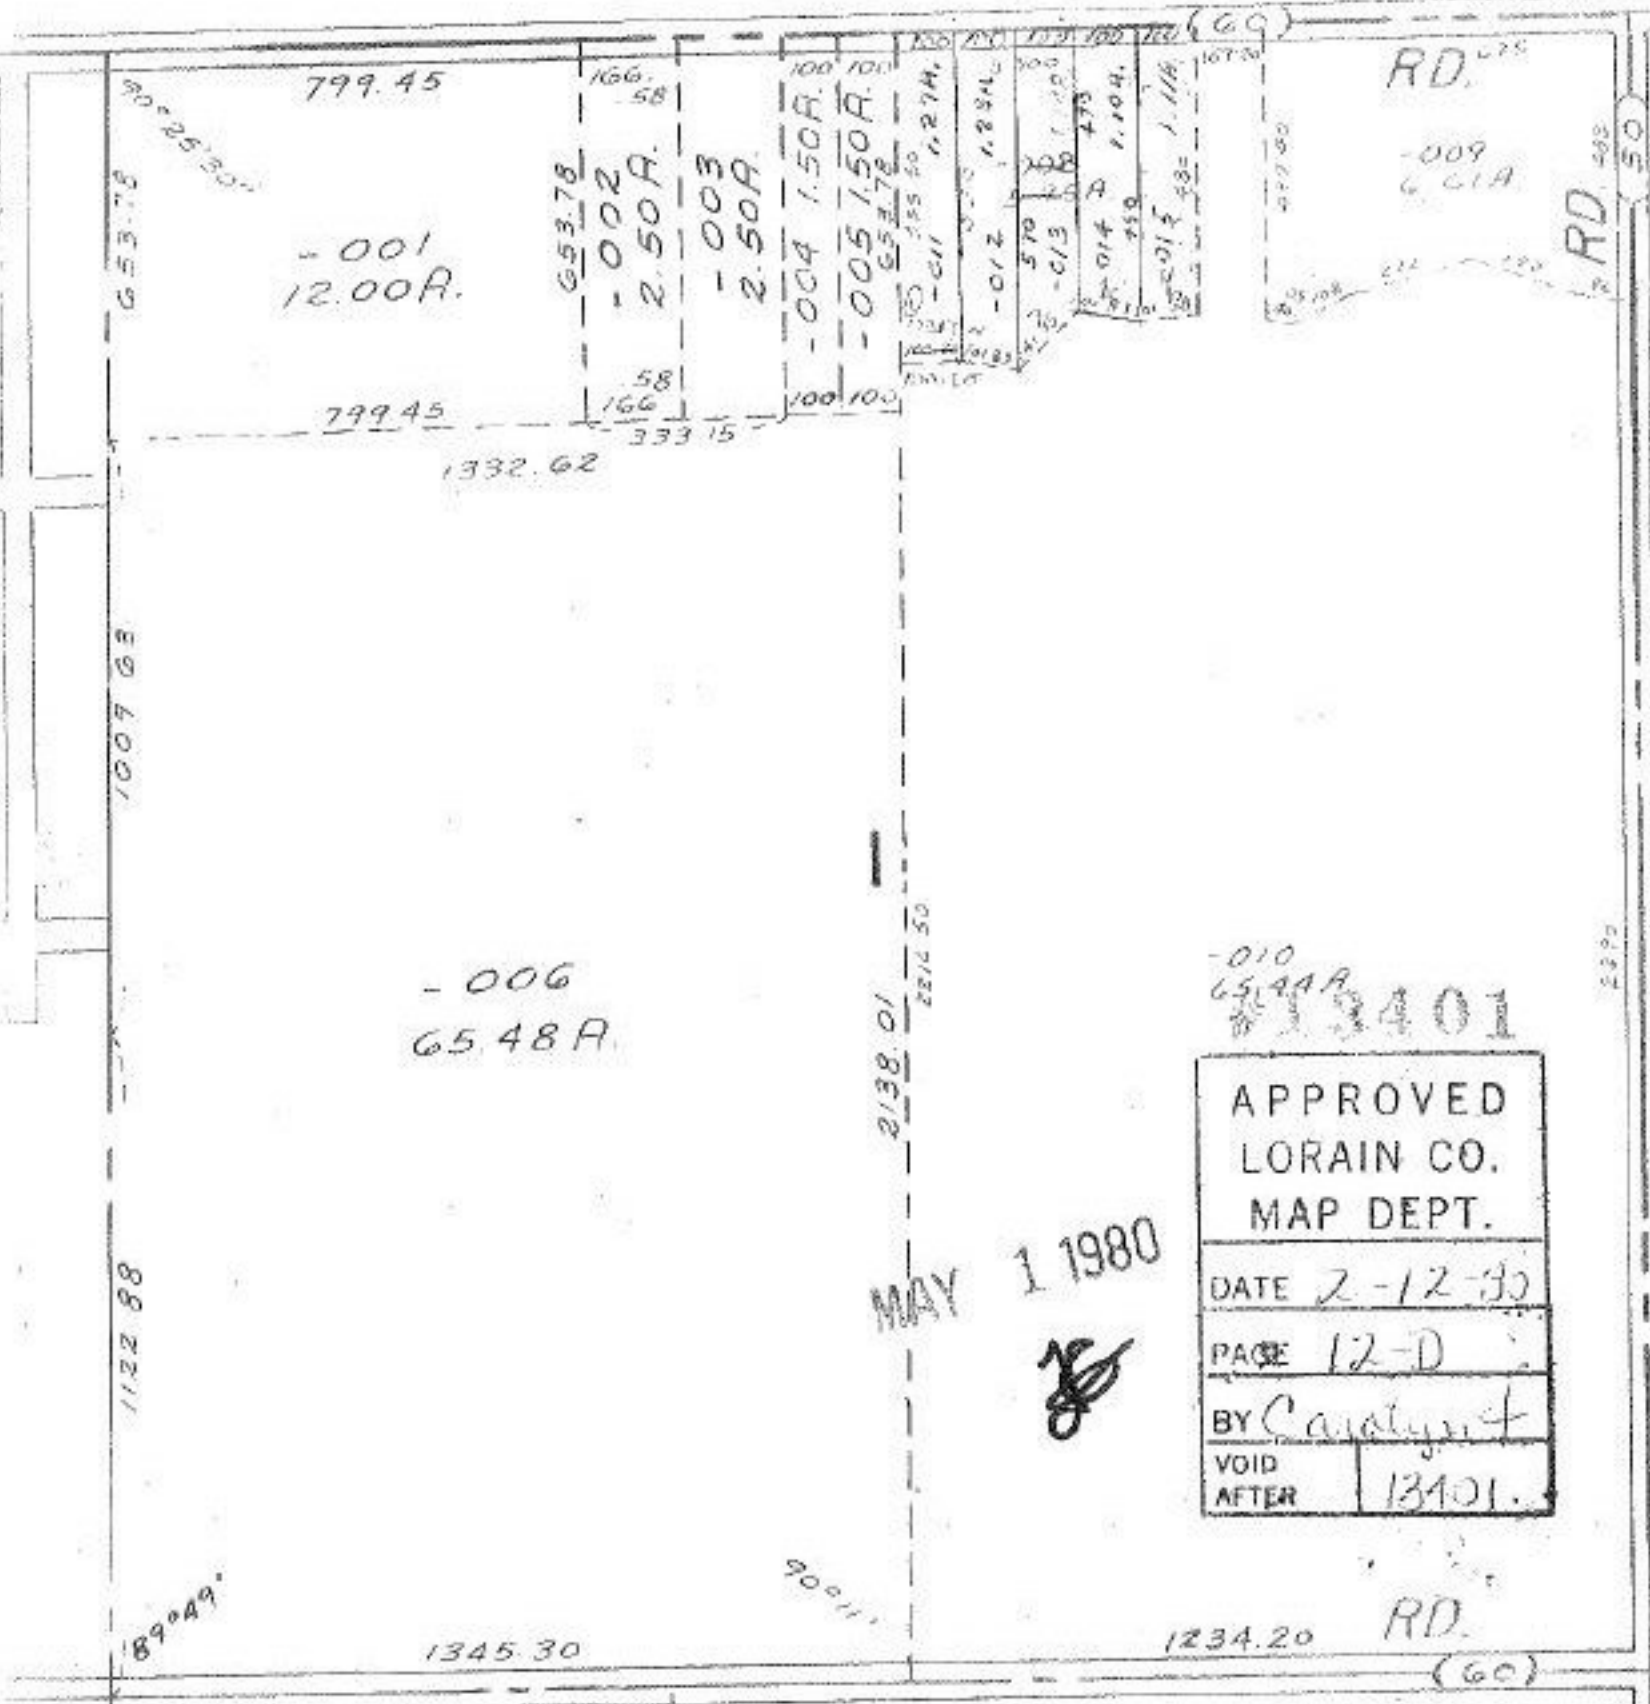

-006  
65.48A

-010  
65.48A  
#13401

APPROVED LORAIN CO. MAP DEPT.	
DATE	2-12-80
PAGE	12-D
BY	Catalyn
VOID AFTER	13401

MAY 1 1980  
*[Signature]*

*[Handwritten mark]*