


#13402

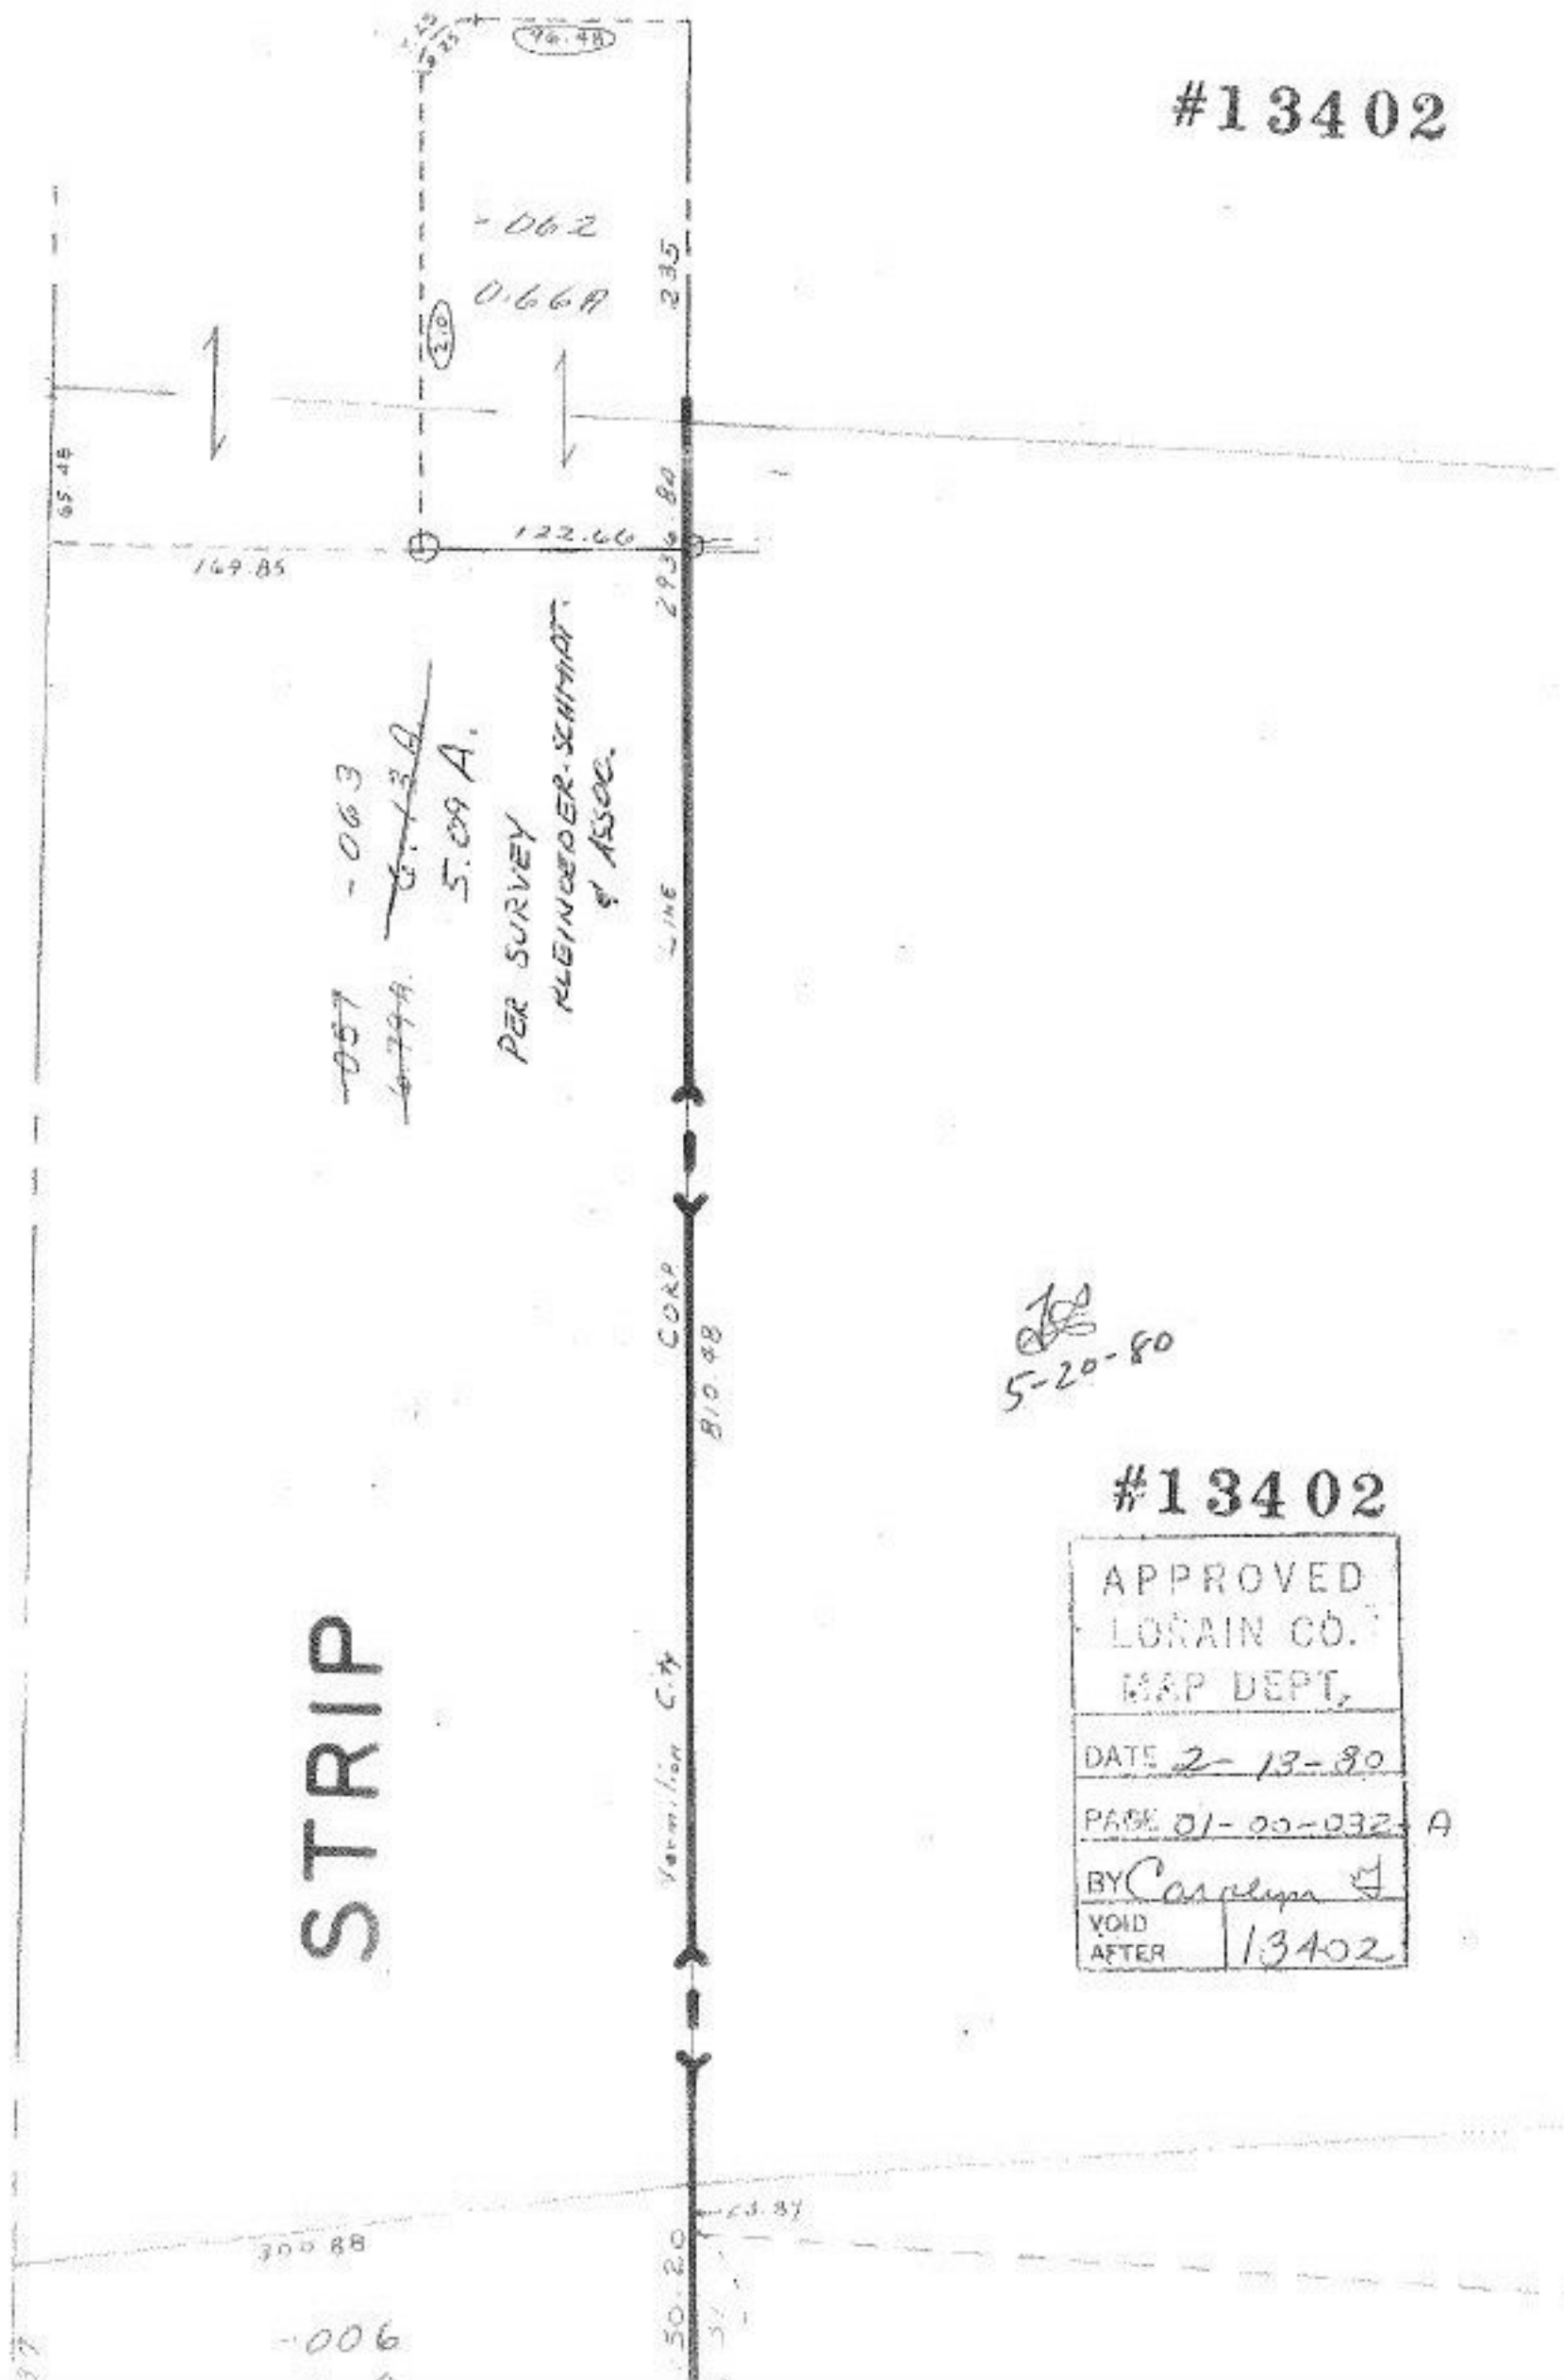

STRIP

#13402

APPROVED	
LORAIN CO.	
MAP DEPT.	
DATE	2-13-80
PAGE	01-00-032 A
BY	Caroline J
VOID AFTER	13402