


#13422

#13422

APPROVED
LORAIN CO.
MAP DEPT.
DATE 2.21.80
PAGE 7-00-015-D
BY T. McNeil
VOID AFTER

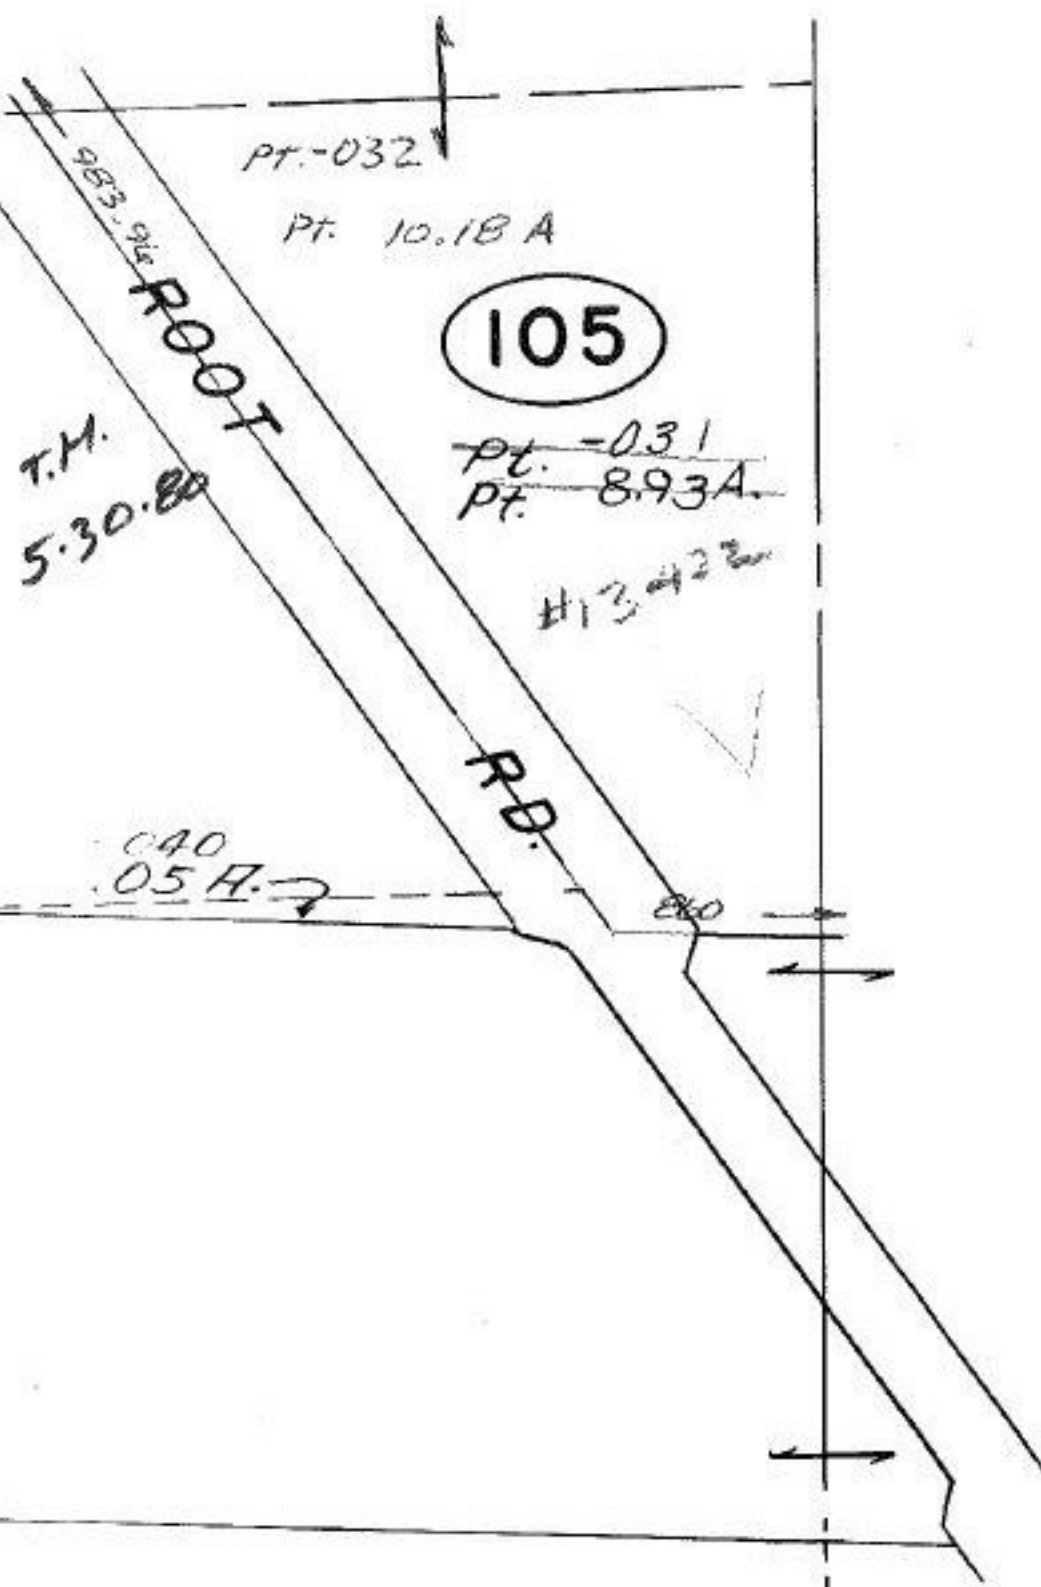

TURNPIKE

C40  
05 H.7

893  
107  
1000

1281.05

1423.96

7-00-015-C