


#13430

1-001
S U B

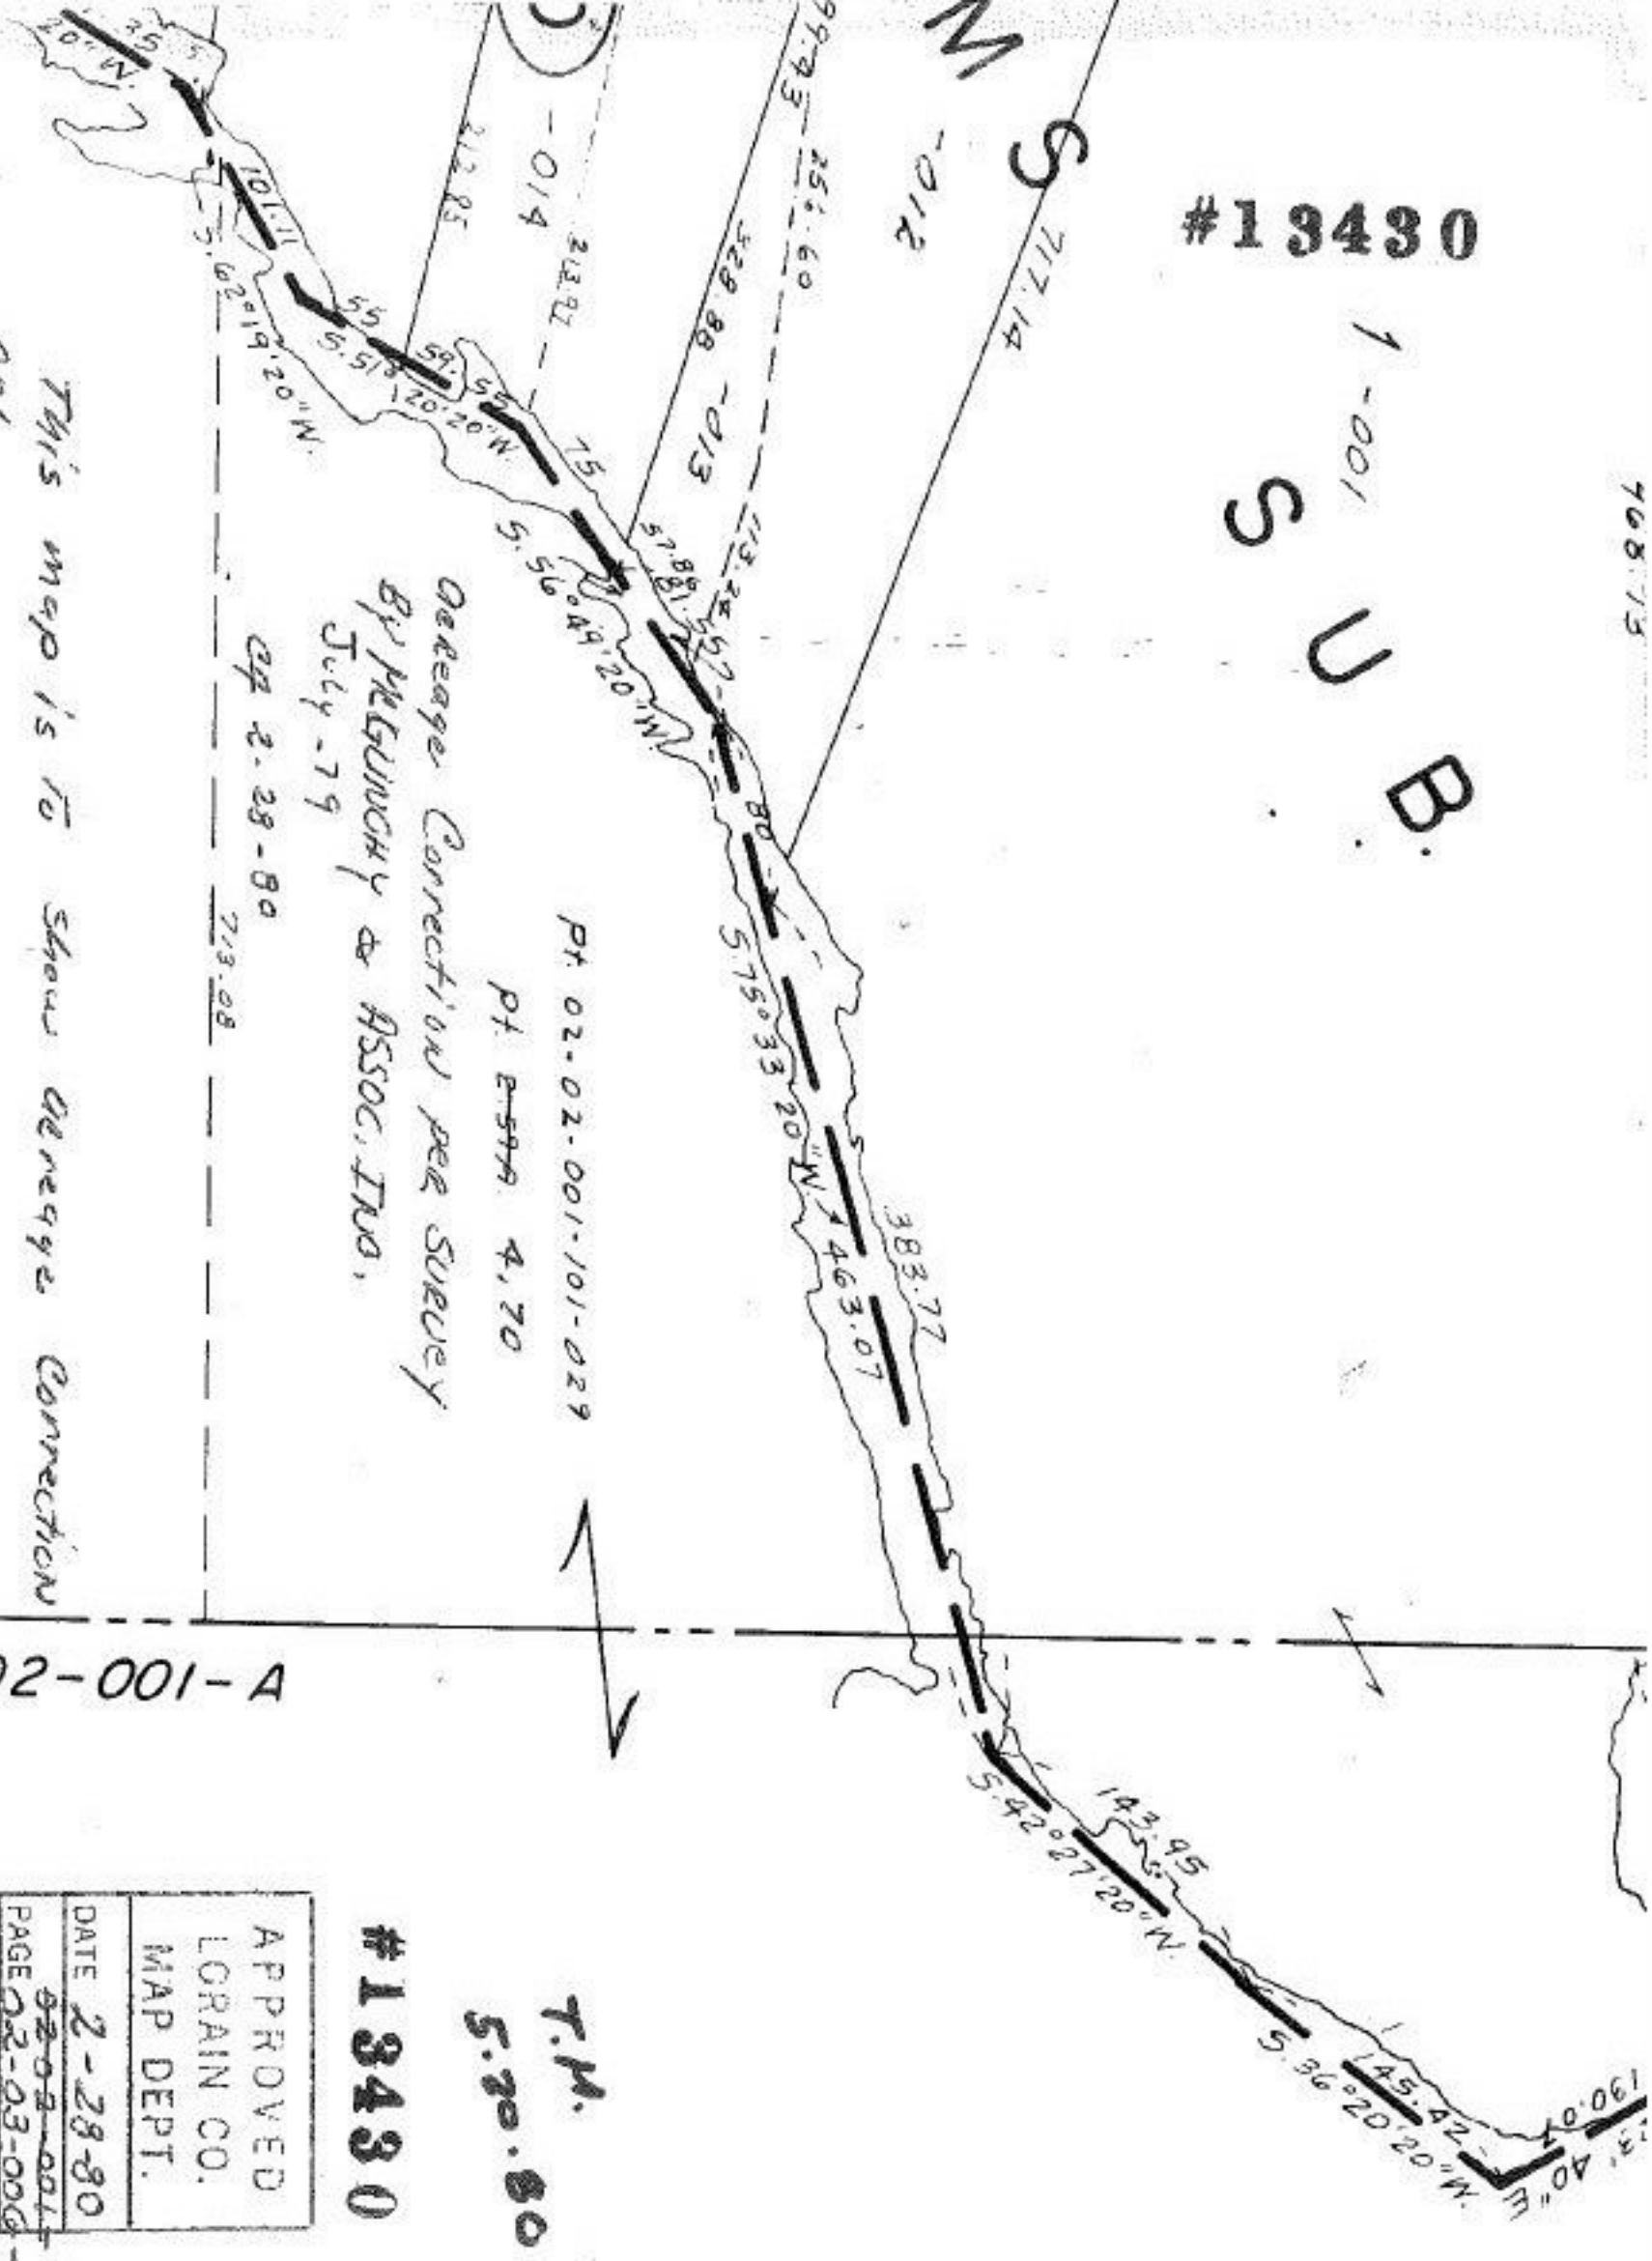

Georage Connection per Survey
 By McGINCHY & ASSOC. INC.,
 July-79

CP 2-28-80

PT 02-02-001-101-029

PT ~~2-28-80~~ 4,70

This map is to show Georage Connection
 ONLY ON Parcel No. 02-02-001-101-029
 Changing 2,59 A. To 4,70A. (2-28-80)

EE 2-02-001-A

#13430

T.M.
 5.20.80

APPROVED	
LORAIN CO.	
MAP DEPT.	
DATE	2-28-80
PAGE	02-02-001-001 5
BY	<i>Carlynn</i>
VOID AFTER	13430

111