
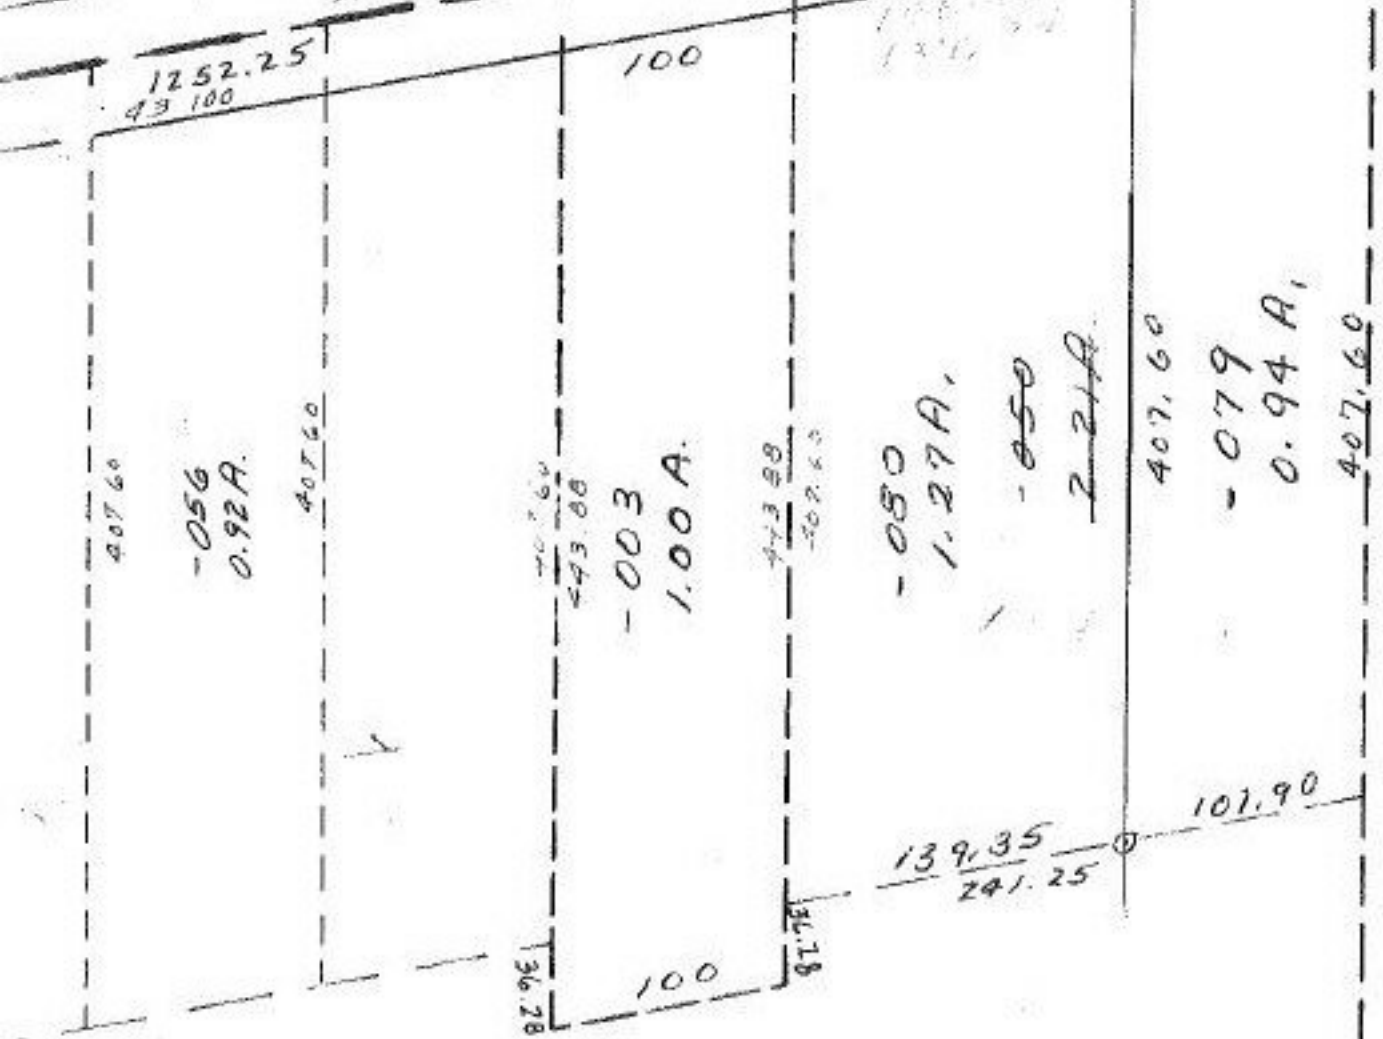


#1 3439

-105
6.70 A.

-103
4.36 A.

105

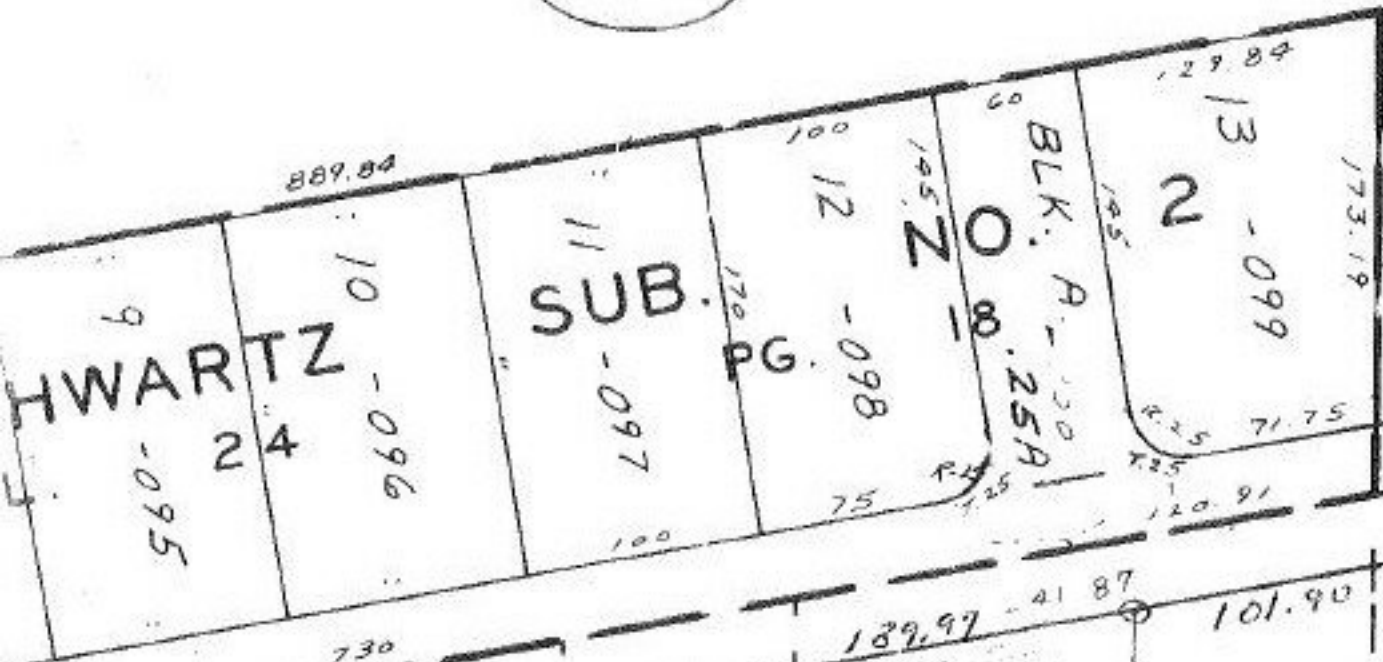

T.M.
5-22-80

-OIO JENSEN

APPROVED	
LORAIN CO.	
MAP DEPT.	
DATE	3-3-80
PAGE	04-00-023-G
BY	Carolyn [Signature]
VOID AFTER	13439

#1 3439

428.71
-006
.99 A.
448.15

407.60
-079
0.94 A,
407.60

407.60
-080
1.27 A,
-050
2.21 A.

407.60
-003
1.00 A.

407.60
-056
0.92 A.