


#13453

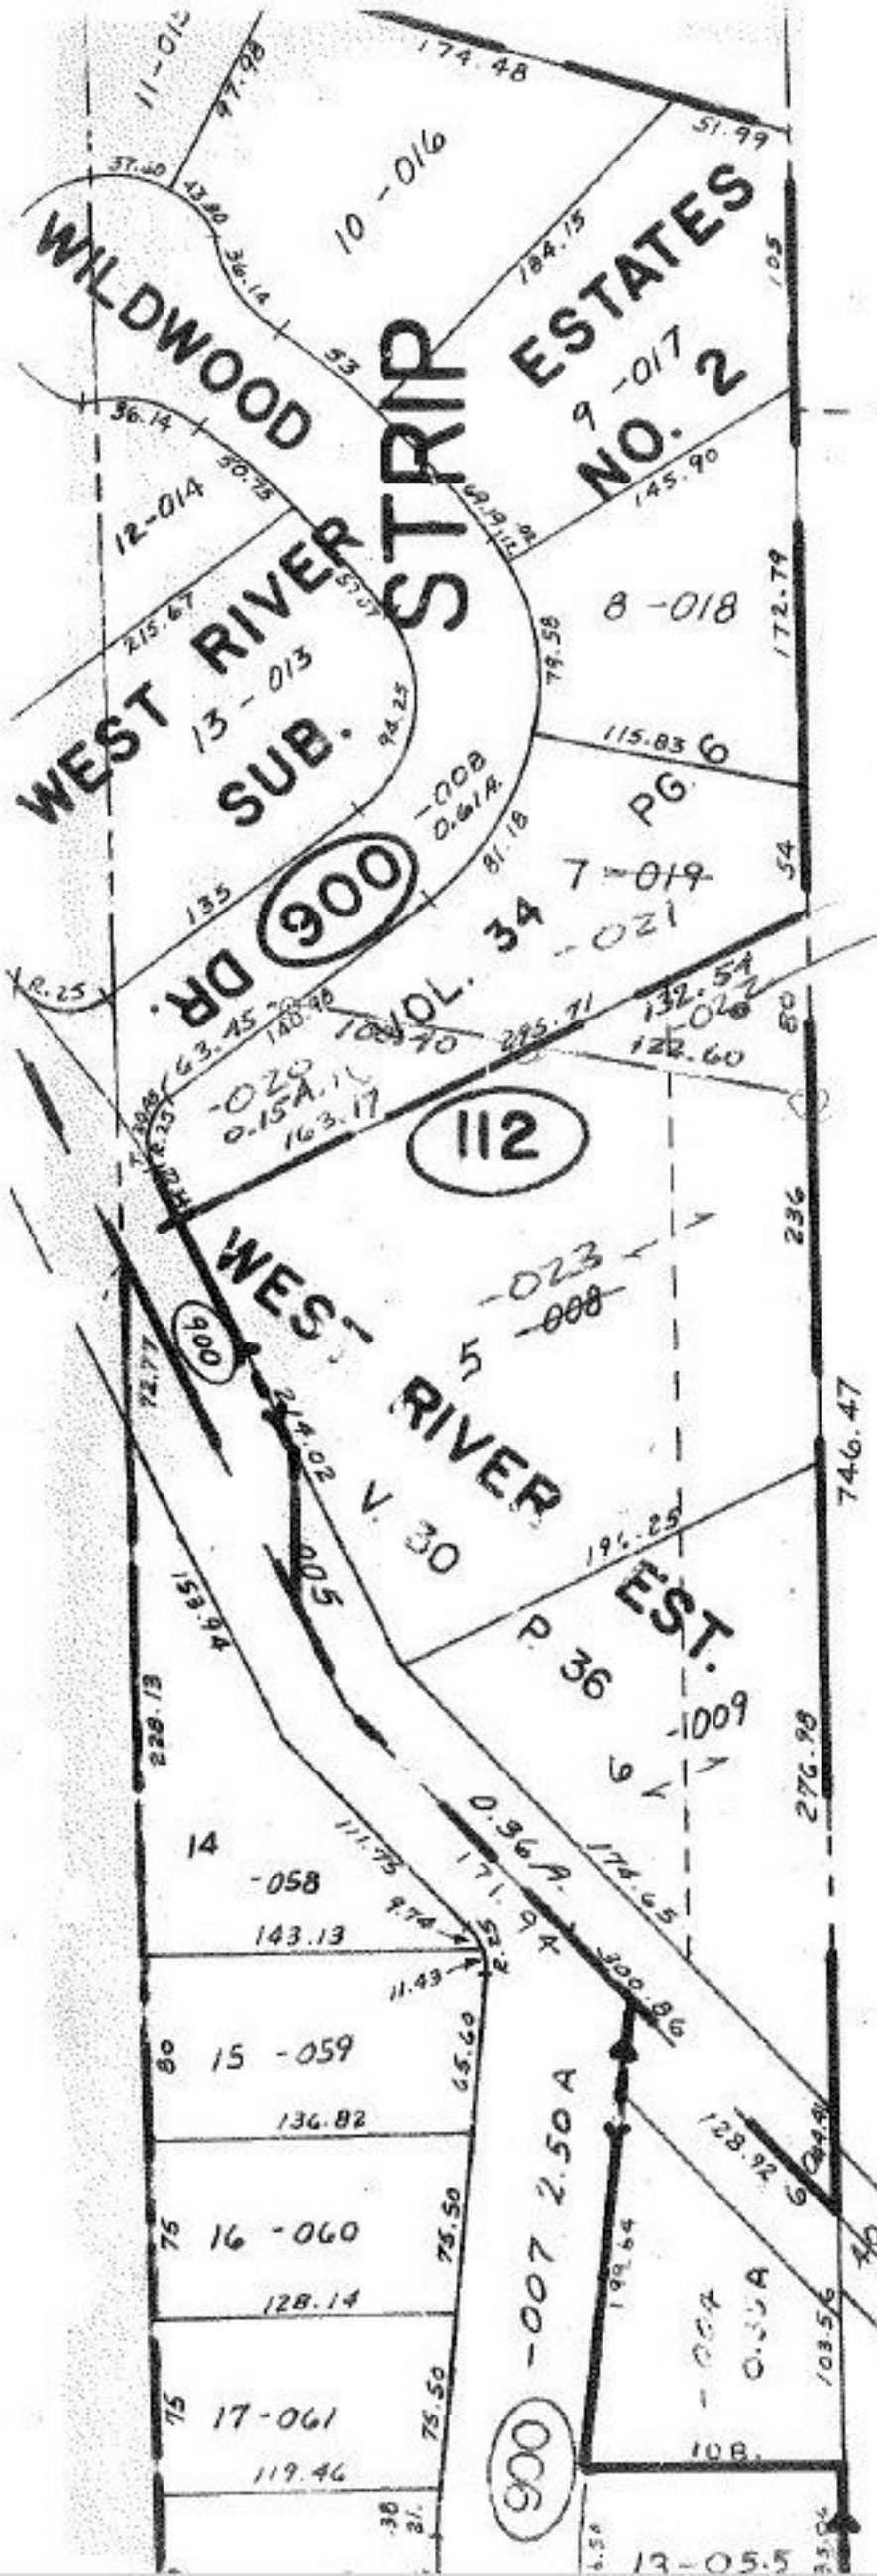

T.M.
5. 10. 80

#13453

APPROVED
LORAIN CO.
MAP DEPT.

DATE 3-20-80

PAGE 1-00-017-A

BY T. McRair P.C.

VOID
AFTER

190.98
 63.95
 77.53
 81.18
 158.71

-168

24.96 A