


#13454

29

Pt - 005  
Pt 13.19 Ft.

21

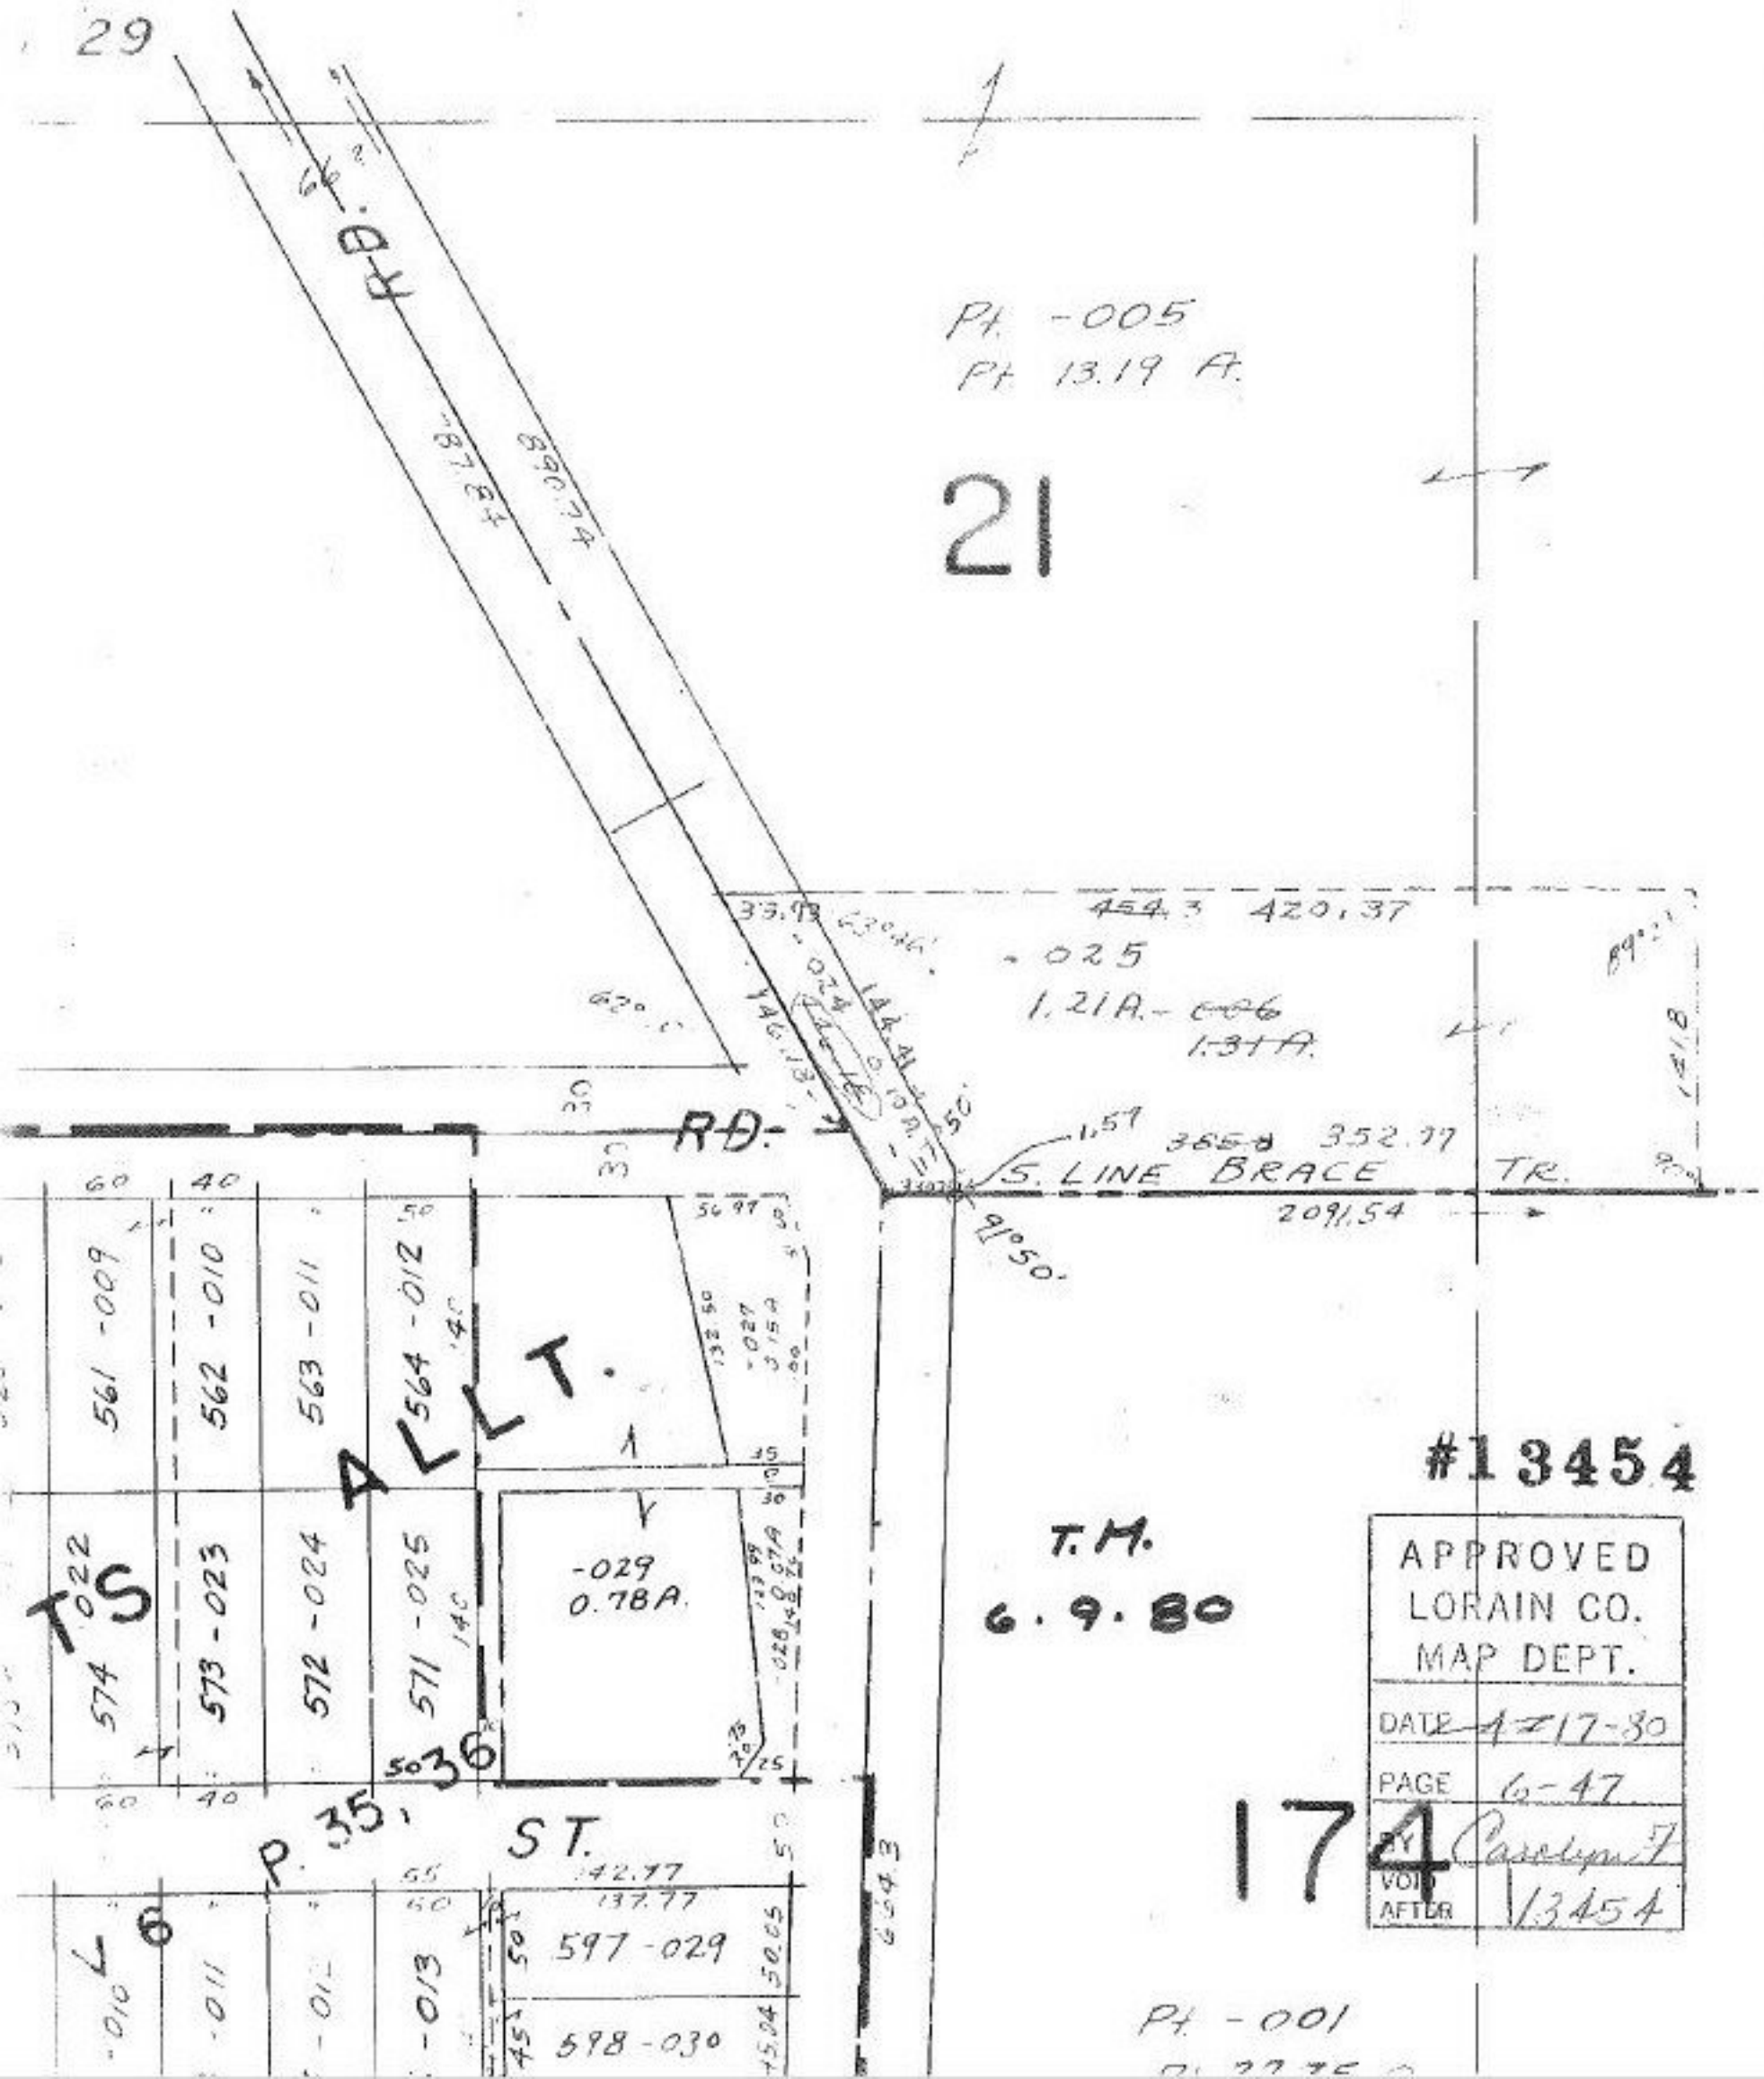

#13454

T.M.  
6.9.80

APPROVED	
LORAIN CO.	
MAP DEPT.	
DATE	4-17-80
PAGE	6-47
BY	Carolyn F
VOID AFTER	13454

174

Pt - 001