


SEE

SEE

#13461

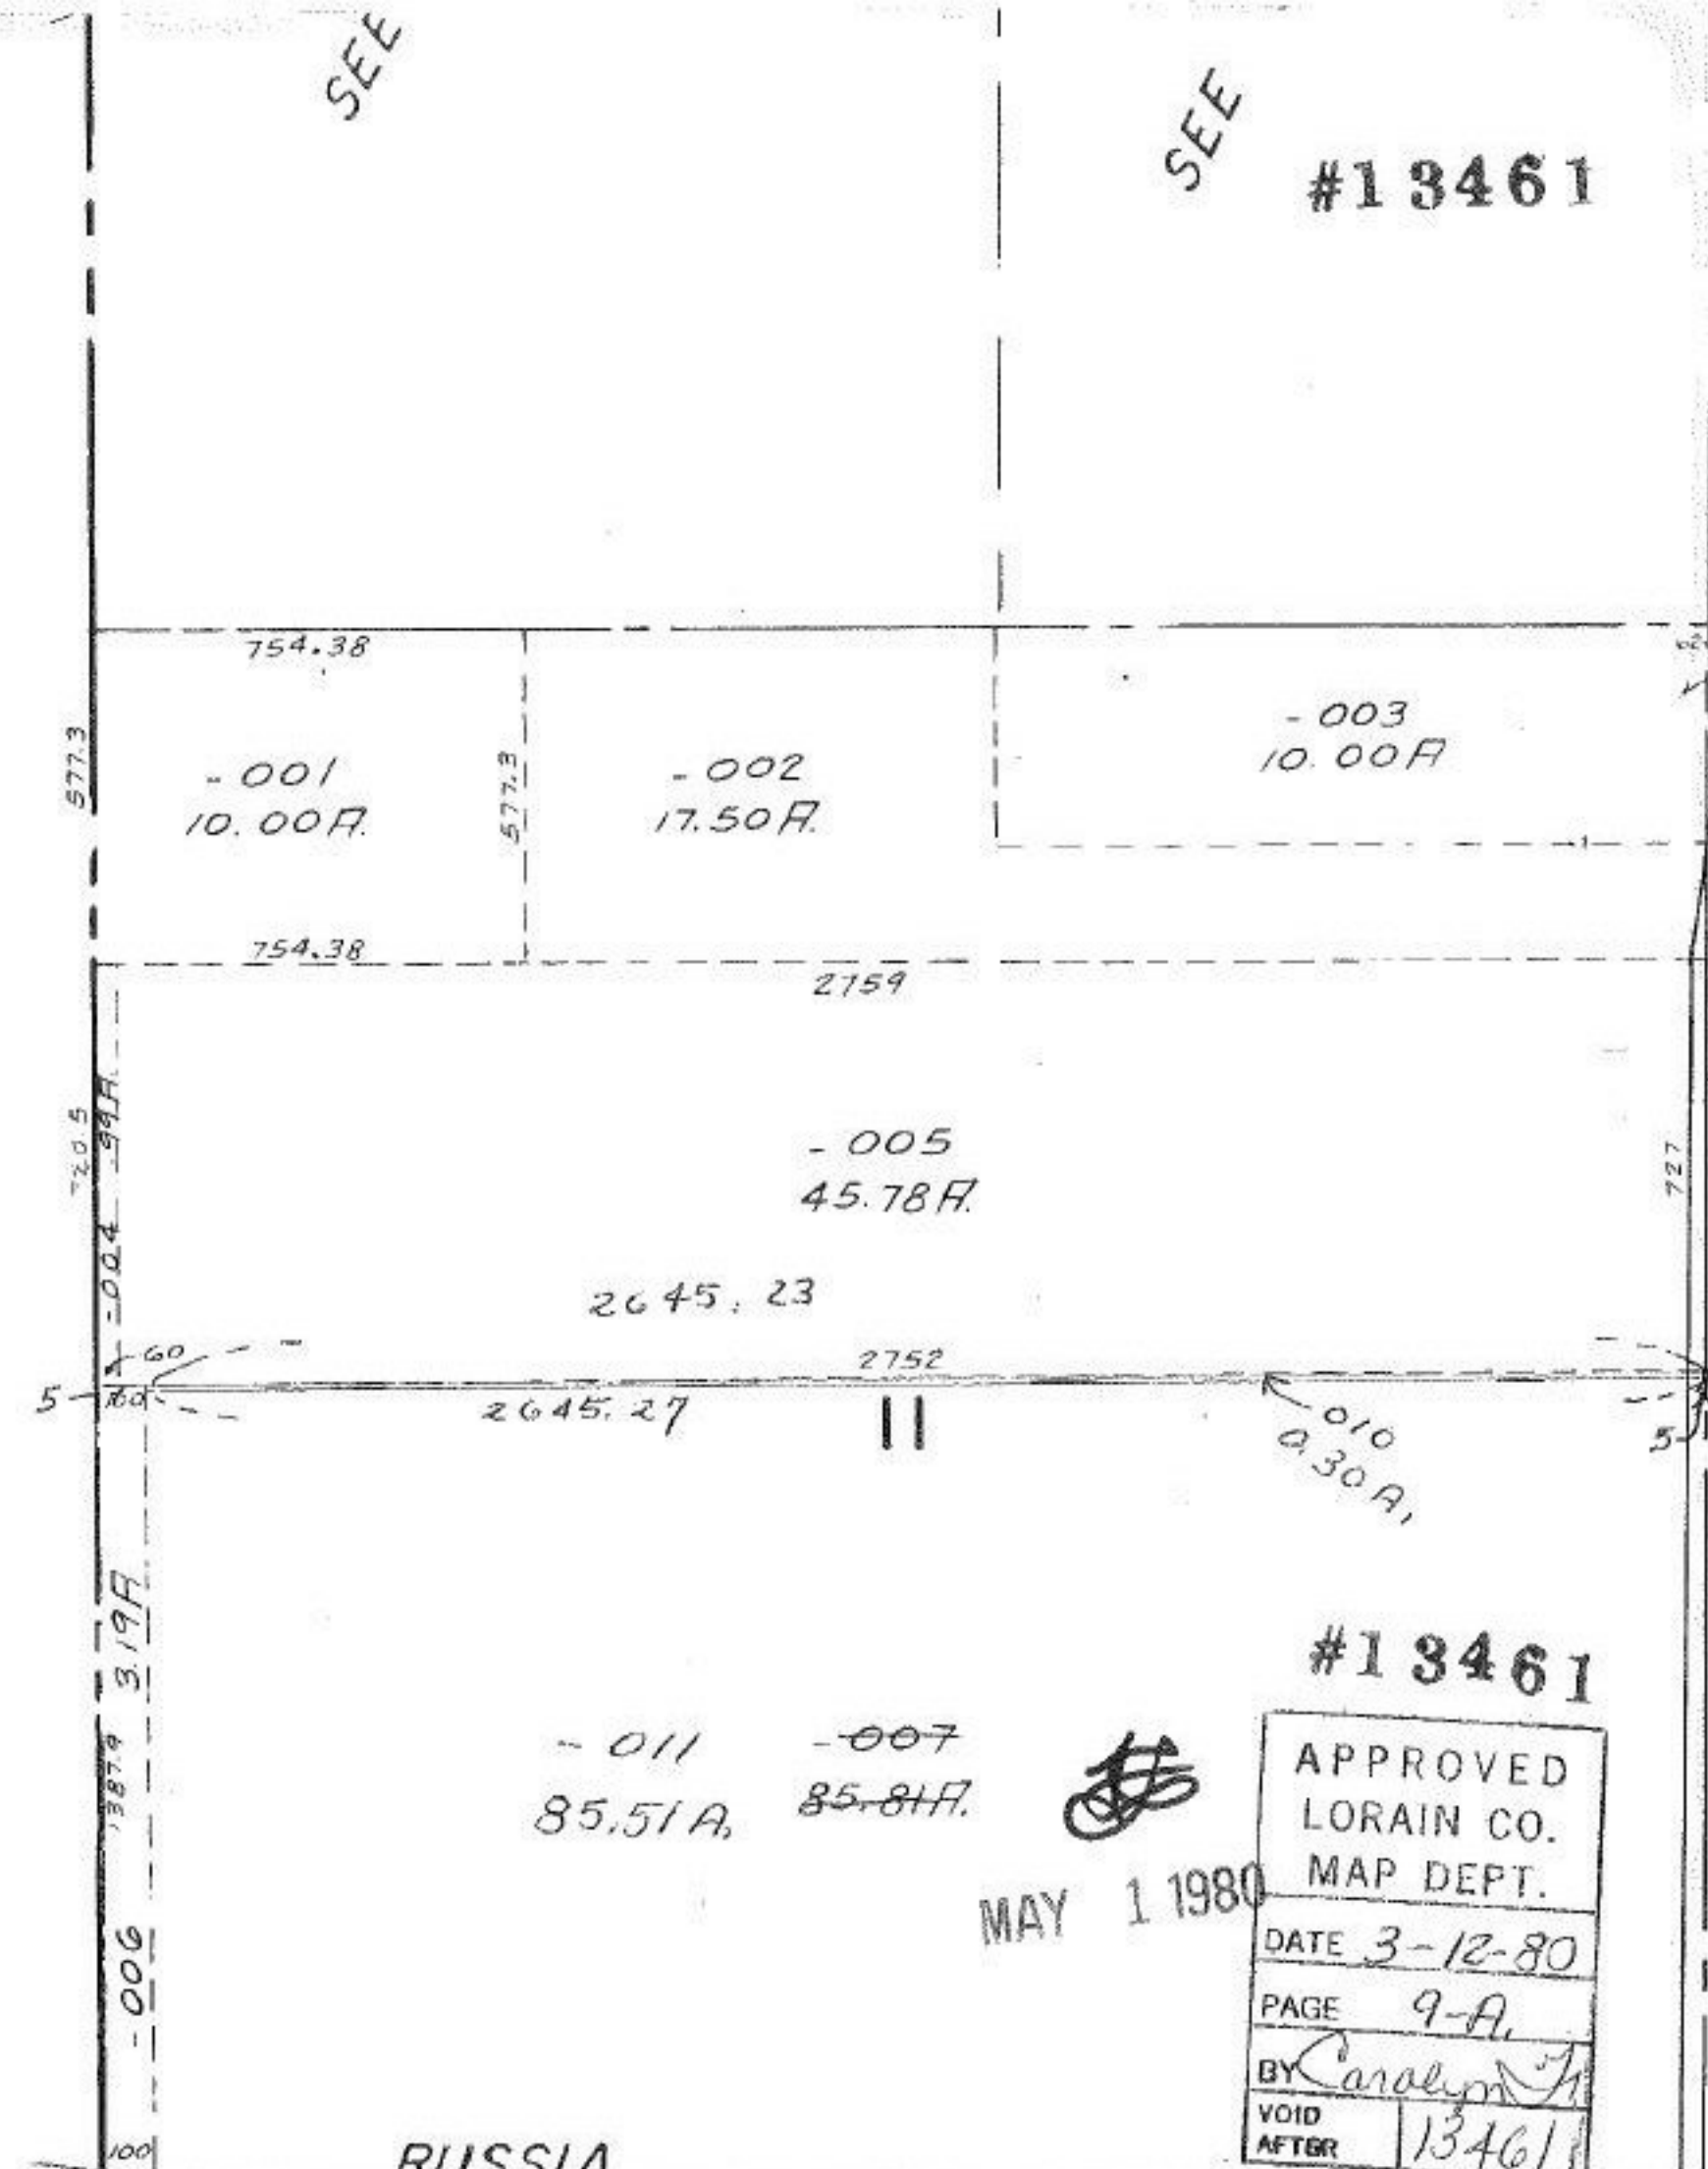

#13461

APPROVED  
LORAIN CO.  
MAP DEPT.

DATE 3-12-80

PAGE 9-A.

BY *Carolyn*

VOID AFTER 13461

MAY 1 1980

RUSSIA

