

13462

10.63 A.

1.00 A.

APPROVED
 LORAIN CO.
 MAP DEPT.

DATE 3-12-80

PAGE 6-24

BY T.M.Plan

VOID AFTER 1-001

373A

#13462

-002
2.38A

101

228.7

DEBRA

FRANK

YUHAS

SUB: 4

See Resolution 61.422

8


-033
1.86A

104

P.14A

104

20
FF
-008

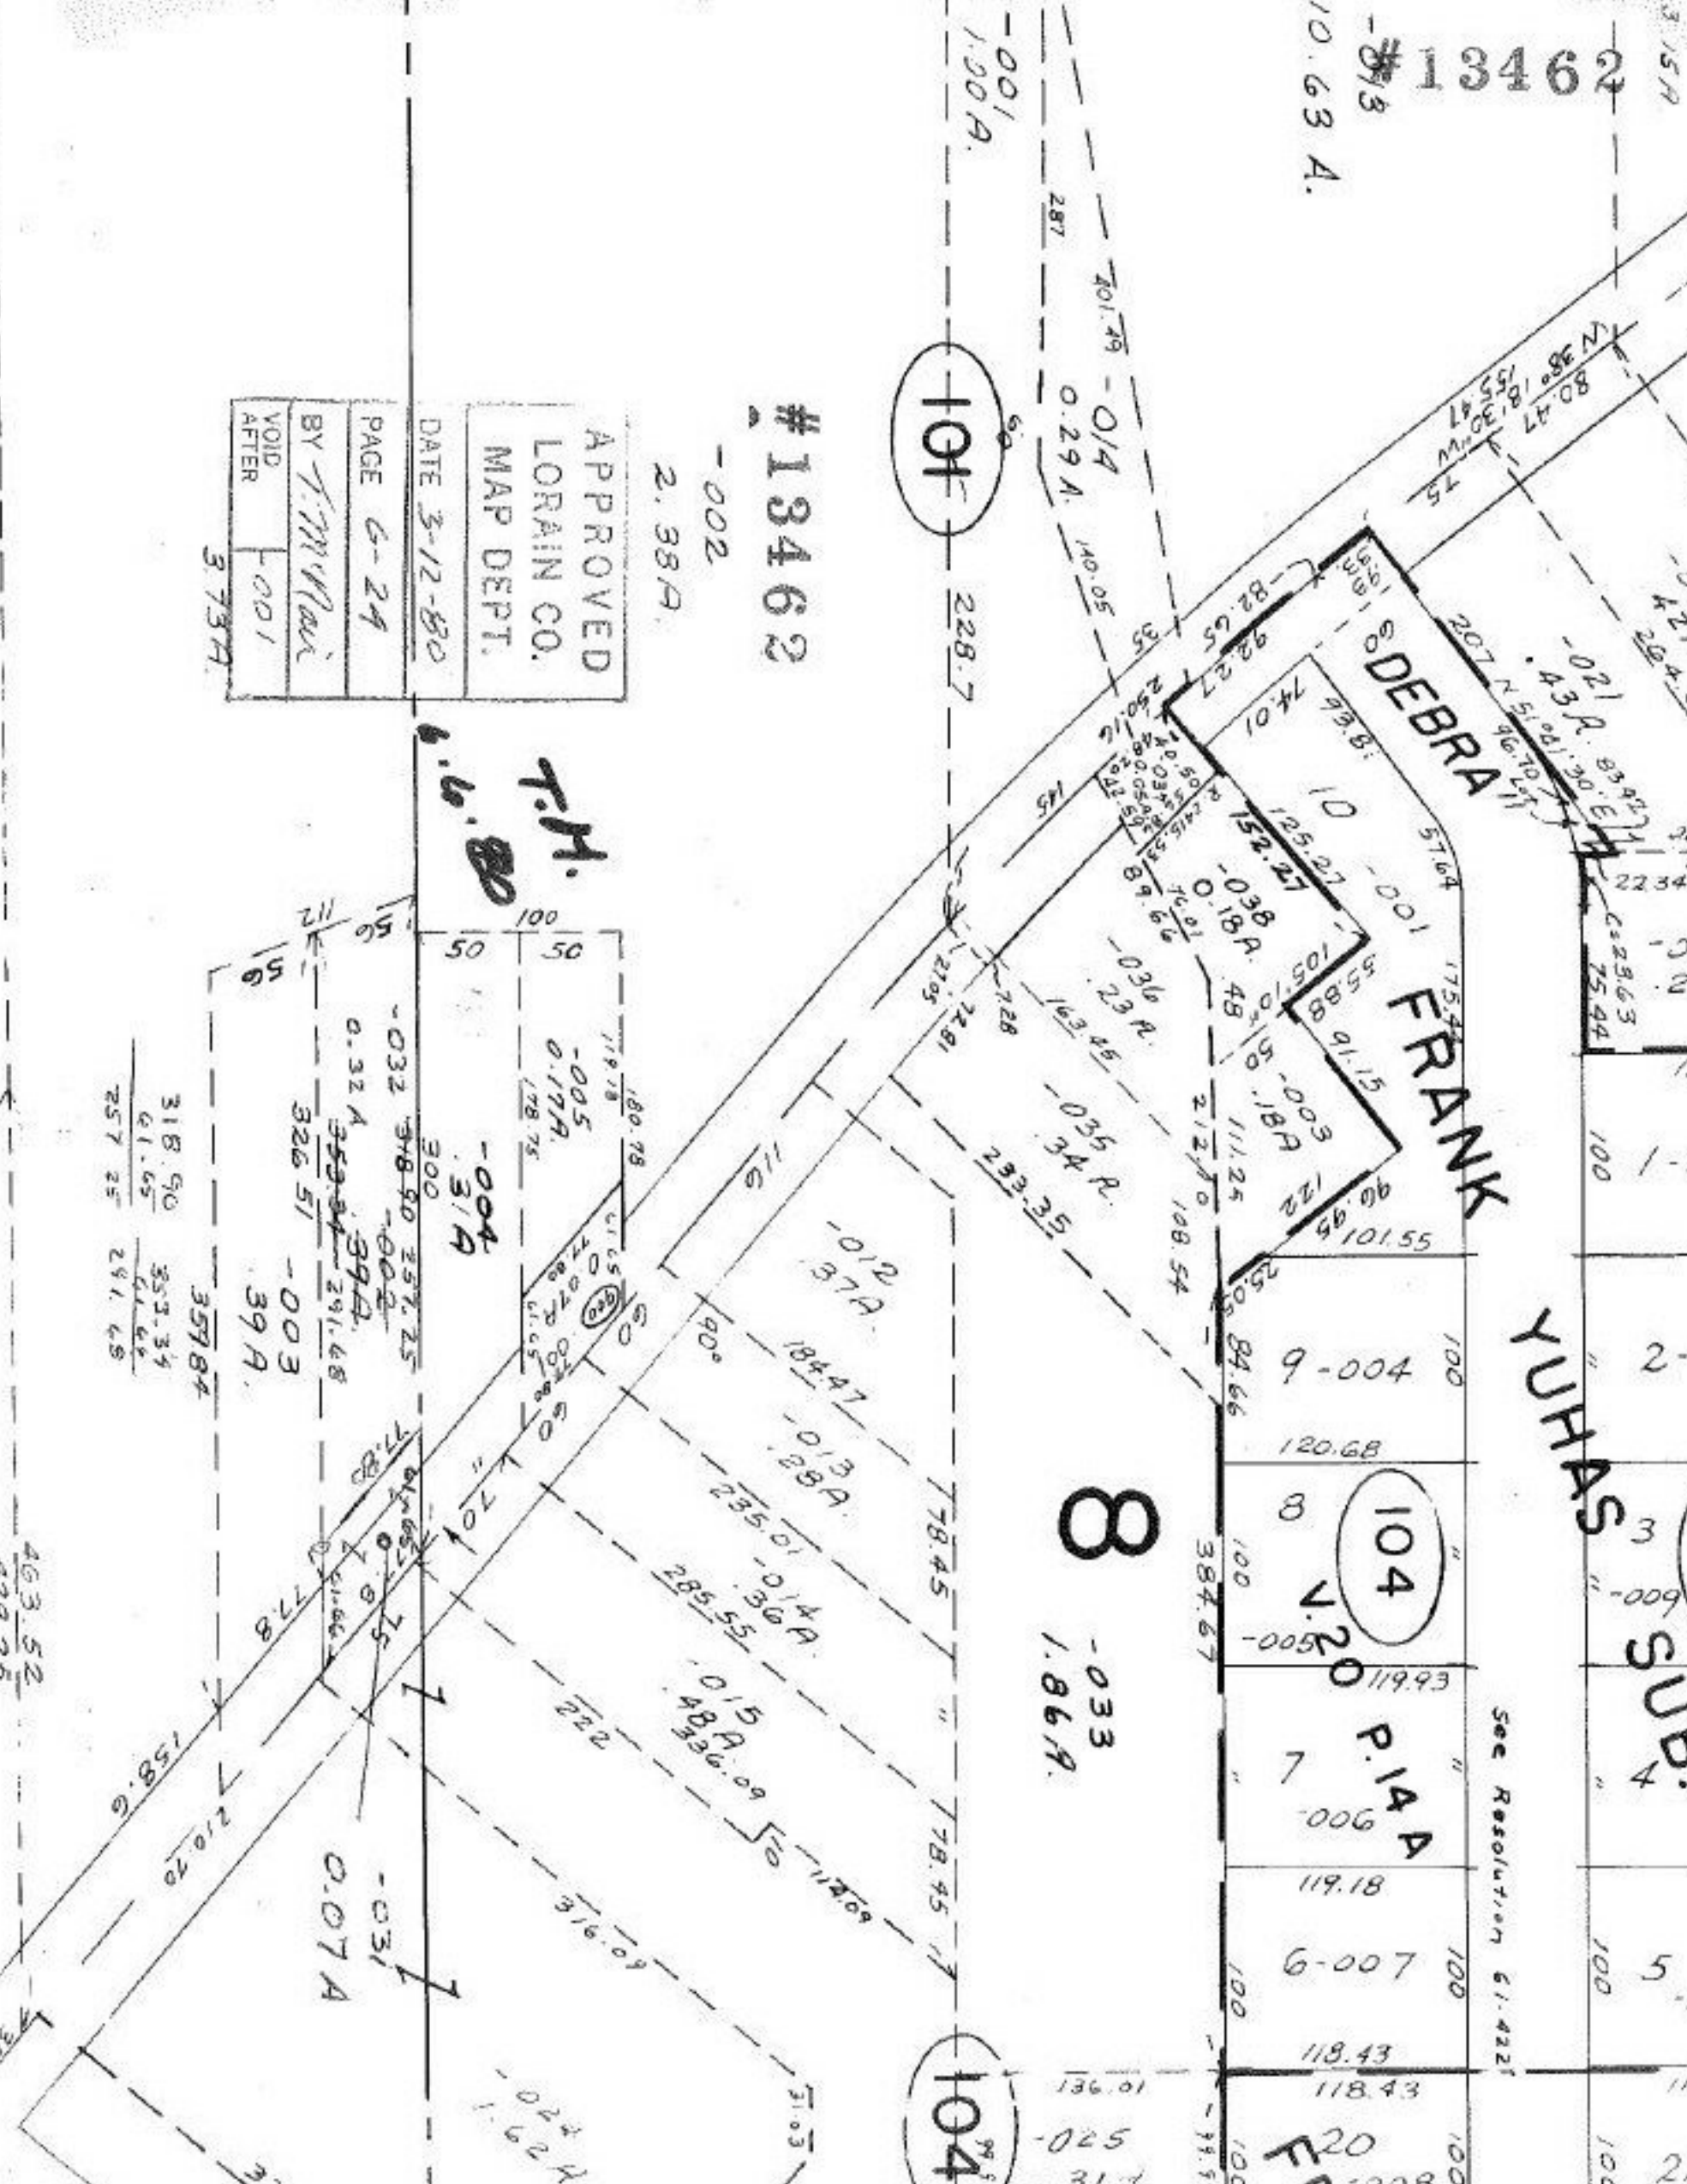

35784

353.34

61.65

257.25

463.52

429.25

0.07A

-031

1.125A

1.125A

