

280
-004 .51A
-005 .51A
-006 .51A
-007 .51A
280


-010
35.21A.

"ACREAGE CORRECTION"

SEE 13-17

HAIGH

Acreages Correction
per Survey Deed by ~~M. B. A.~~ 14.74A.
William L. Fox (5878) 9/73

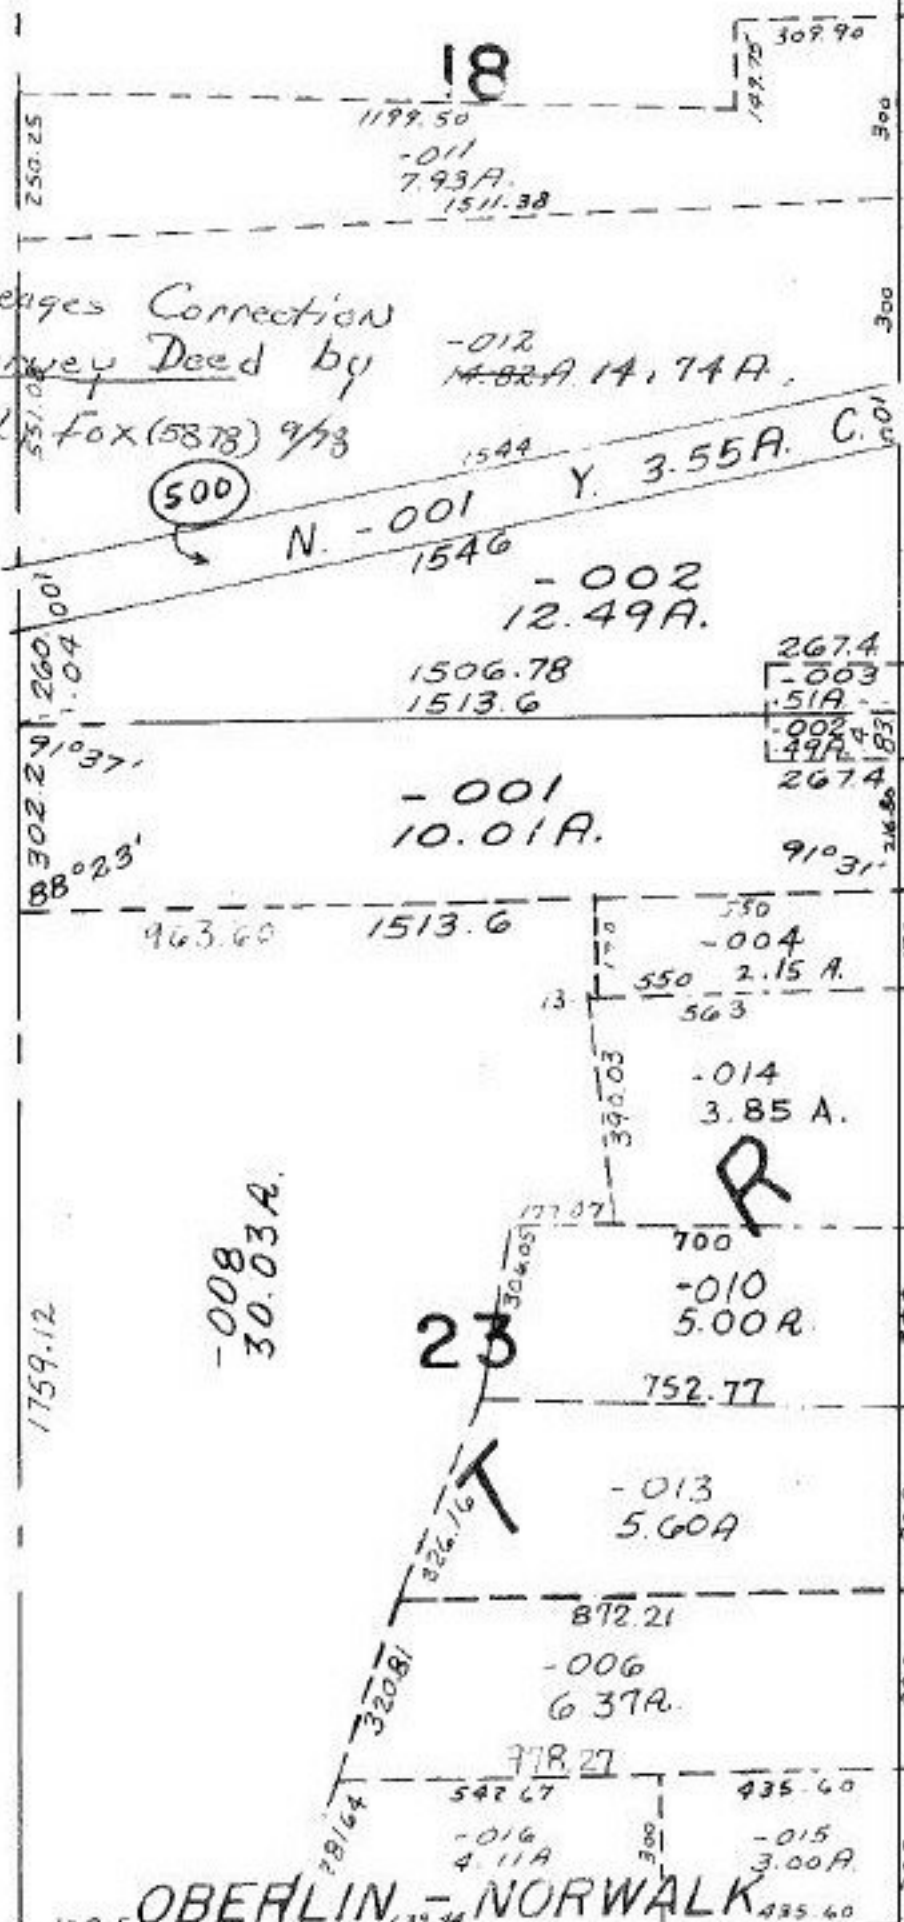

T.M.
6.5.80

13472

APPROVED
RAIN CO.
MAP DEPT.
DATE 3-18-80
PAGE 13-B
BY Carolyn F
VOID AFTER 13472

24

20

OBERLIN - NORWALK