


#13473

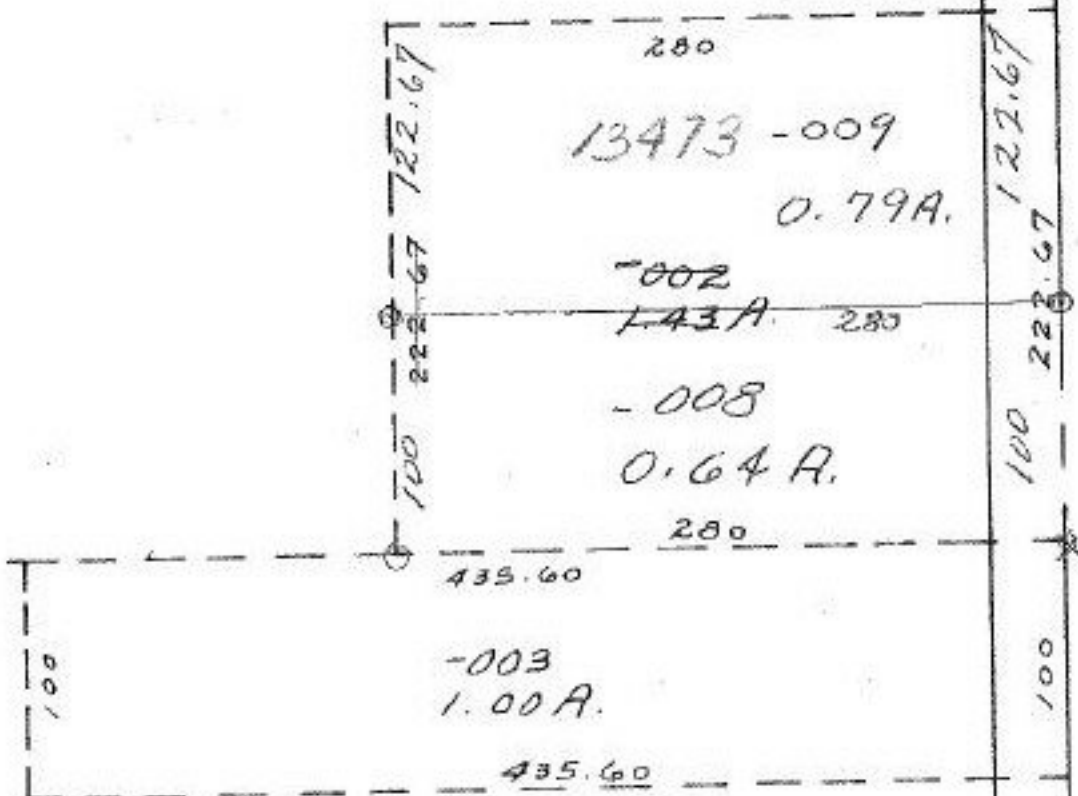

T.M.
5.22.80

SEE 3-00-023-A

#13473

APPROVED LORAIN CO. MAP DEPT.	
DATE 3-18-80	
PAGE 3-00-026-B	
BY Carolyn H	
VOID AFTER	13473

00A

00A