

SEE 7-00-008-C

-032
4.77A

374.93

17.25
7.71

24.96

1291.05
1291.03
1291.02
1291.53
374.93
40
53
93

Pt
Pt

915.53

-031
1290.46

#13482

| | |
|------------|---------|
| APPROVED | |
| LORAIN CO. | |
| MAP DEPT. | |
| DATE | 3-21-80 |
| PAGE | 16-D |
| BY | Carolyn |
| VOID | |
| ACTED | 13482 |

T.M.
5-30-80

7-00-008-D

-060
17.25A,

-059
7.71A,

799.92


WHAT IS THIS ?

-057
24.96A

1415.70
1154.26

799.92
713.92

66

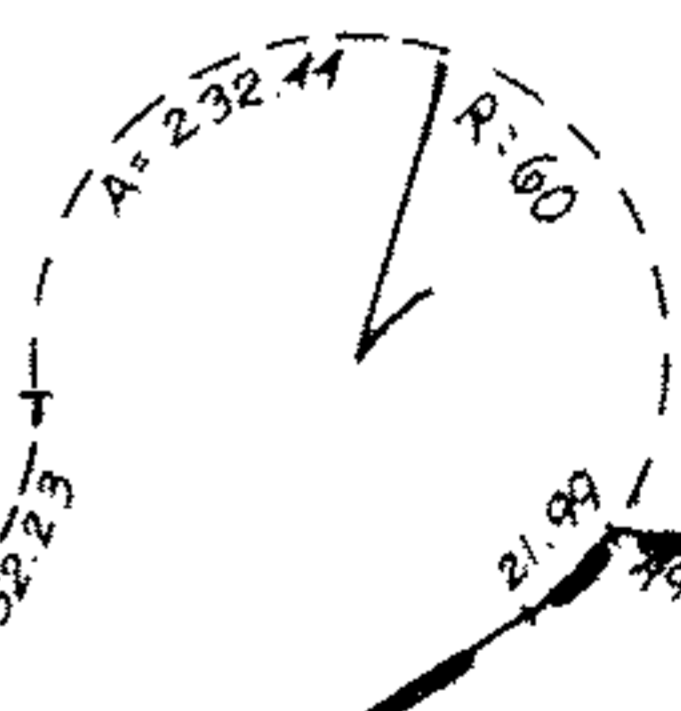

164.11

LIBERTY INDUSTRIAL PARK
CONDOMINIUM
SEE 7-00-008-D-1
V. 36
PGS. 10-12

373.14
537.25

244

-054
1.05 A.

17.25
7.71

4.46

R: 900
29.85

60
166

105

347.90

12

48