


#13483

RD.

-001  
69.00 A.

SE CORNER  
TRAYLER ✓

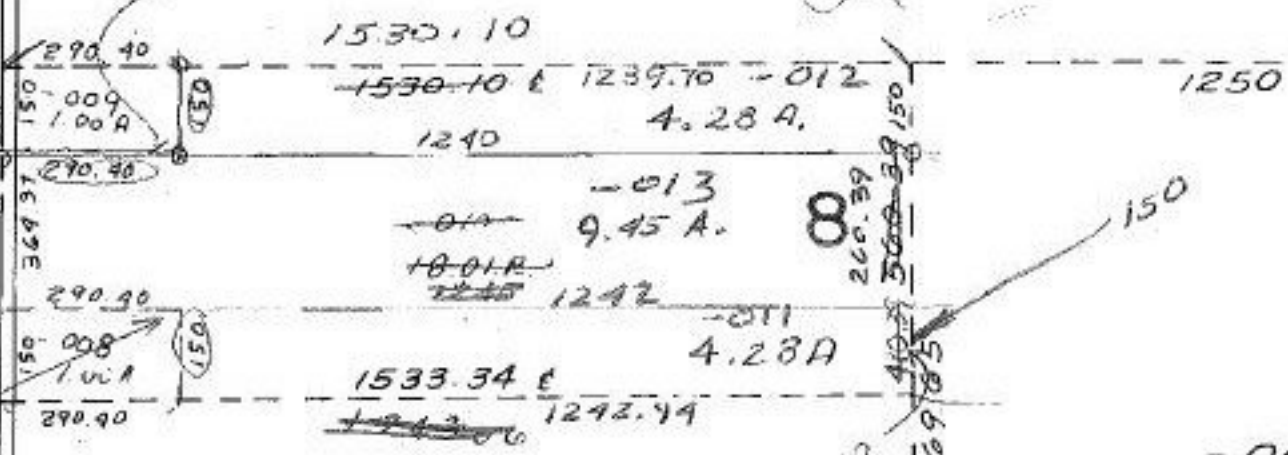

NE  
CORNER  
NORRIS

-004  
25.00 A.

-003  
37.99 A.

-006 10.02 R.  
-007 9.98 R.

T.M.  
6.3.80

#13483

APPROVED LORAIN CO. MAP DEPT.
DATE 3-21-80
PAGE 16-D
BY T.M. Miller
VOID AFTER

18.01  
4.28  
-----  
13.73  
9.28  
-----  
9.95

9.45  
8.50  
-----  
18.01

-004  
121.50 A.