


SE

SEE

#13484

RD.

2-02-611-B

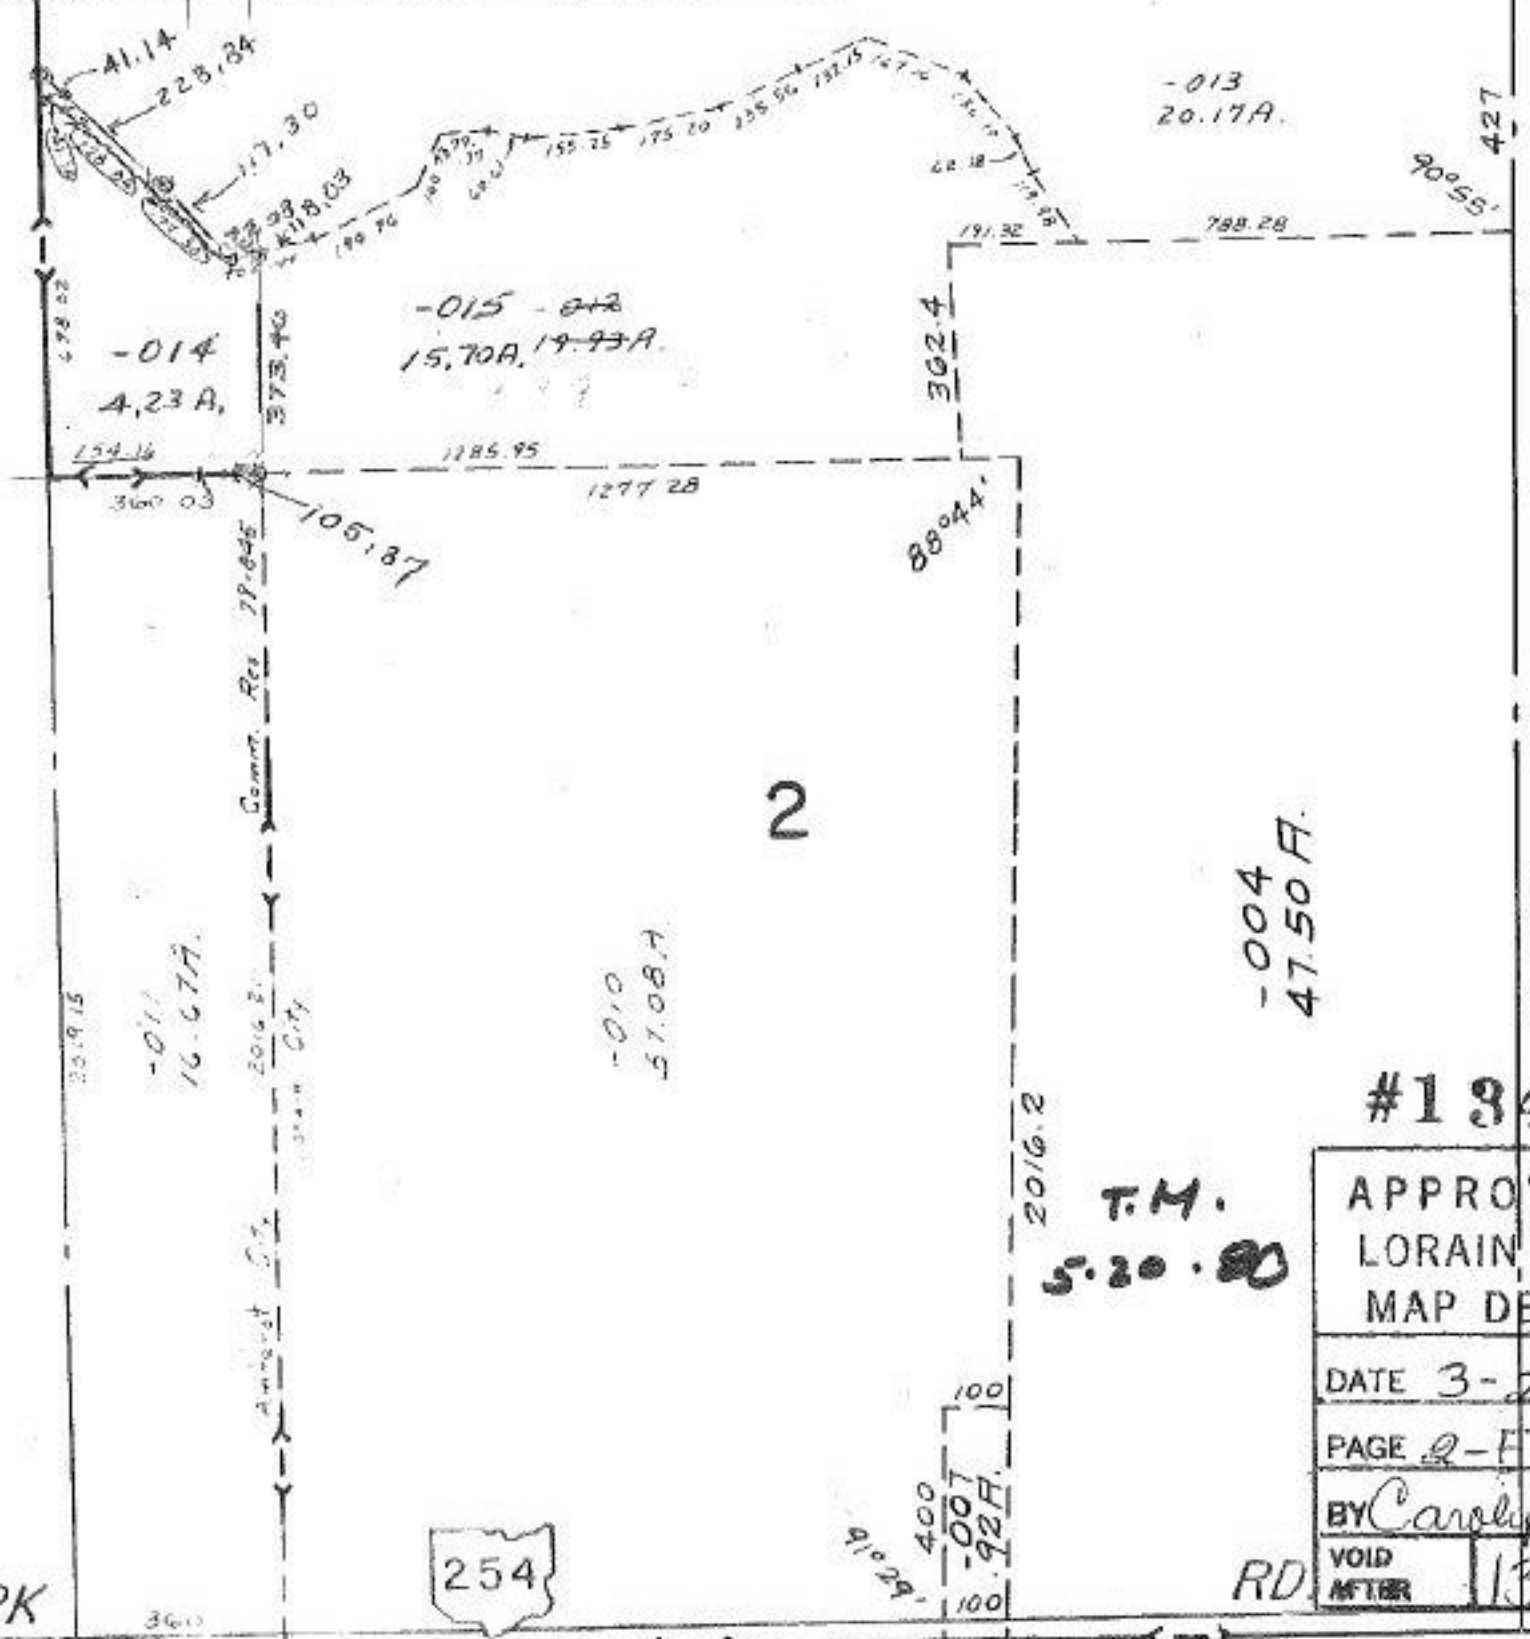

APPROVED LORAIN CO. MAP DEPT.	
DATE	3-24-80
PAGE	2-F
BY	Carolyn F
VOID AFTER	13484

T.M.
5.20.80



RD.

EP PARK

1, 2, 9, 10, 11, 12, 19, 20, 21

1, 5, 6

Copyric