

SEE

SEE

SEE

5

13486


ACKERMAN

RD.

CORP.

211.65
97.21
114.64

113.60
96.81
16.79

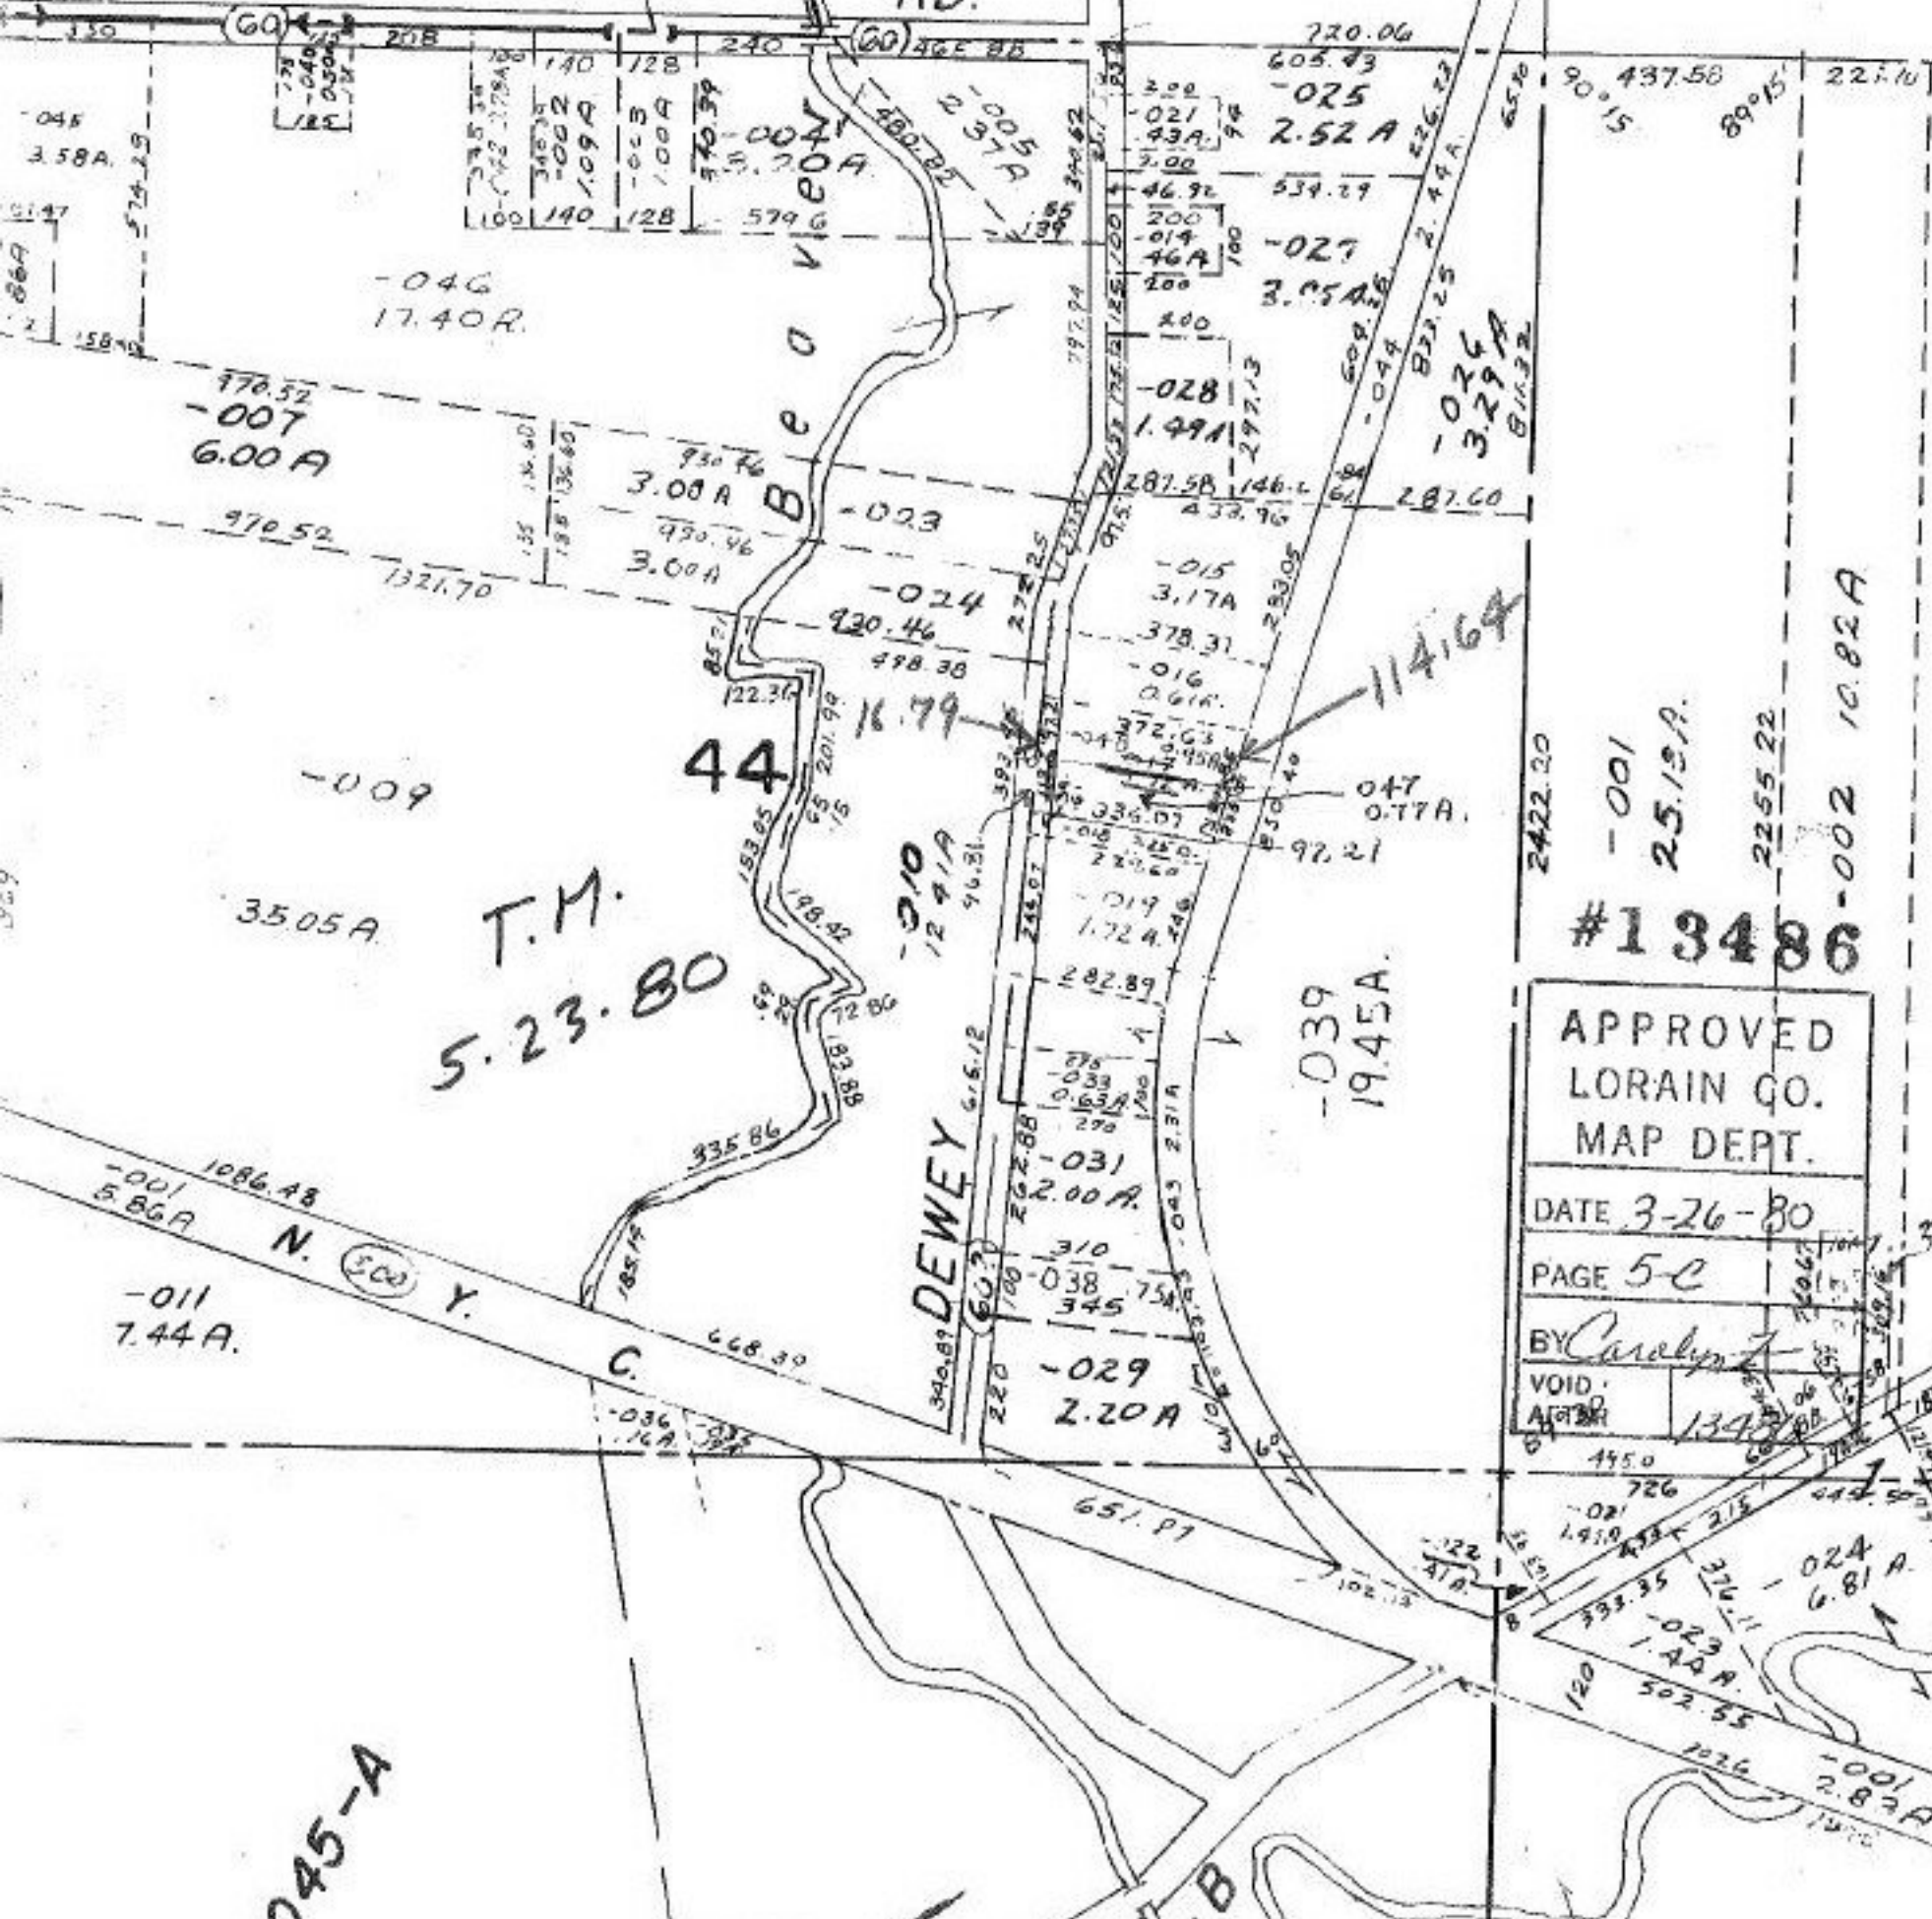

90° 15' 221.10

89° 15'

2422.20

-001 25.19A.

2255.22

13486

APPROVED LORAIN CO. MAP DEPT.

DATE 3-26-80

PAGE 5-c

BY Carolyn

VOID: 13486

4950

726

-045-A

BRIDGE

B