

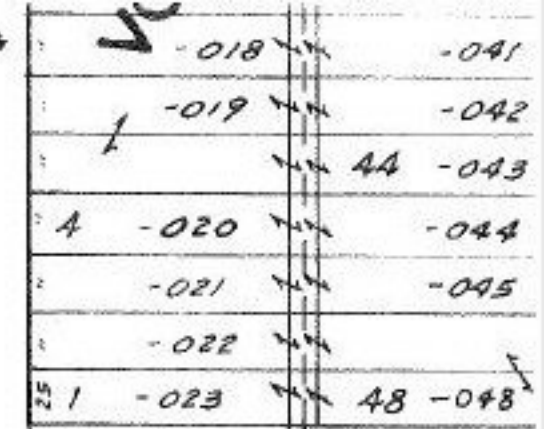
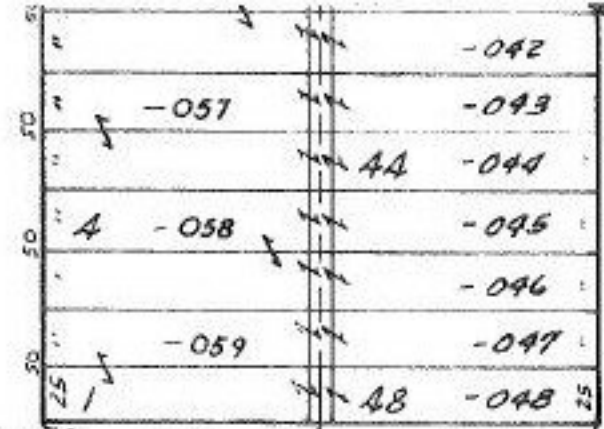
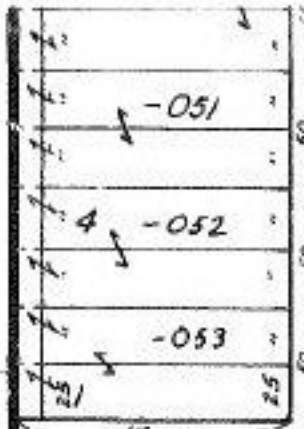
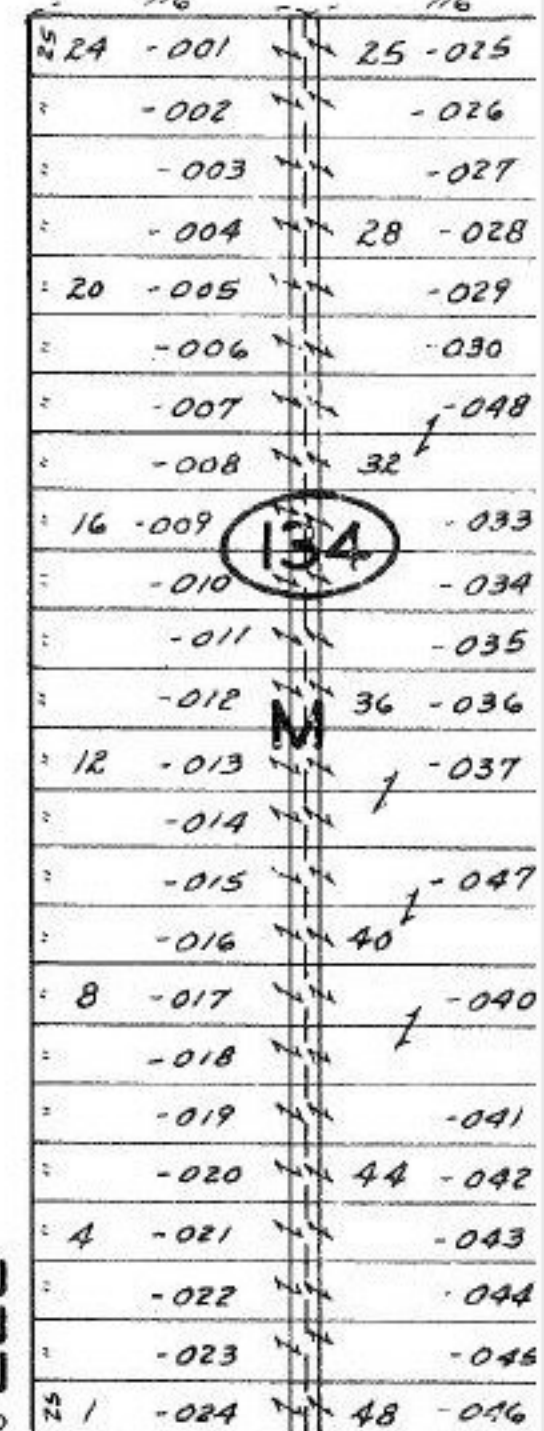


SEE

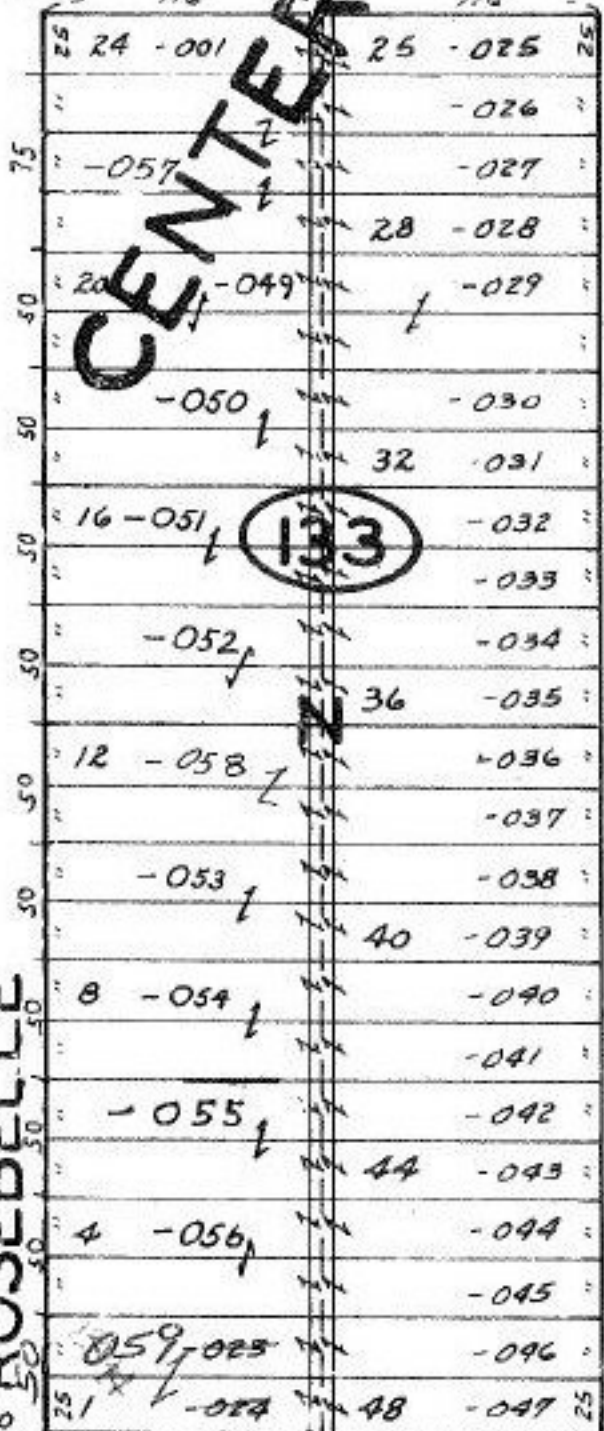

MILDRED

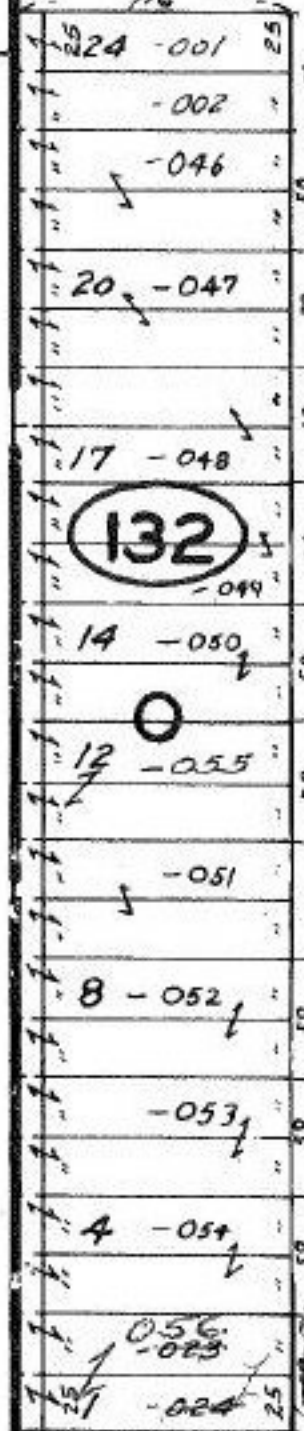

HELEN

ROSEBELLE

CENTER

LEE

#13494

T.M.
5.30.80

APPROVED
LORAIN CO.
MAP DEPT.

DATE 4-28-80

PAGE 70000 D

BY [Signature]

VOID
AFTER

SE

7-00-020-D

BRIDGE