


#13499

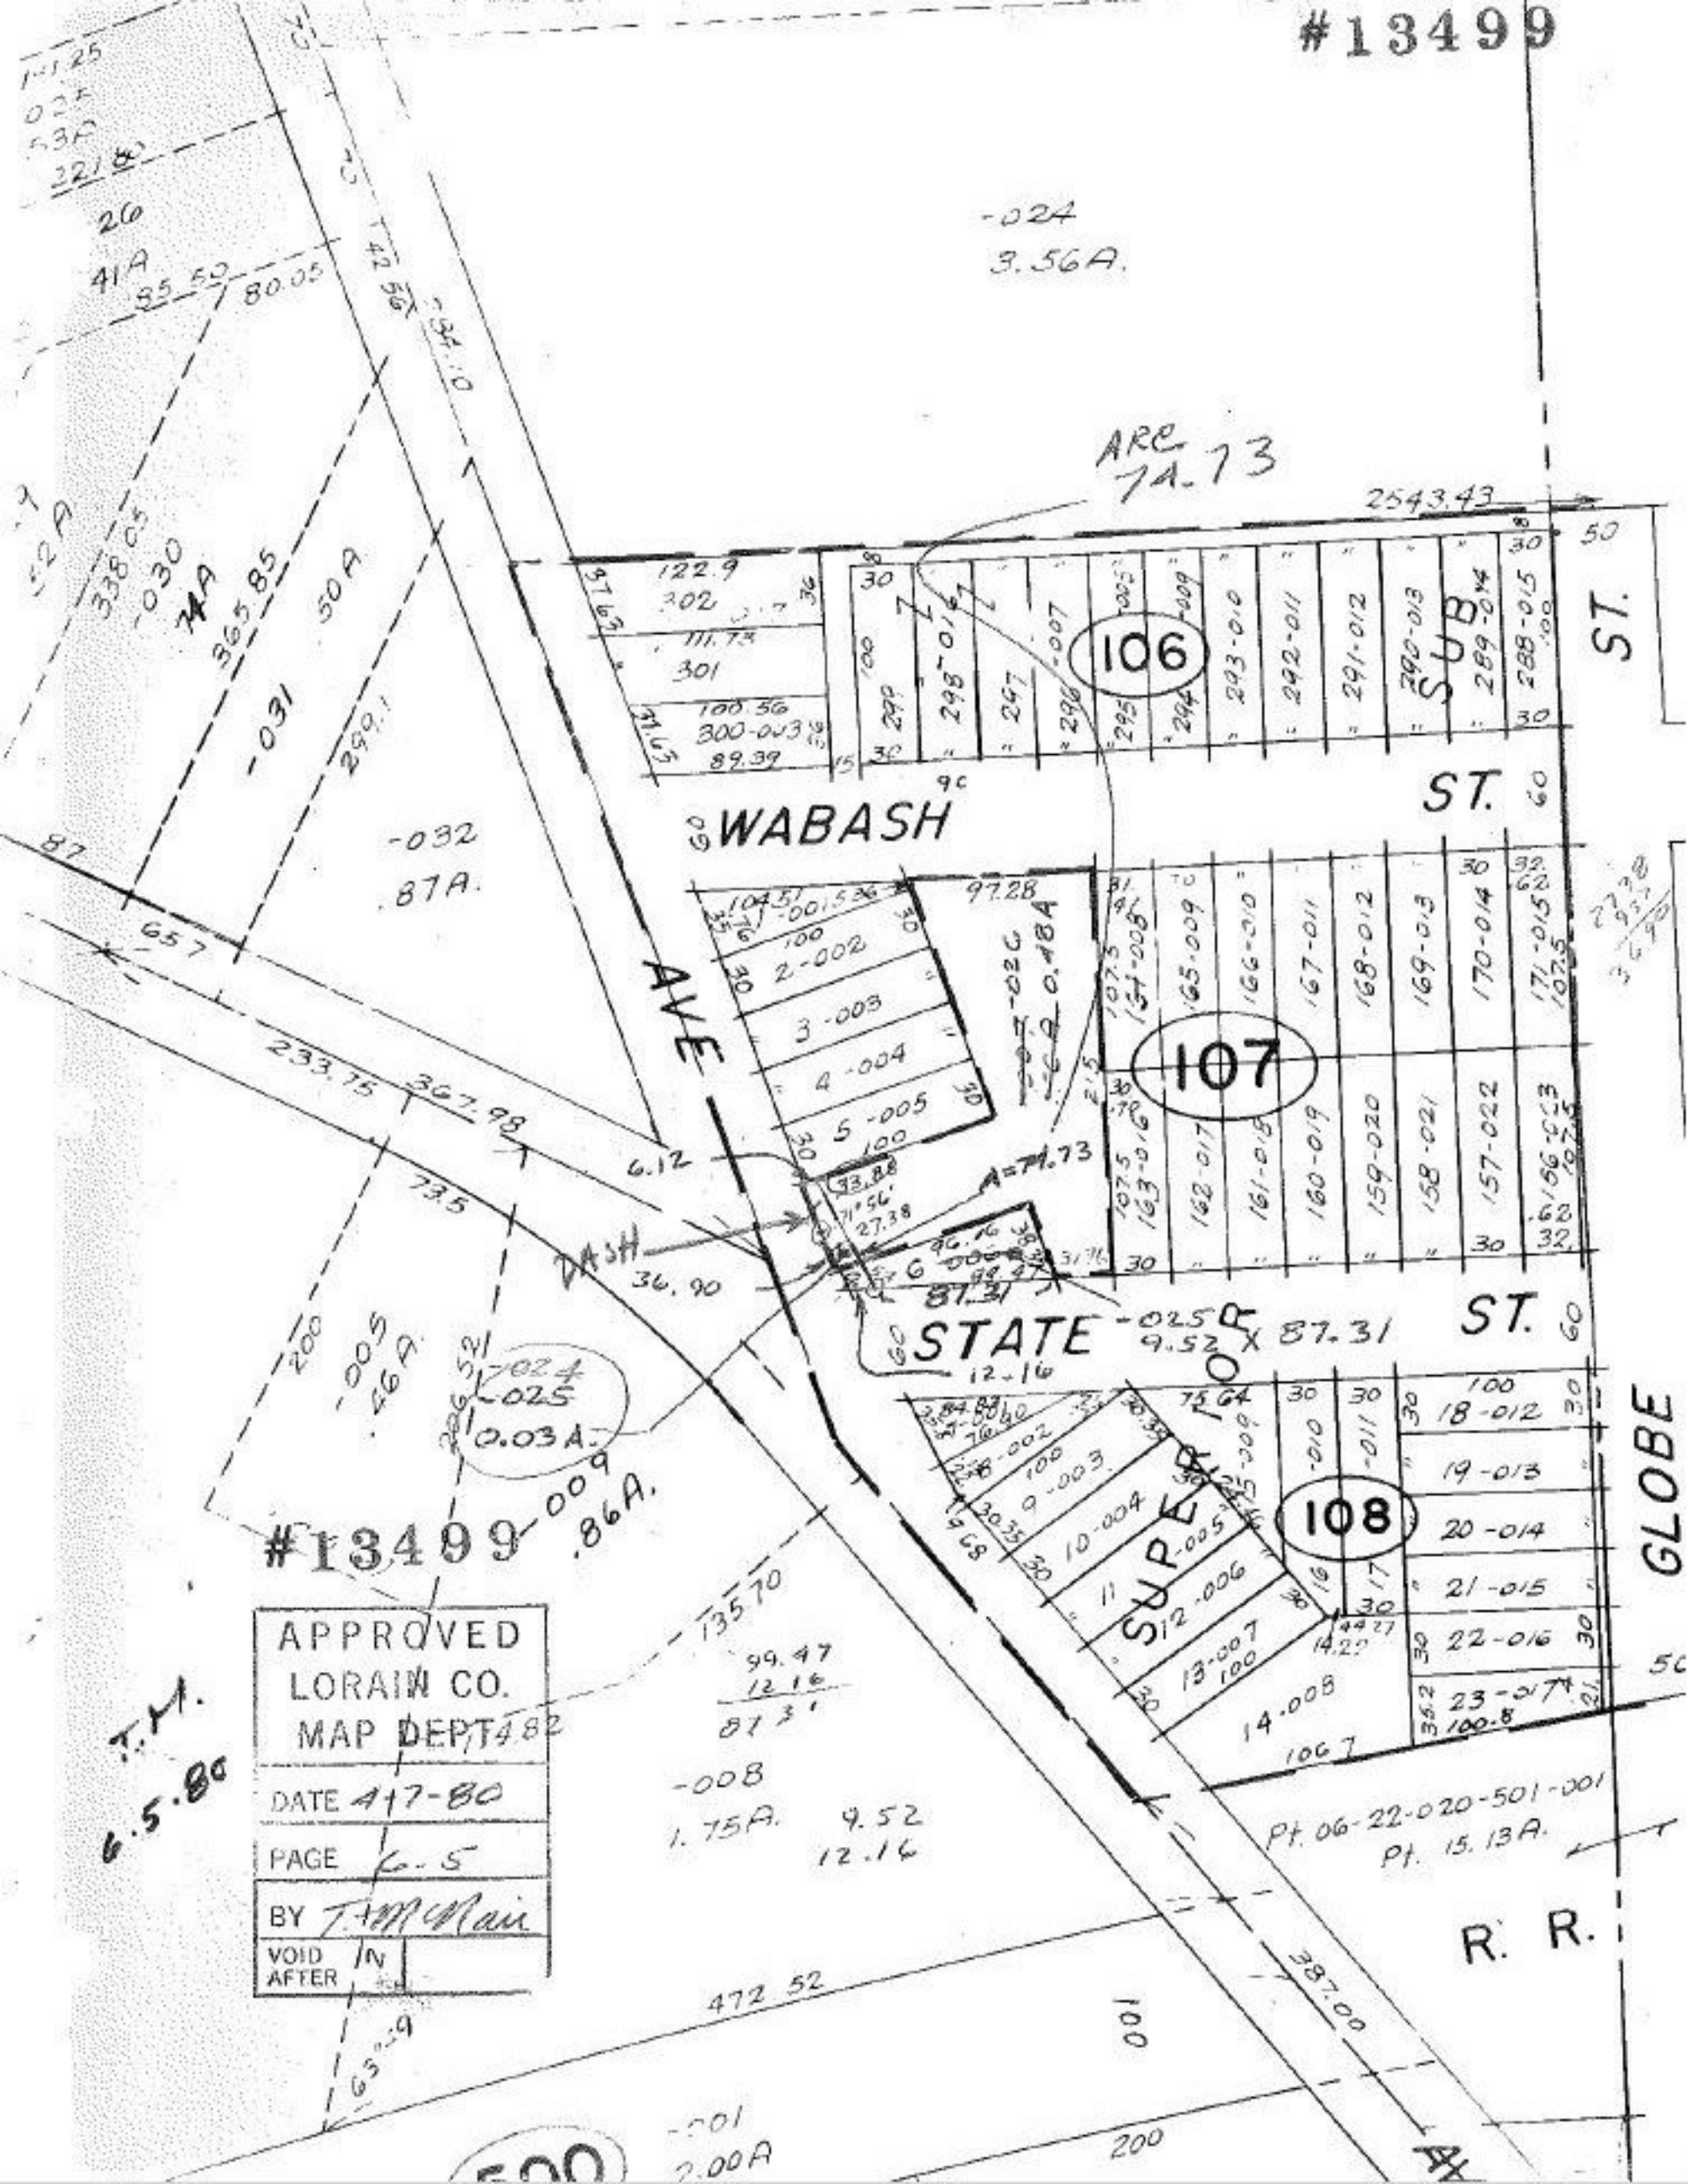

-024  
3.56A.

ARE  
7A.73

2543.43

ST.

ST.

WABASH

AVE

107

STATE

ST.

GLOBE

108

#13499

APPROVED	
LORAIN CO.	
MAP DEPT	
DATE	4-17-80
PAGE	6-5
BY	T.M. Main
VOID AFTER	IN

T.M.  
6-5-80

-008  
1.75A. 9.52  
12.16

Pt. 06-22-020-501-001  
Pt. 15.13A.

R. R.

500

-001  
2.00A

200

AV