


#13523

SE 6-25

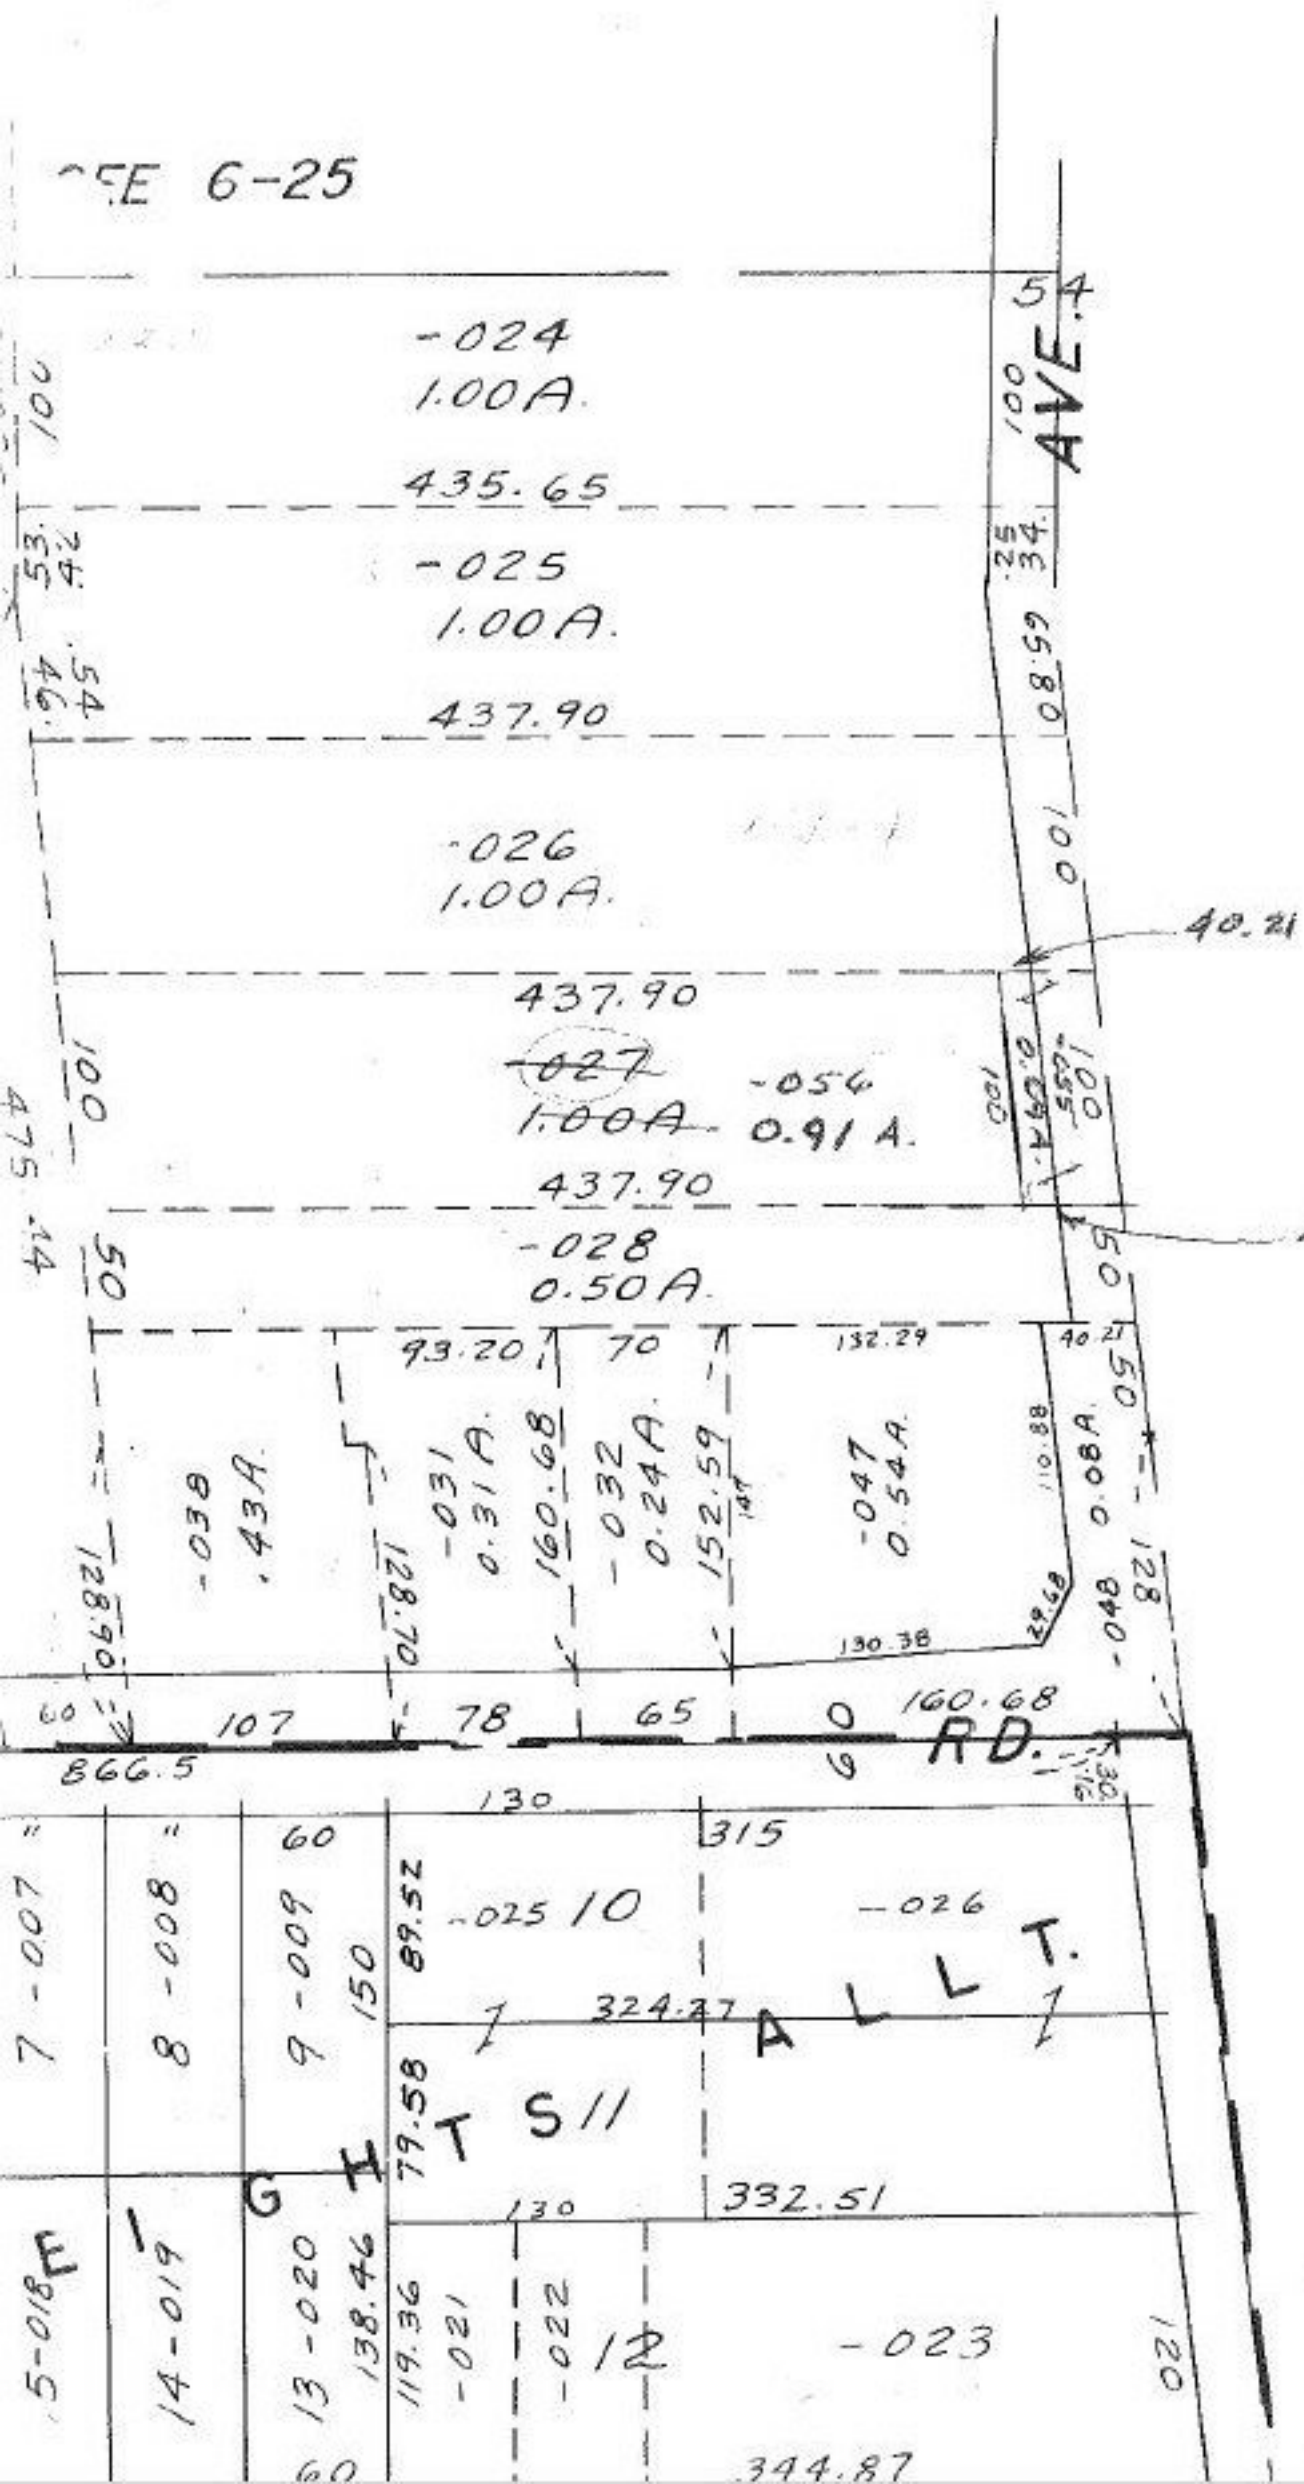

437.90
 40.21

 397.69
 40.21

 437.90

#13523

APPROVED LORAIN CO. MAP DEPT.	
DATE	4-15-80
PAGE	6-42
BY	T. M. M. [unclear]
VOID AFTER	

T.M.
6.9.80

