


# 13526

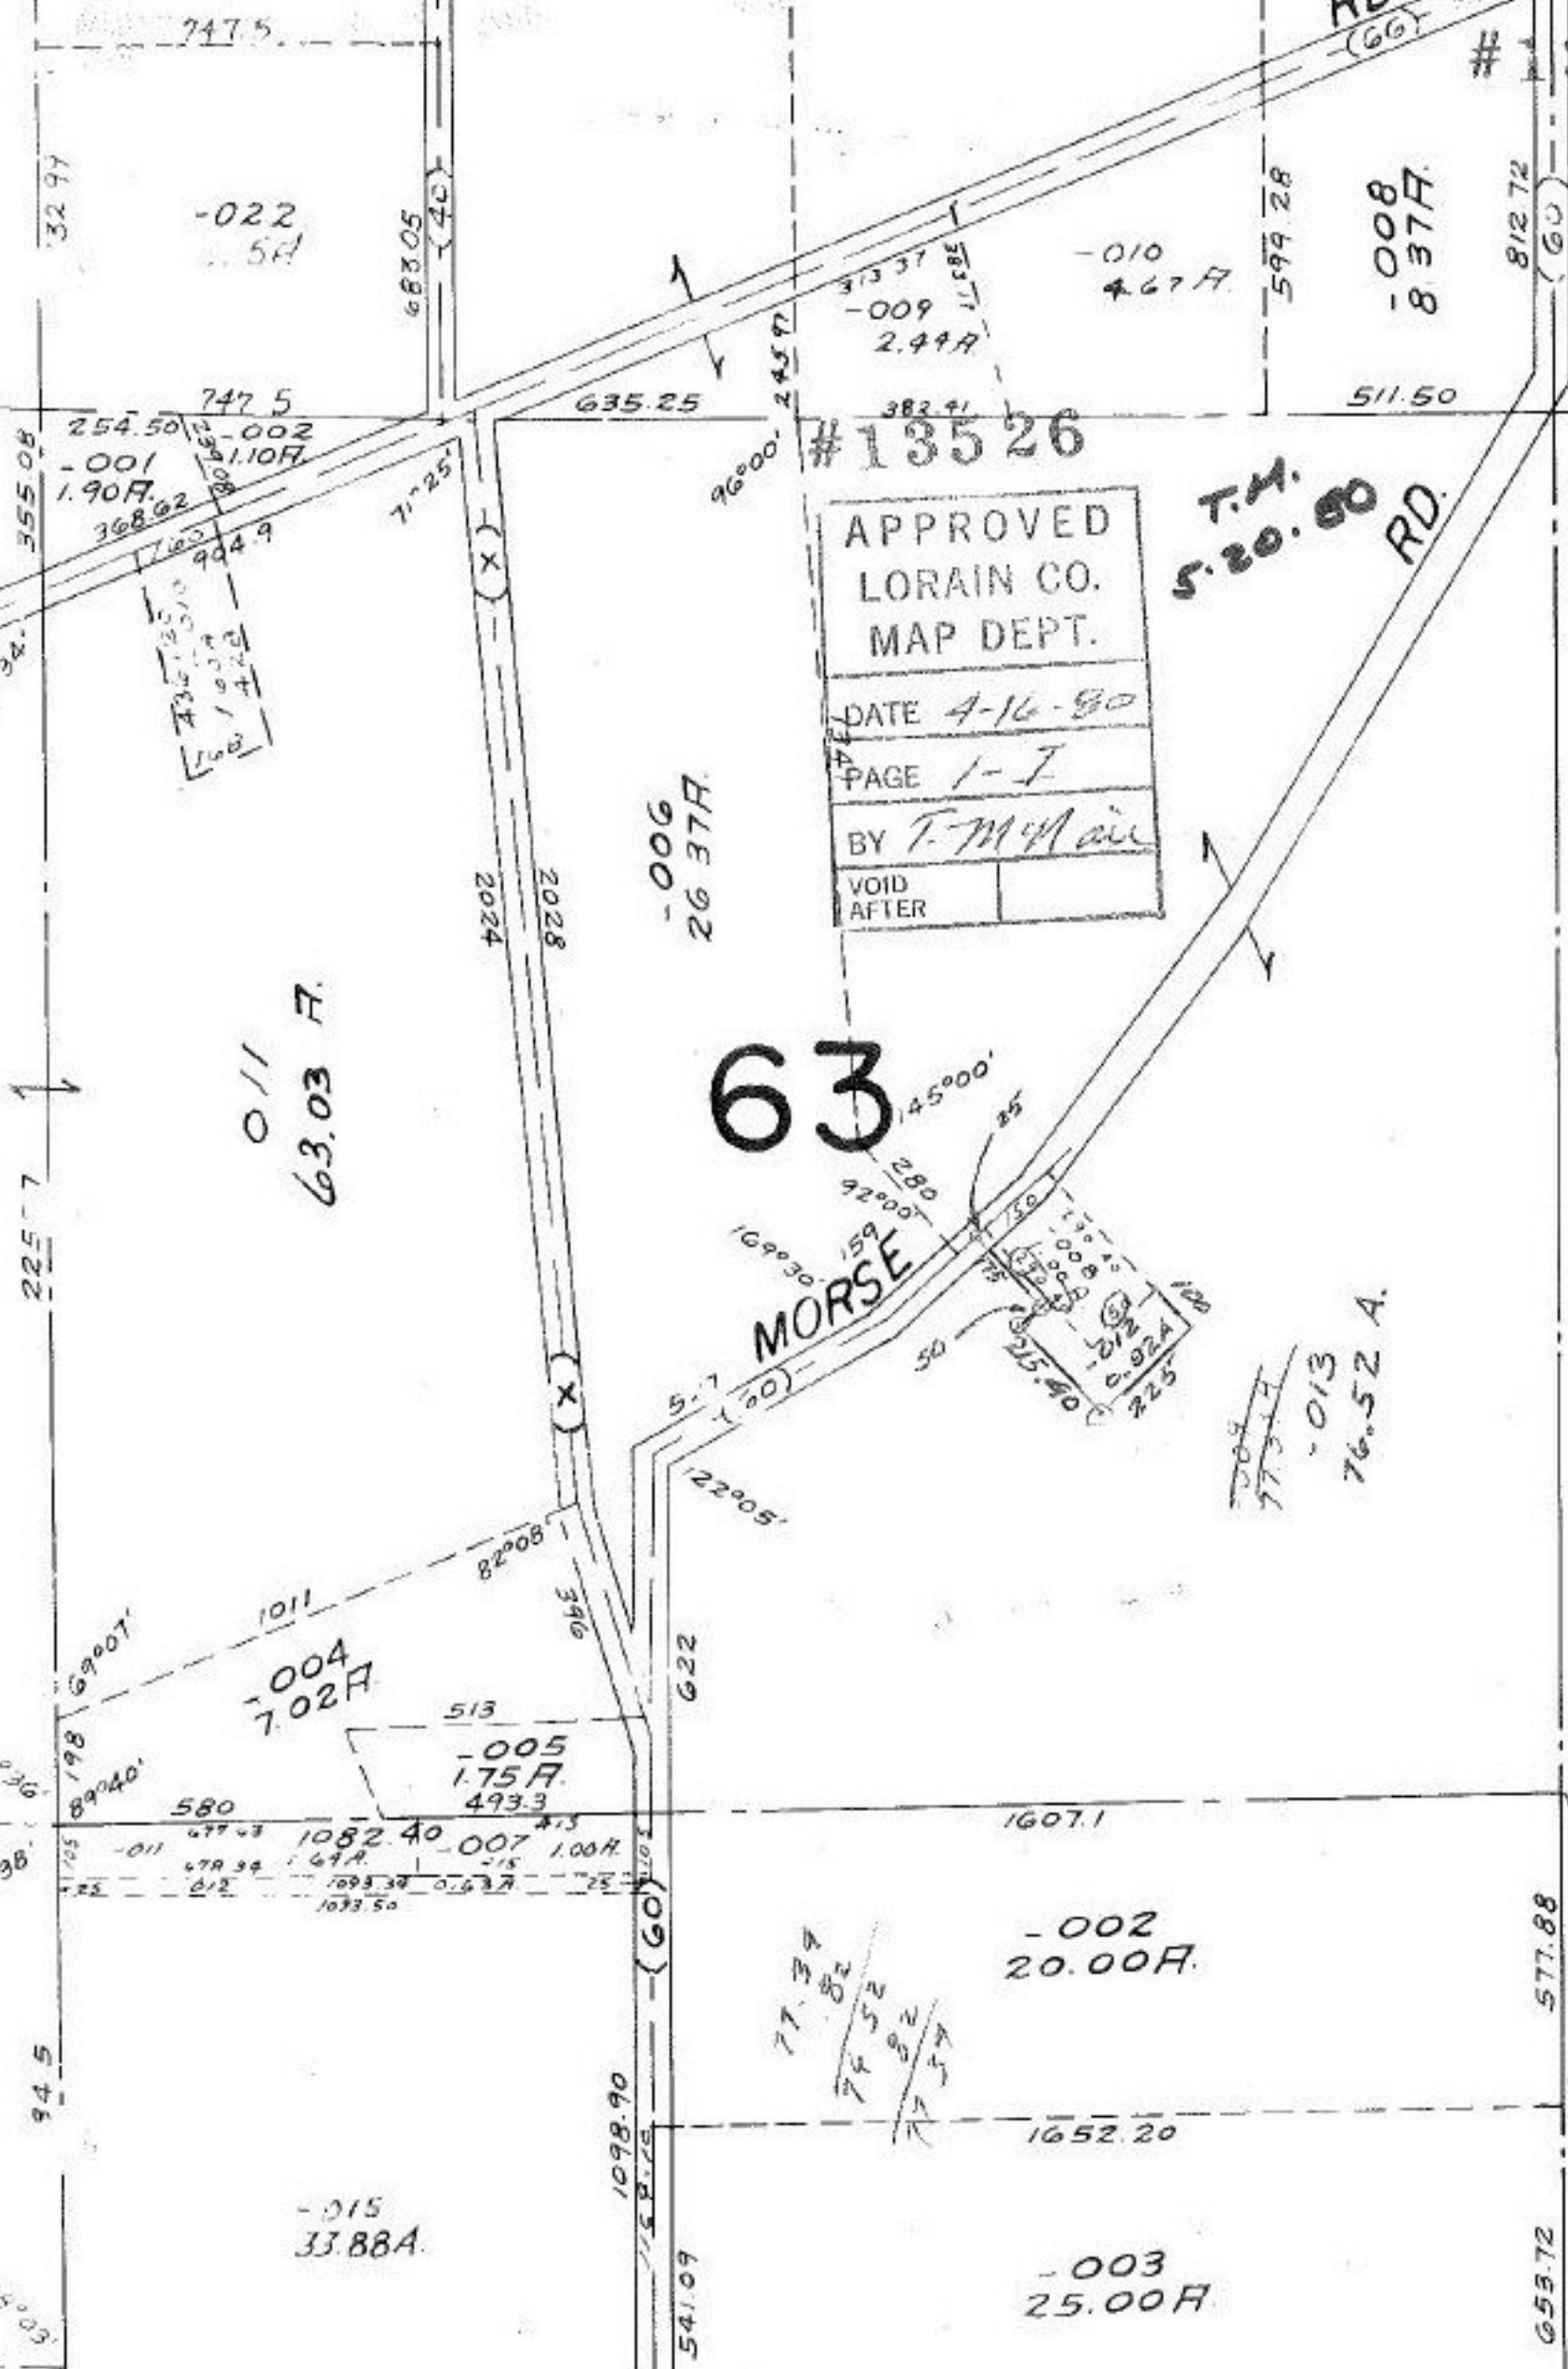

#13526

APPROVED  
LORAIN CO.  
MAP DEPT.

DATE 4-16-80

PAGE 1-1

BY T.M. Main

VOID  
AFTER

63

MORSE

T.M.  
5.20.80  
RD.

~~009~~  
~~77.52~~  
-013  
76.52 A.

0/1  
63.03 A.

-004  
7.02A

-005  
1.75A  
493.3

-002  
20.00A

-003  
25.00A

-015  
33.88A

-006  
26.37A

-010  
4.67A

-008  
8.37A

-009  
2.99A

-022  
5A

710  
100  
70  
70