



-036
6.17A.

1226.4 D.

-005
4.50A.

1372.80
1226.4 D.

1309.85
1224.84

8.01A
13.00
4.00
4.00

#13552

APPROVED.
LORAIN CO.
MAP DEPT.
DATE 4-30-80
PAGE 700-043 A
BY <i>T. M. 80</i>
VOID AFTER


-053
-006
8.01A.
7.20Ac.

T.M. 80
5.30.

1273.53

125.06
11-8-77

-007
6.00A.

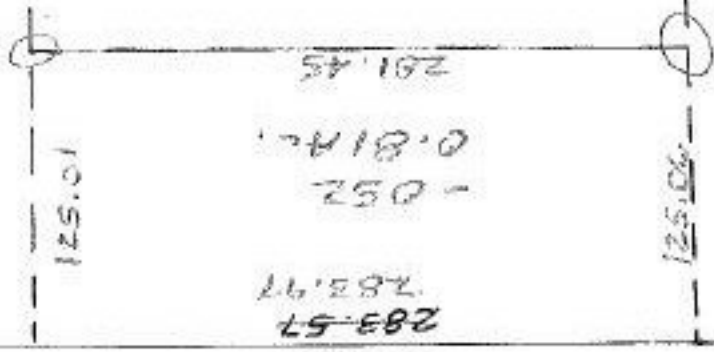

160

283.57
783.97

125.06

207.76

1243.72