

#135

#13565

APPROVED
LORAIN CO.
MAP DEPT.


DATE 5-6-80

PAGE 6-49

BY T. McKain

VDID
AFTER

T.M.
6-9-80

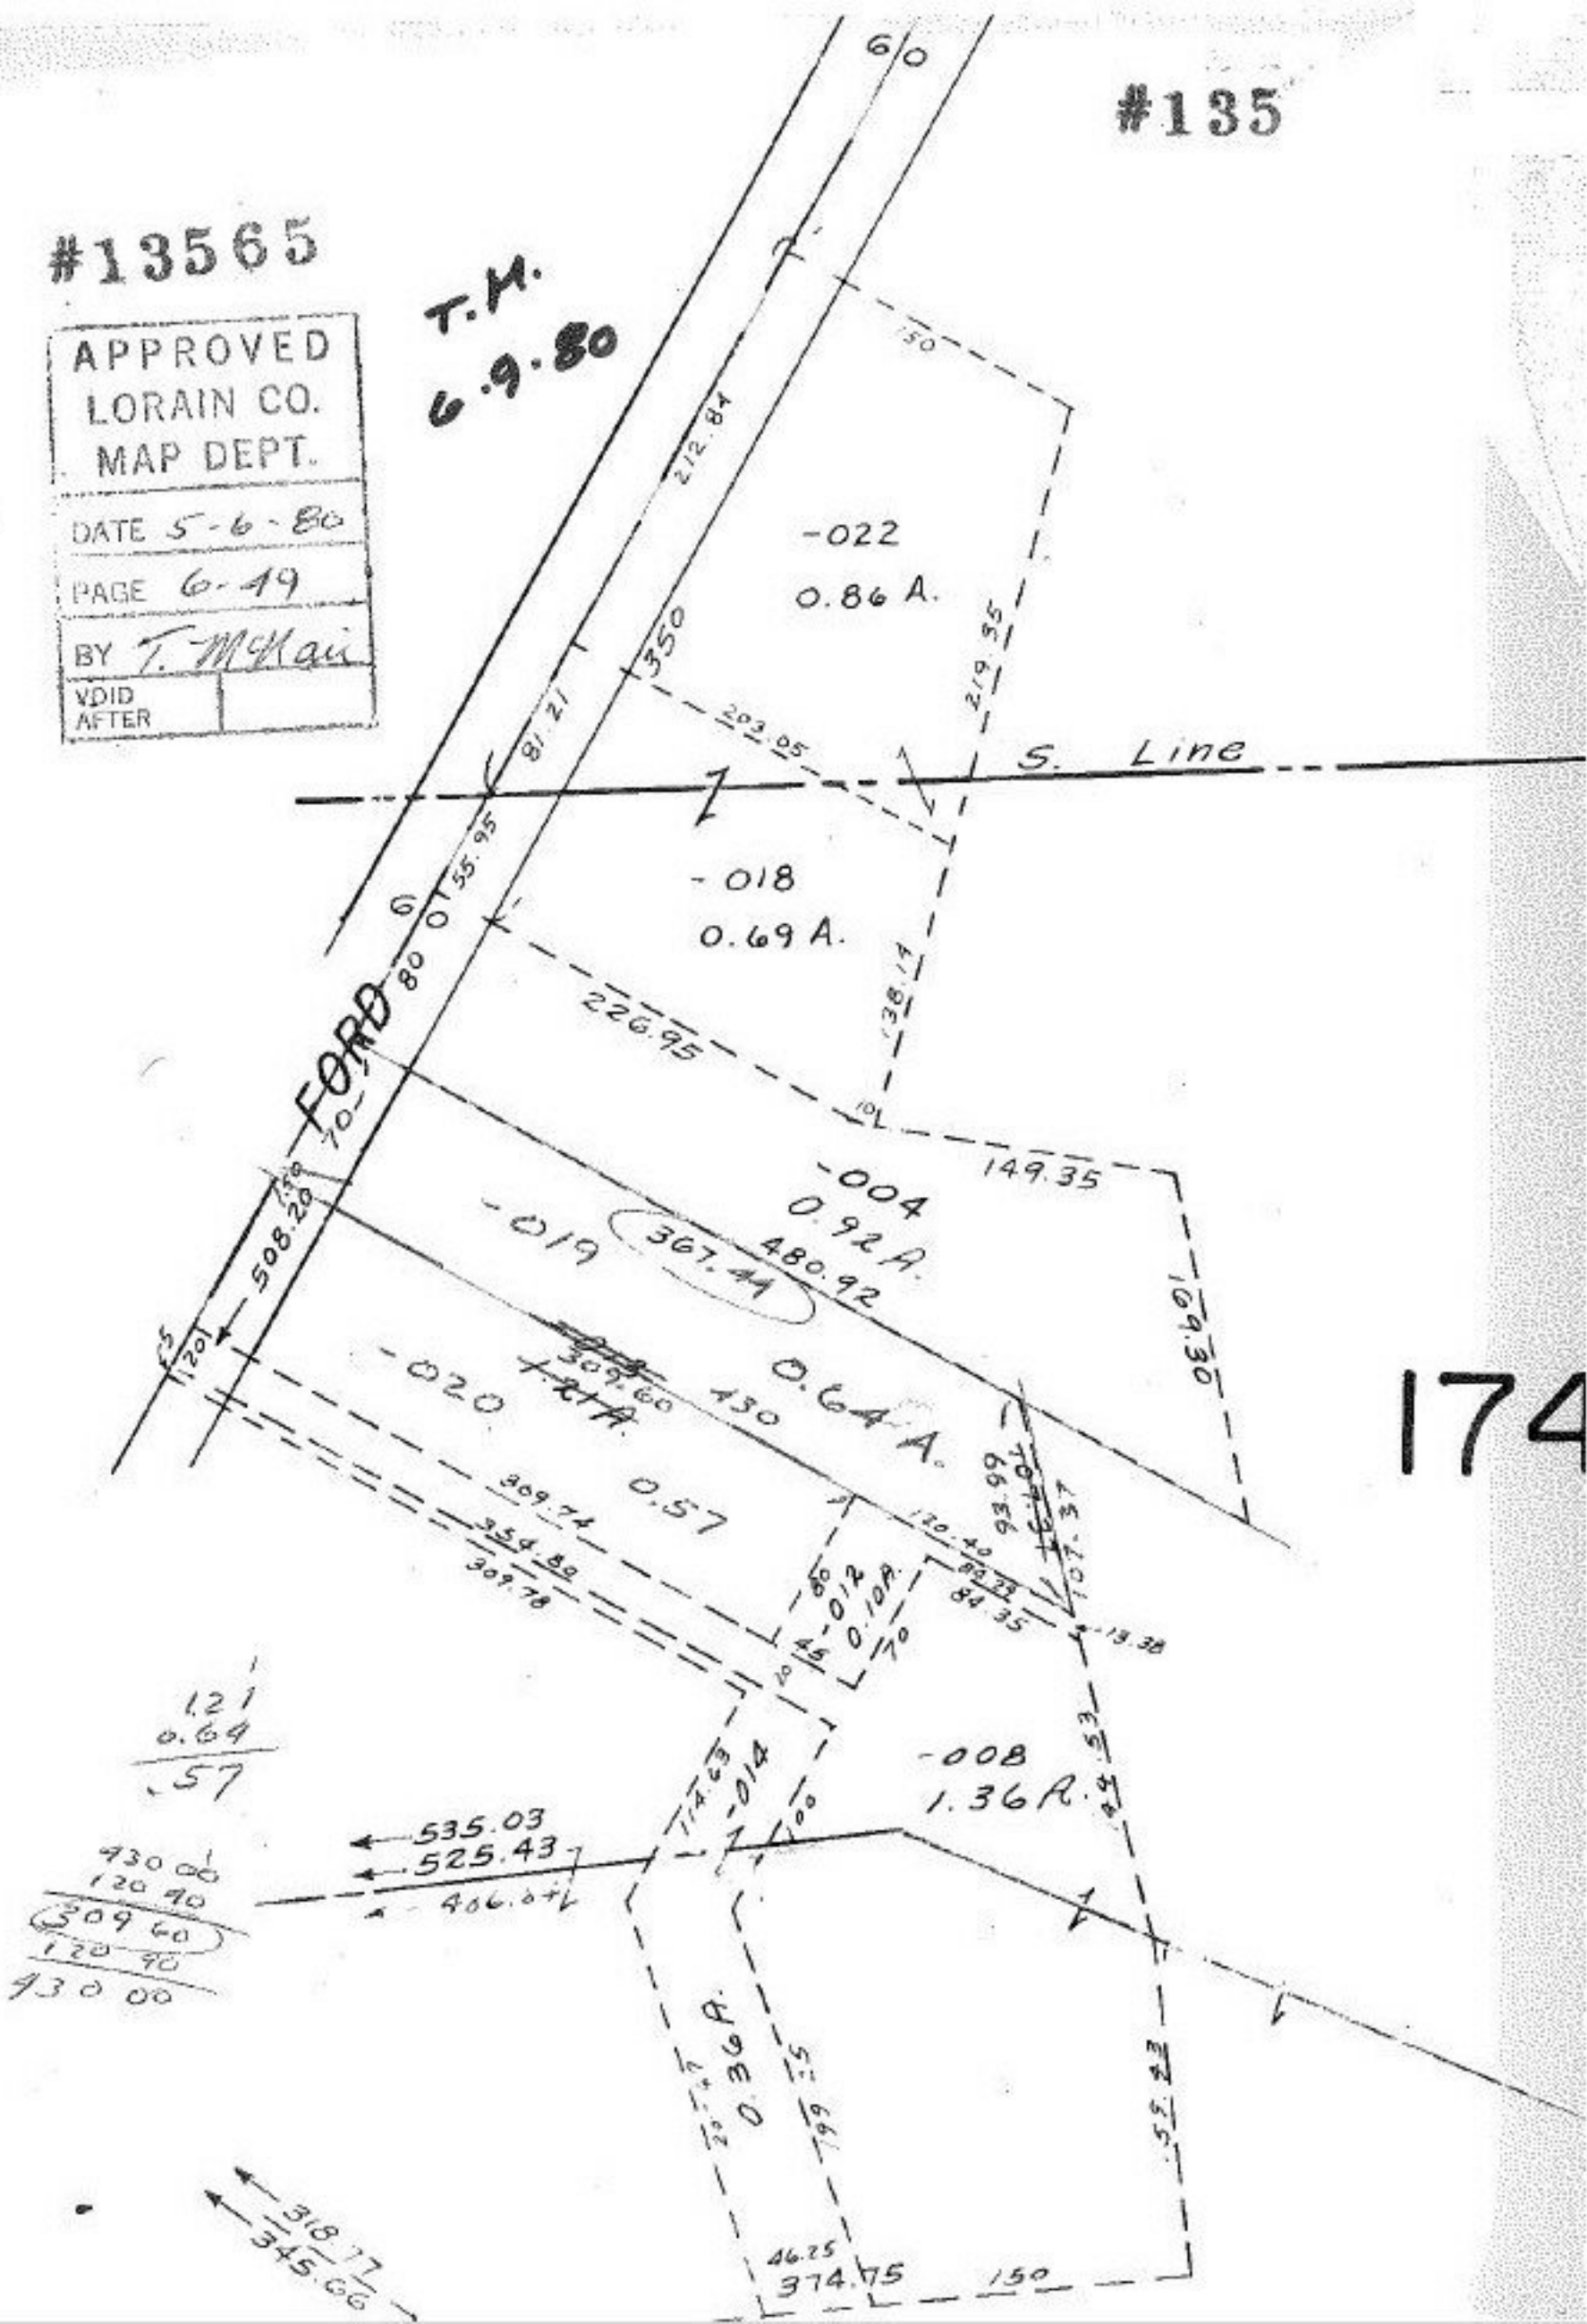

174