


#13573

COMBINATION

CUY

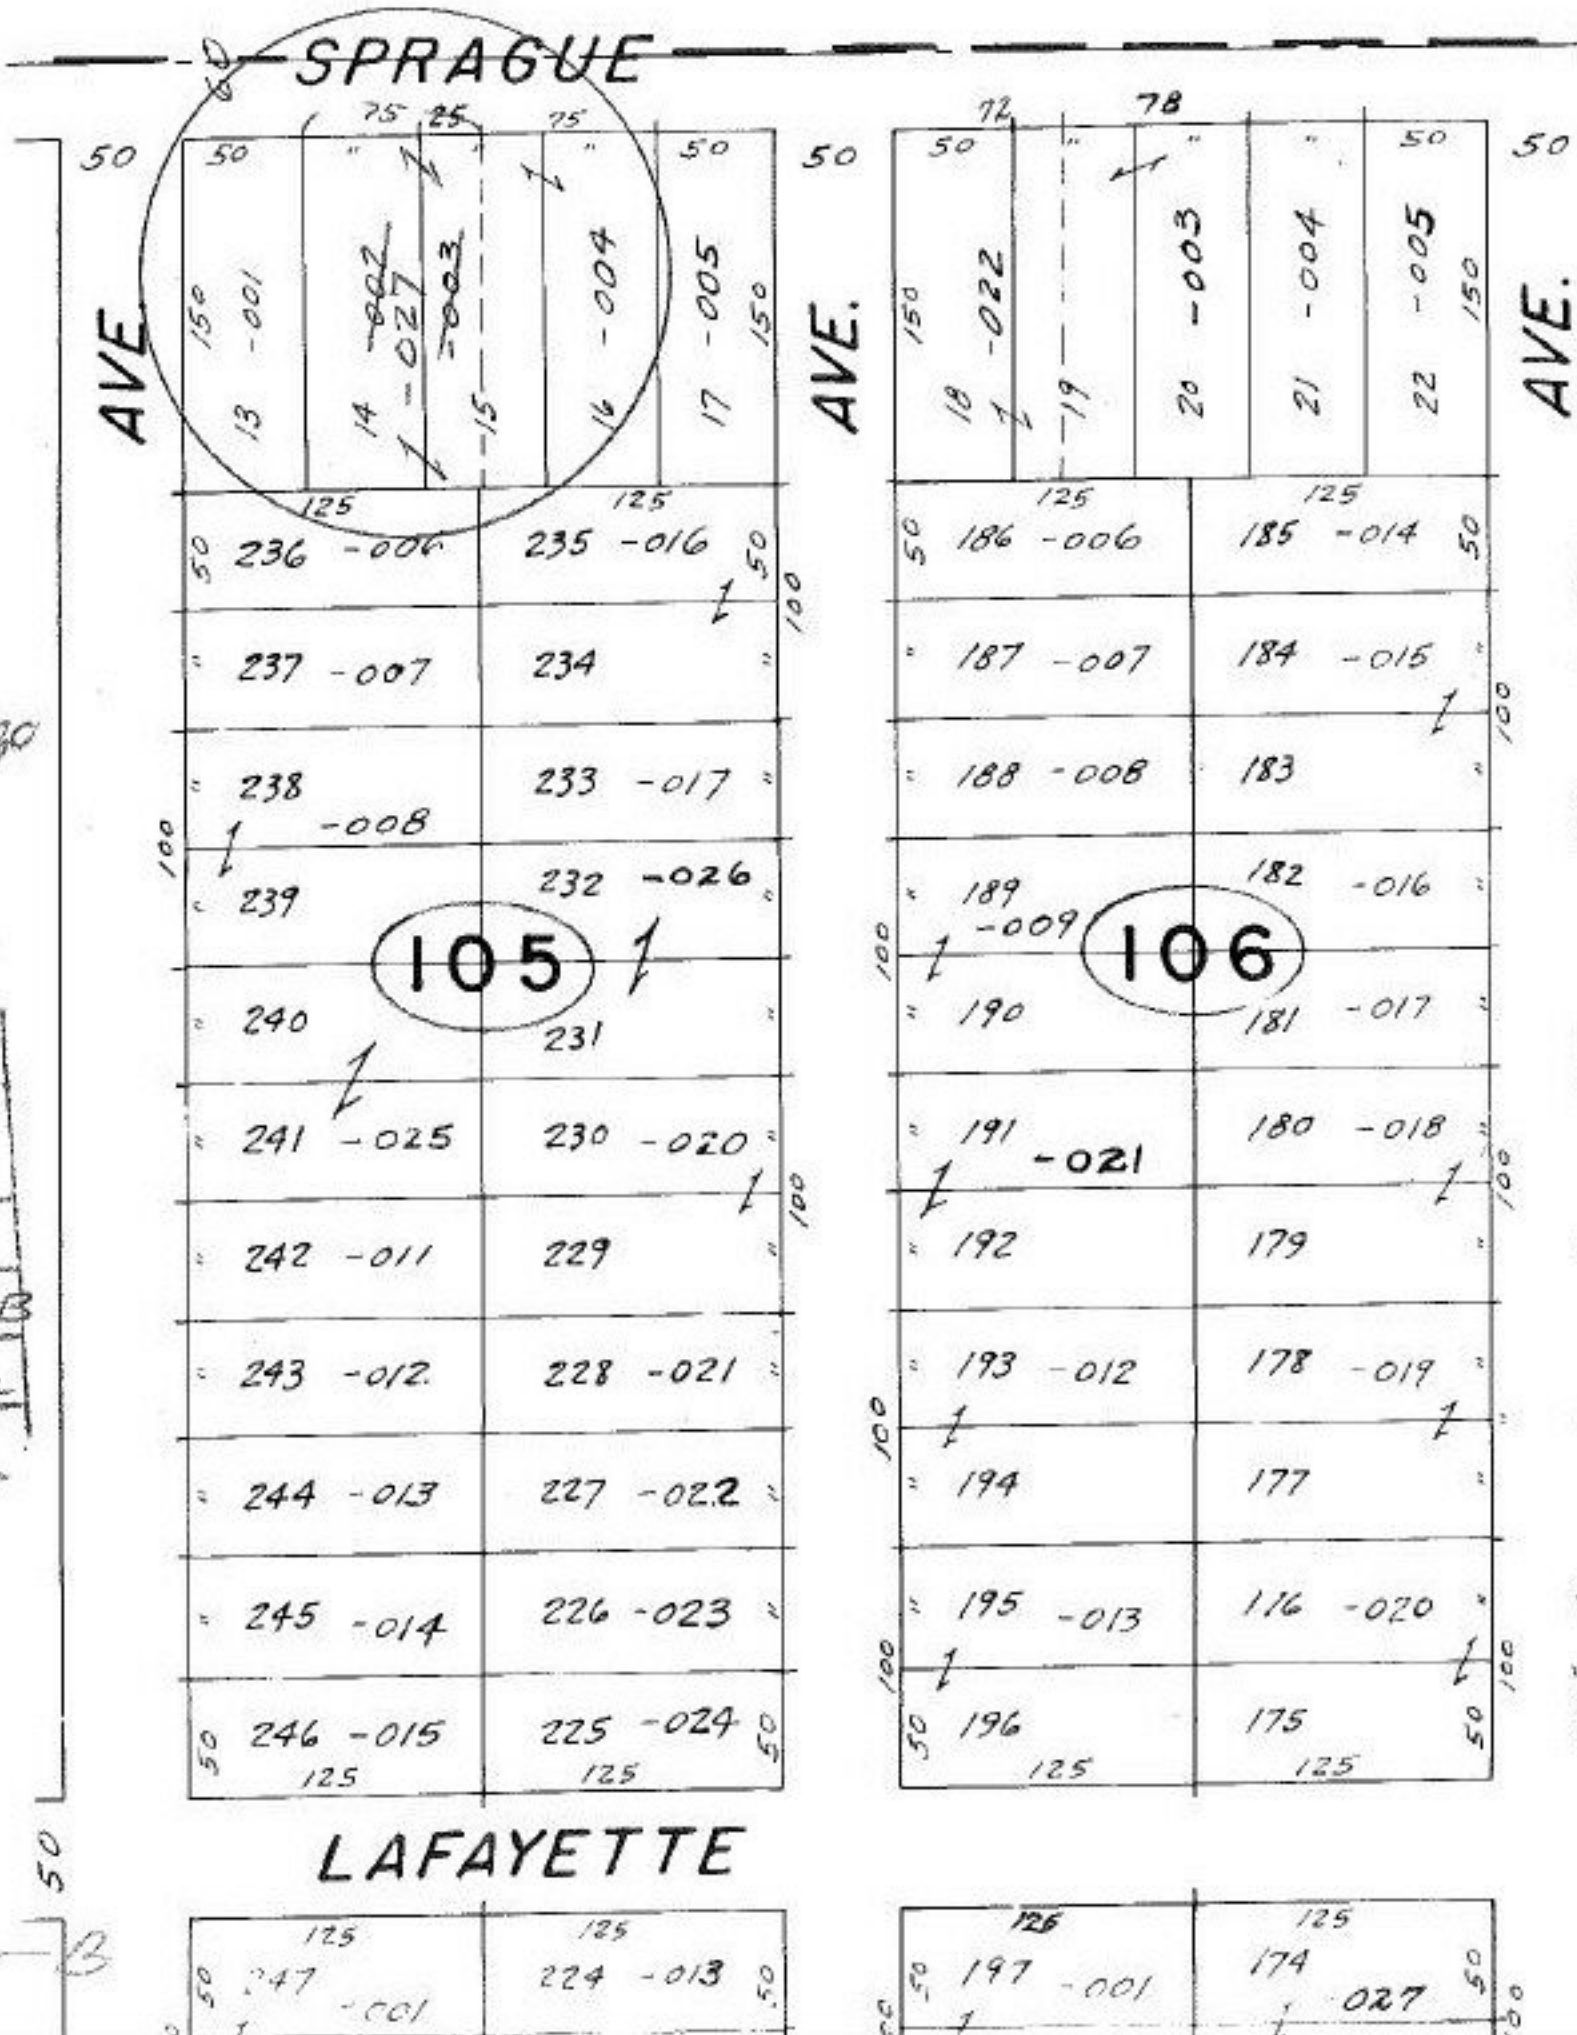

T.M.
7.29.80

#13573

APPROVED
LORAIN CO.
MAP DEPT.

DATE 6.11.80

PAGE 12-00-020-B

BY T. McHale

VOID
AFTER

12-00-020-B