

SEE 7-1

I-COMBINATION

#13573

NEW NUMBER
-169

T.M.
7-28-80

#13573


APPROVED
LORAIN CO.
MAP DEPT.

DATE 6-11-80

PAGE 7-00-017-B

BY T. McNamee

VOID AFTER

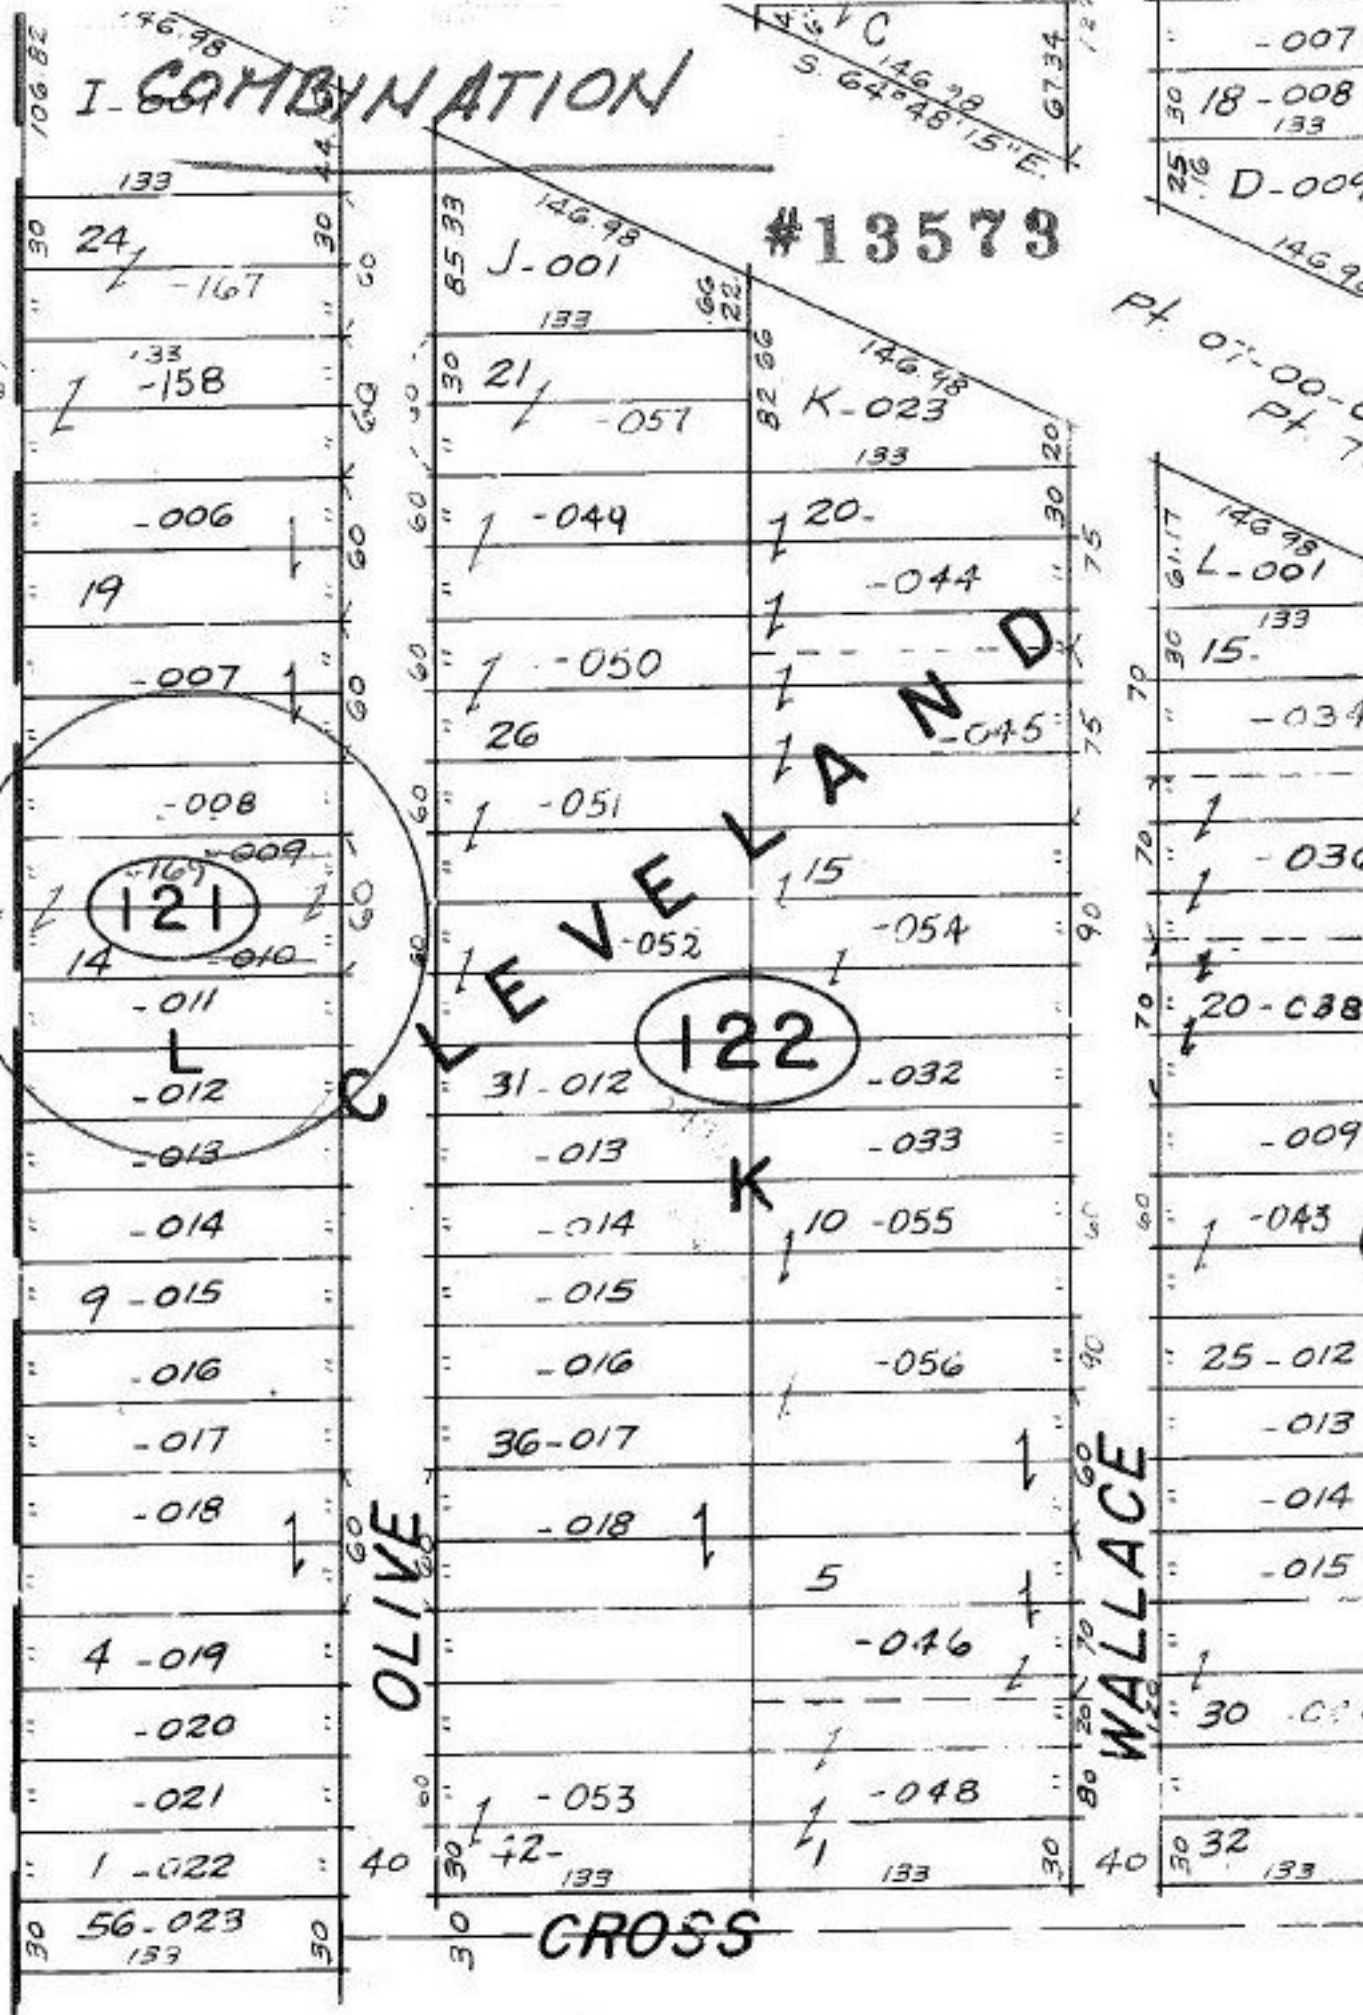

-007
18-008
133

D-009
146.98

Pt. 07-00-0
Pt. 7

L-001
133
15-

-034
-036

20-038

-009
-043

25-012
-013
-014
-015

30-016

32
133

7-00-017-B

RIDGE VI

SCALE: 1" = 100'