


NO. 1

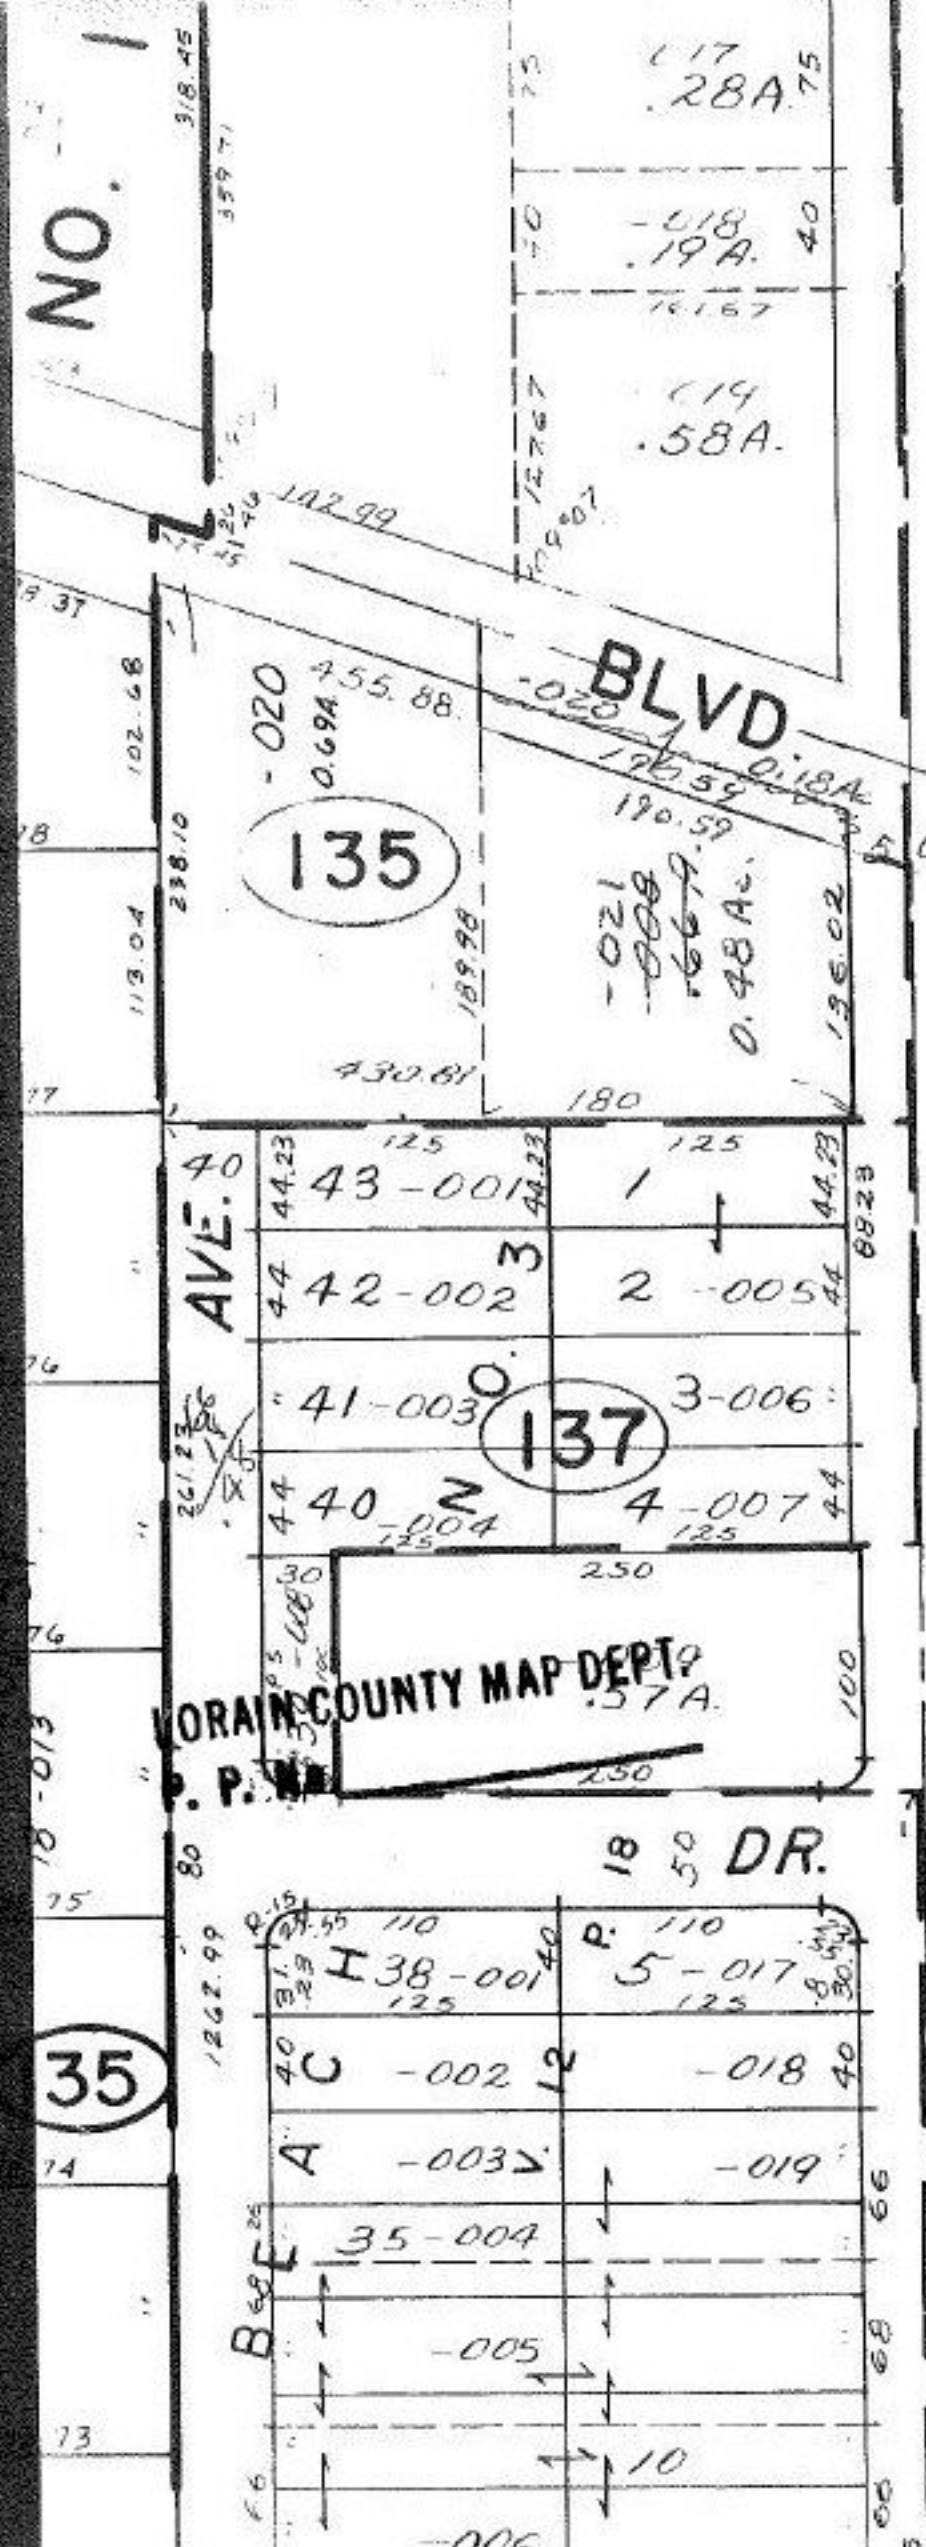

SEE 4-00-03

4-00-019-D

#13585

APPROVED
LORAIN CO.
MAP DEPT.

DATE 5-15-80

PAGE 4-00-019D

BY *J. Albert*

VOID
AFTER

T.M.
7-23-80