


#13613

JASON

DR.

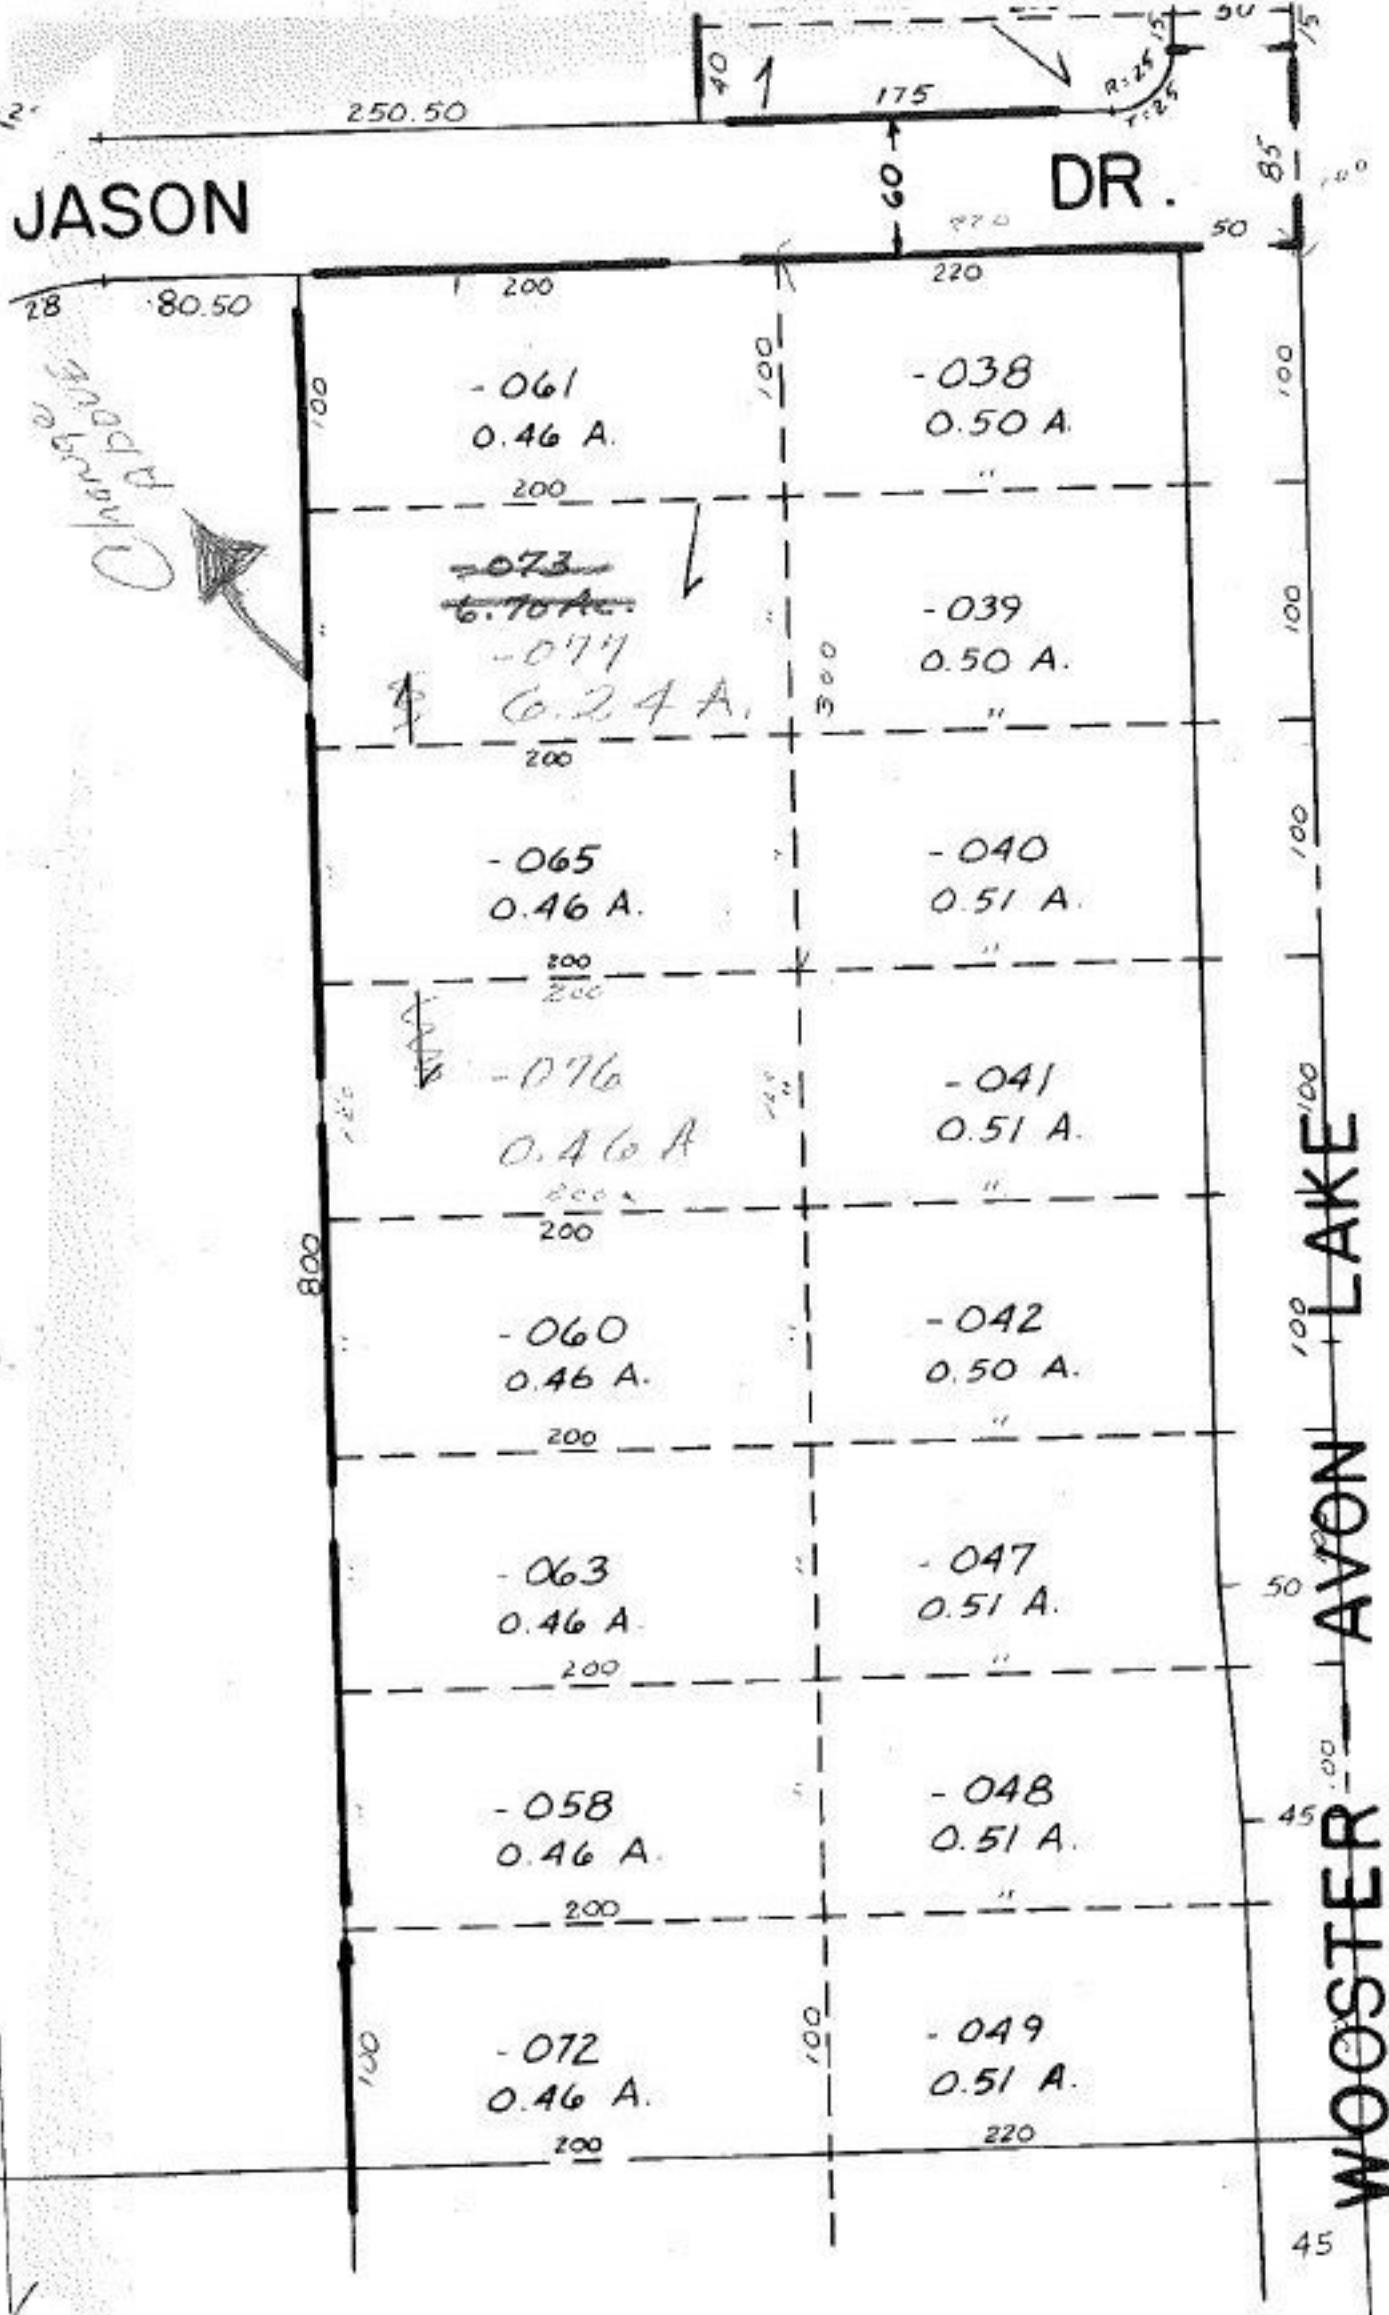

WOOSTER AVON LAKE

7-25-80

#13613

APPROVED LORAIN CO. MAP DEPT.	
DATE	5-30-80
PAGE	11-00-051-8
BY	Carlynn 4
VOID AFTER	13613