



SEE 6-59

TWP

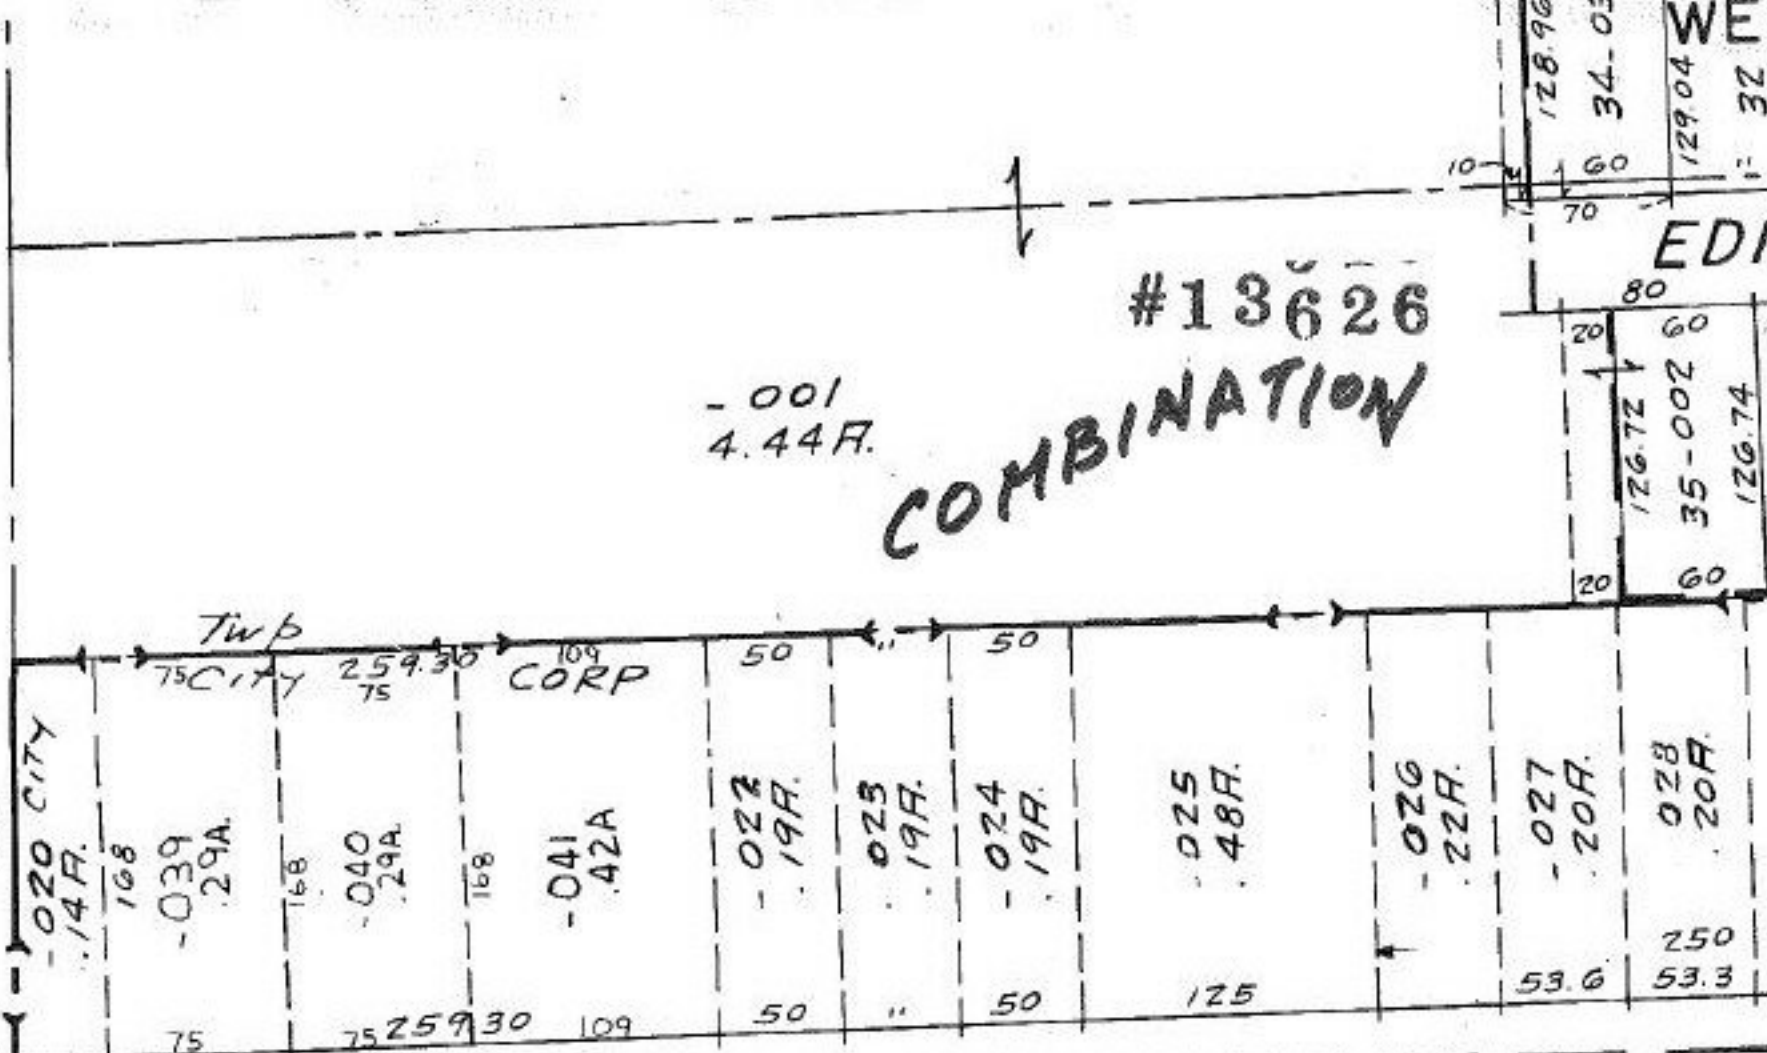

SAMUEL

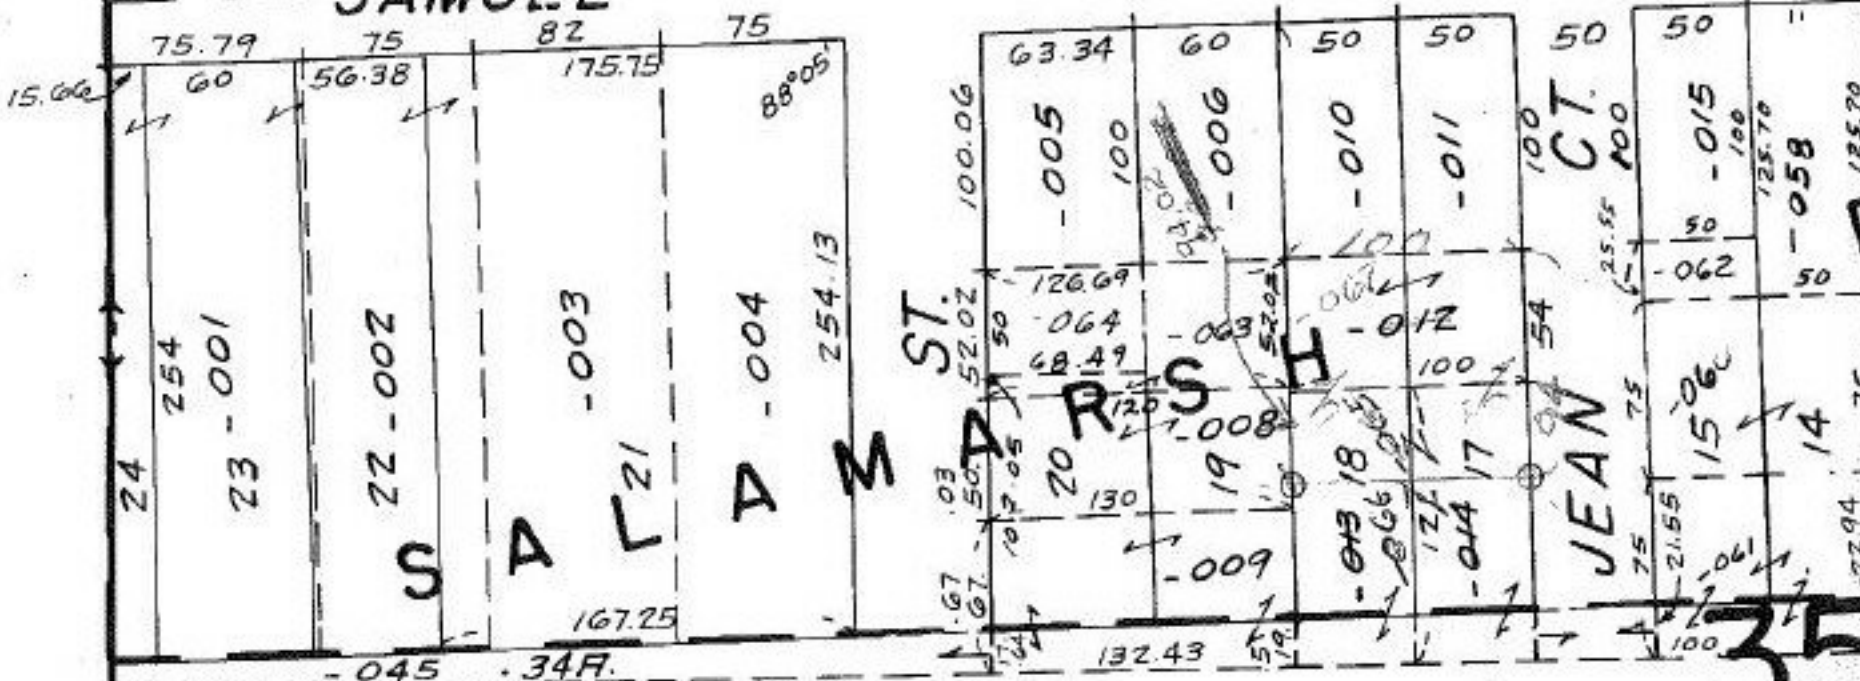

LINE

491.45

#13626

APPROVED LORAIN CO. MAP DEPT.	
DATE	10-5-80
PAGE	10-60B
BY	Cassidy H
VOID AFTER	13626

T.M.
6-10-80

102

Pt. - 05
Pt. 16.