


#13643

ACREAGE CORRECTION

-008
 2.33 A.
 548.50
 -00 #13643
 1.21 A
 T.M.
 7.25.80 528.45
 APPROVED.
 LORAIN CO.
 MAP DEPT.
 DATE 6.18.80
 -039
 1.55 A PAGE 5.00.014-A
 BY T.M. [Signature]
 VOID []
 []

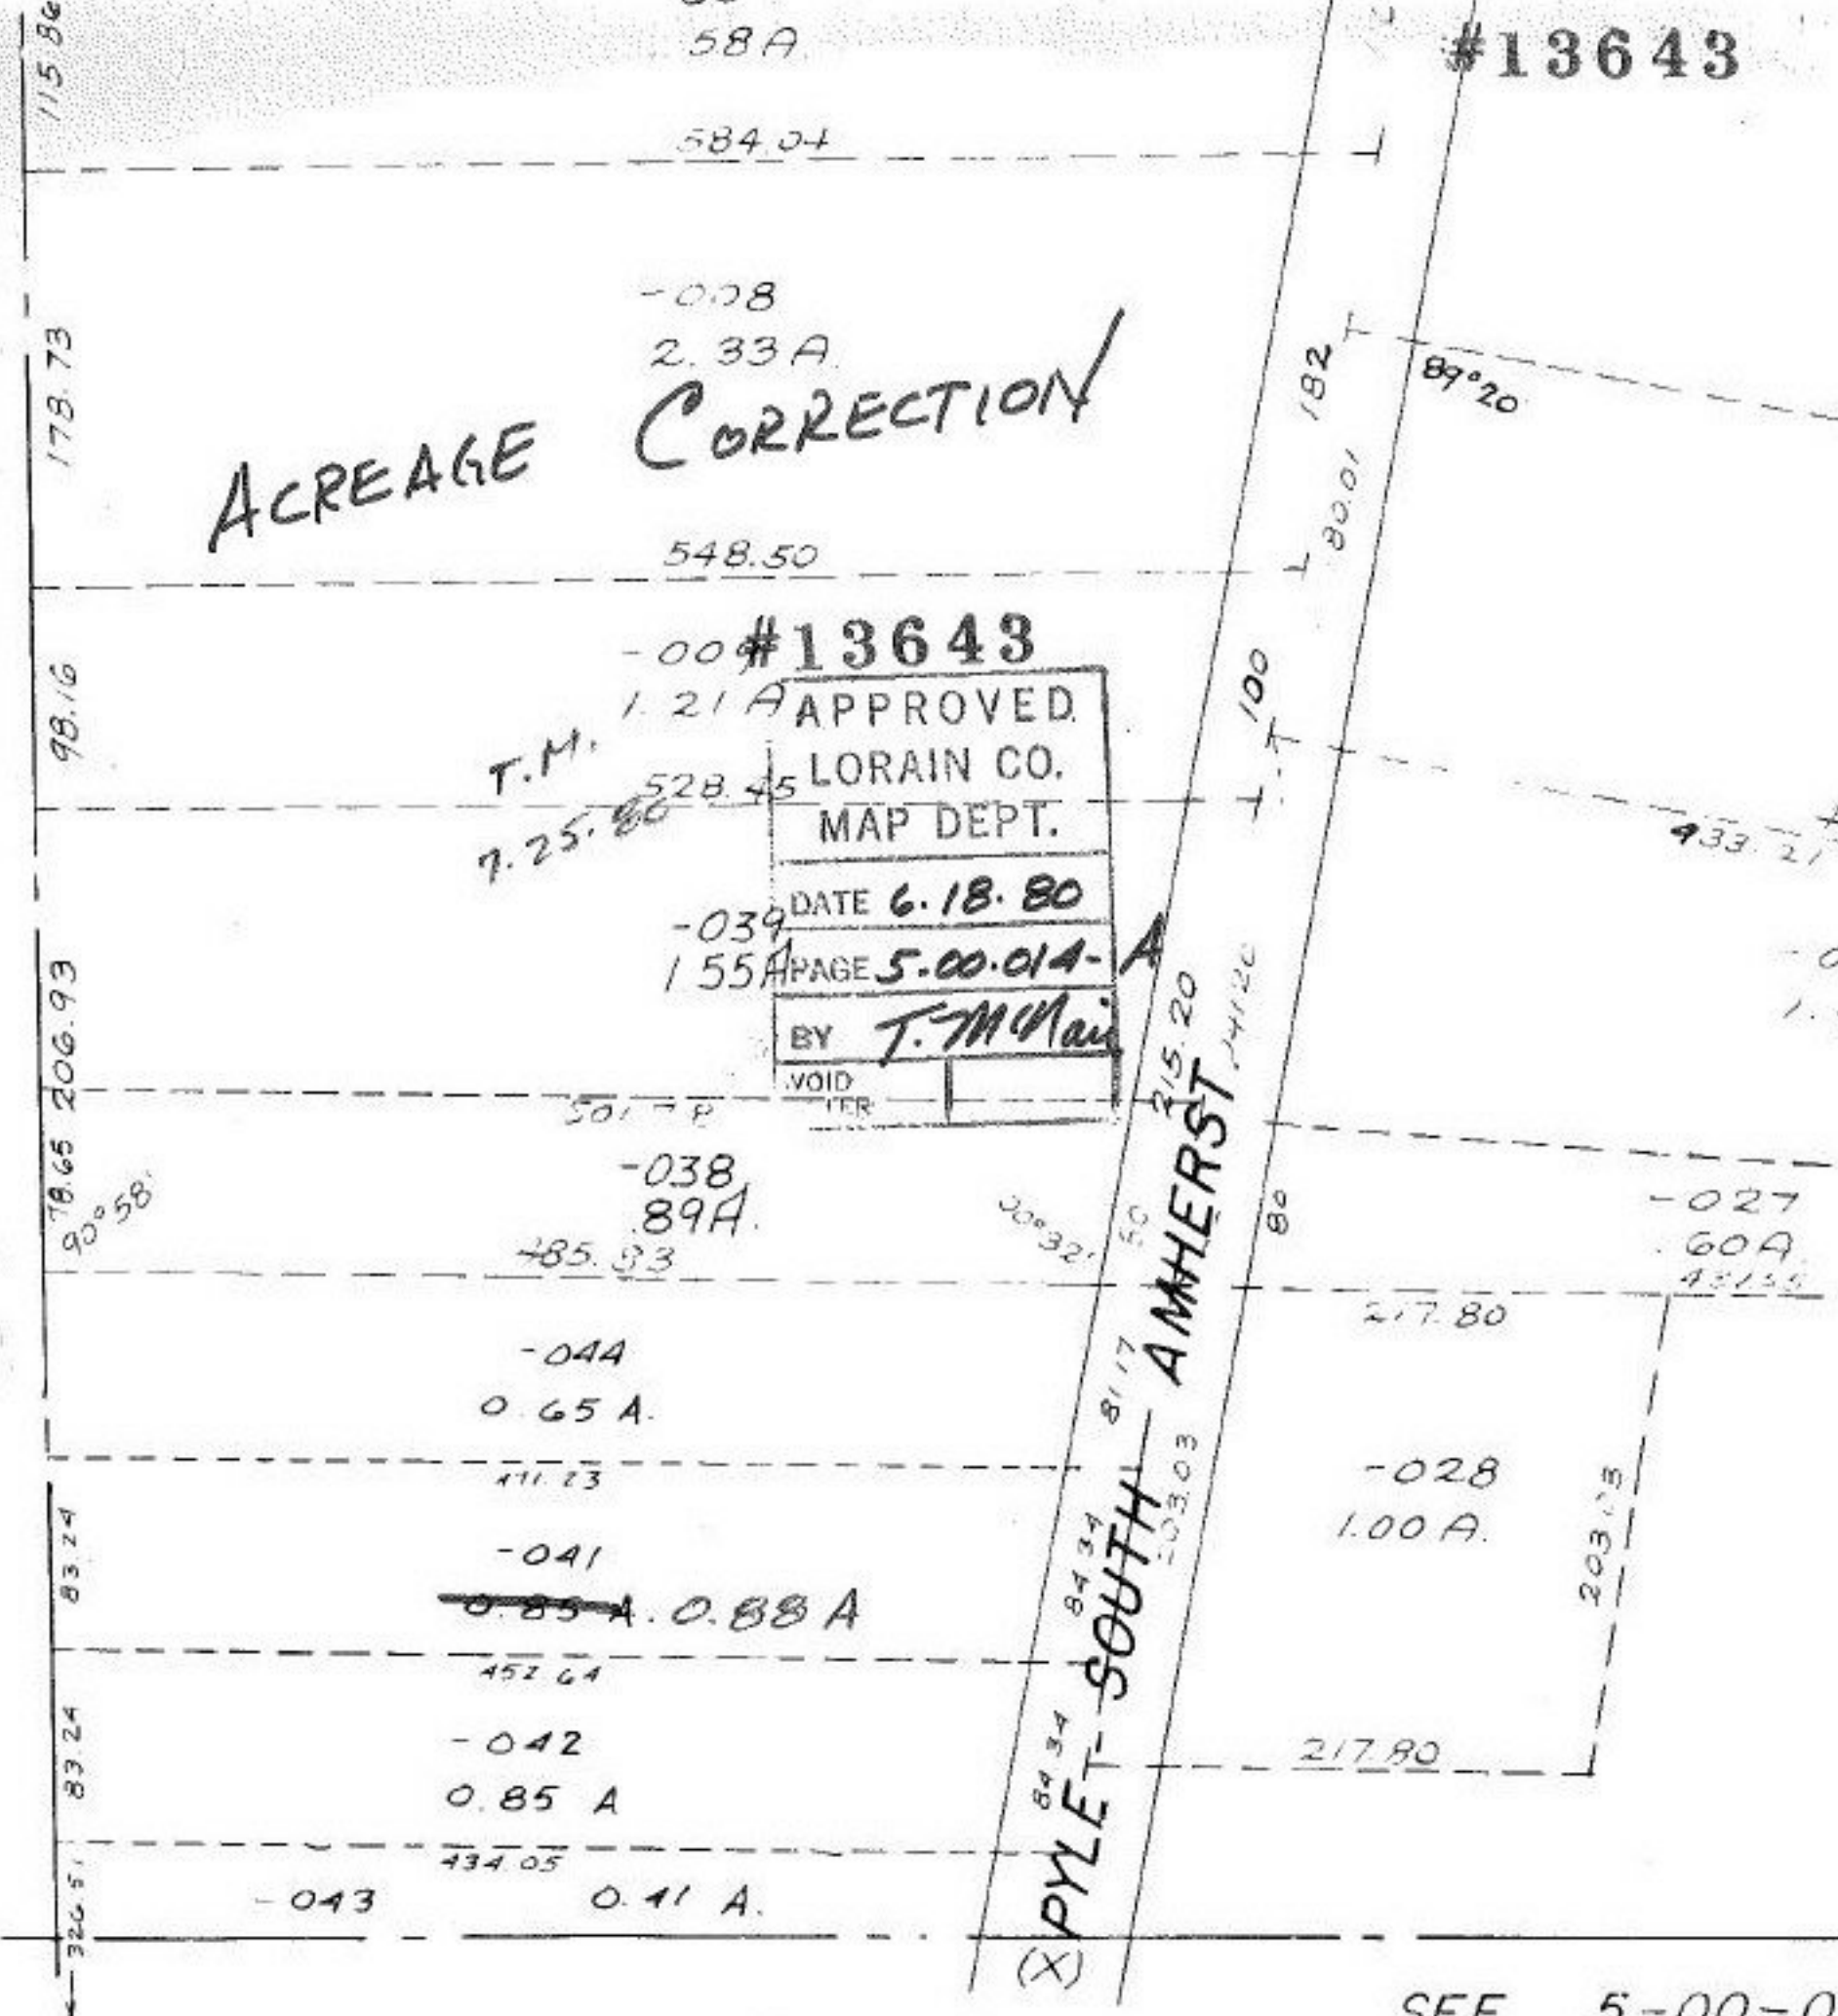

PER DEED

1260/463

SEE 5-00-01

AMHERST TWP.

SCALE: 1" = 100'