


#13647

GRISWOLD

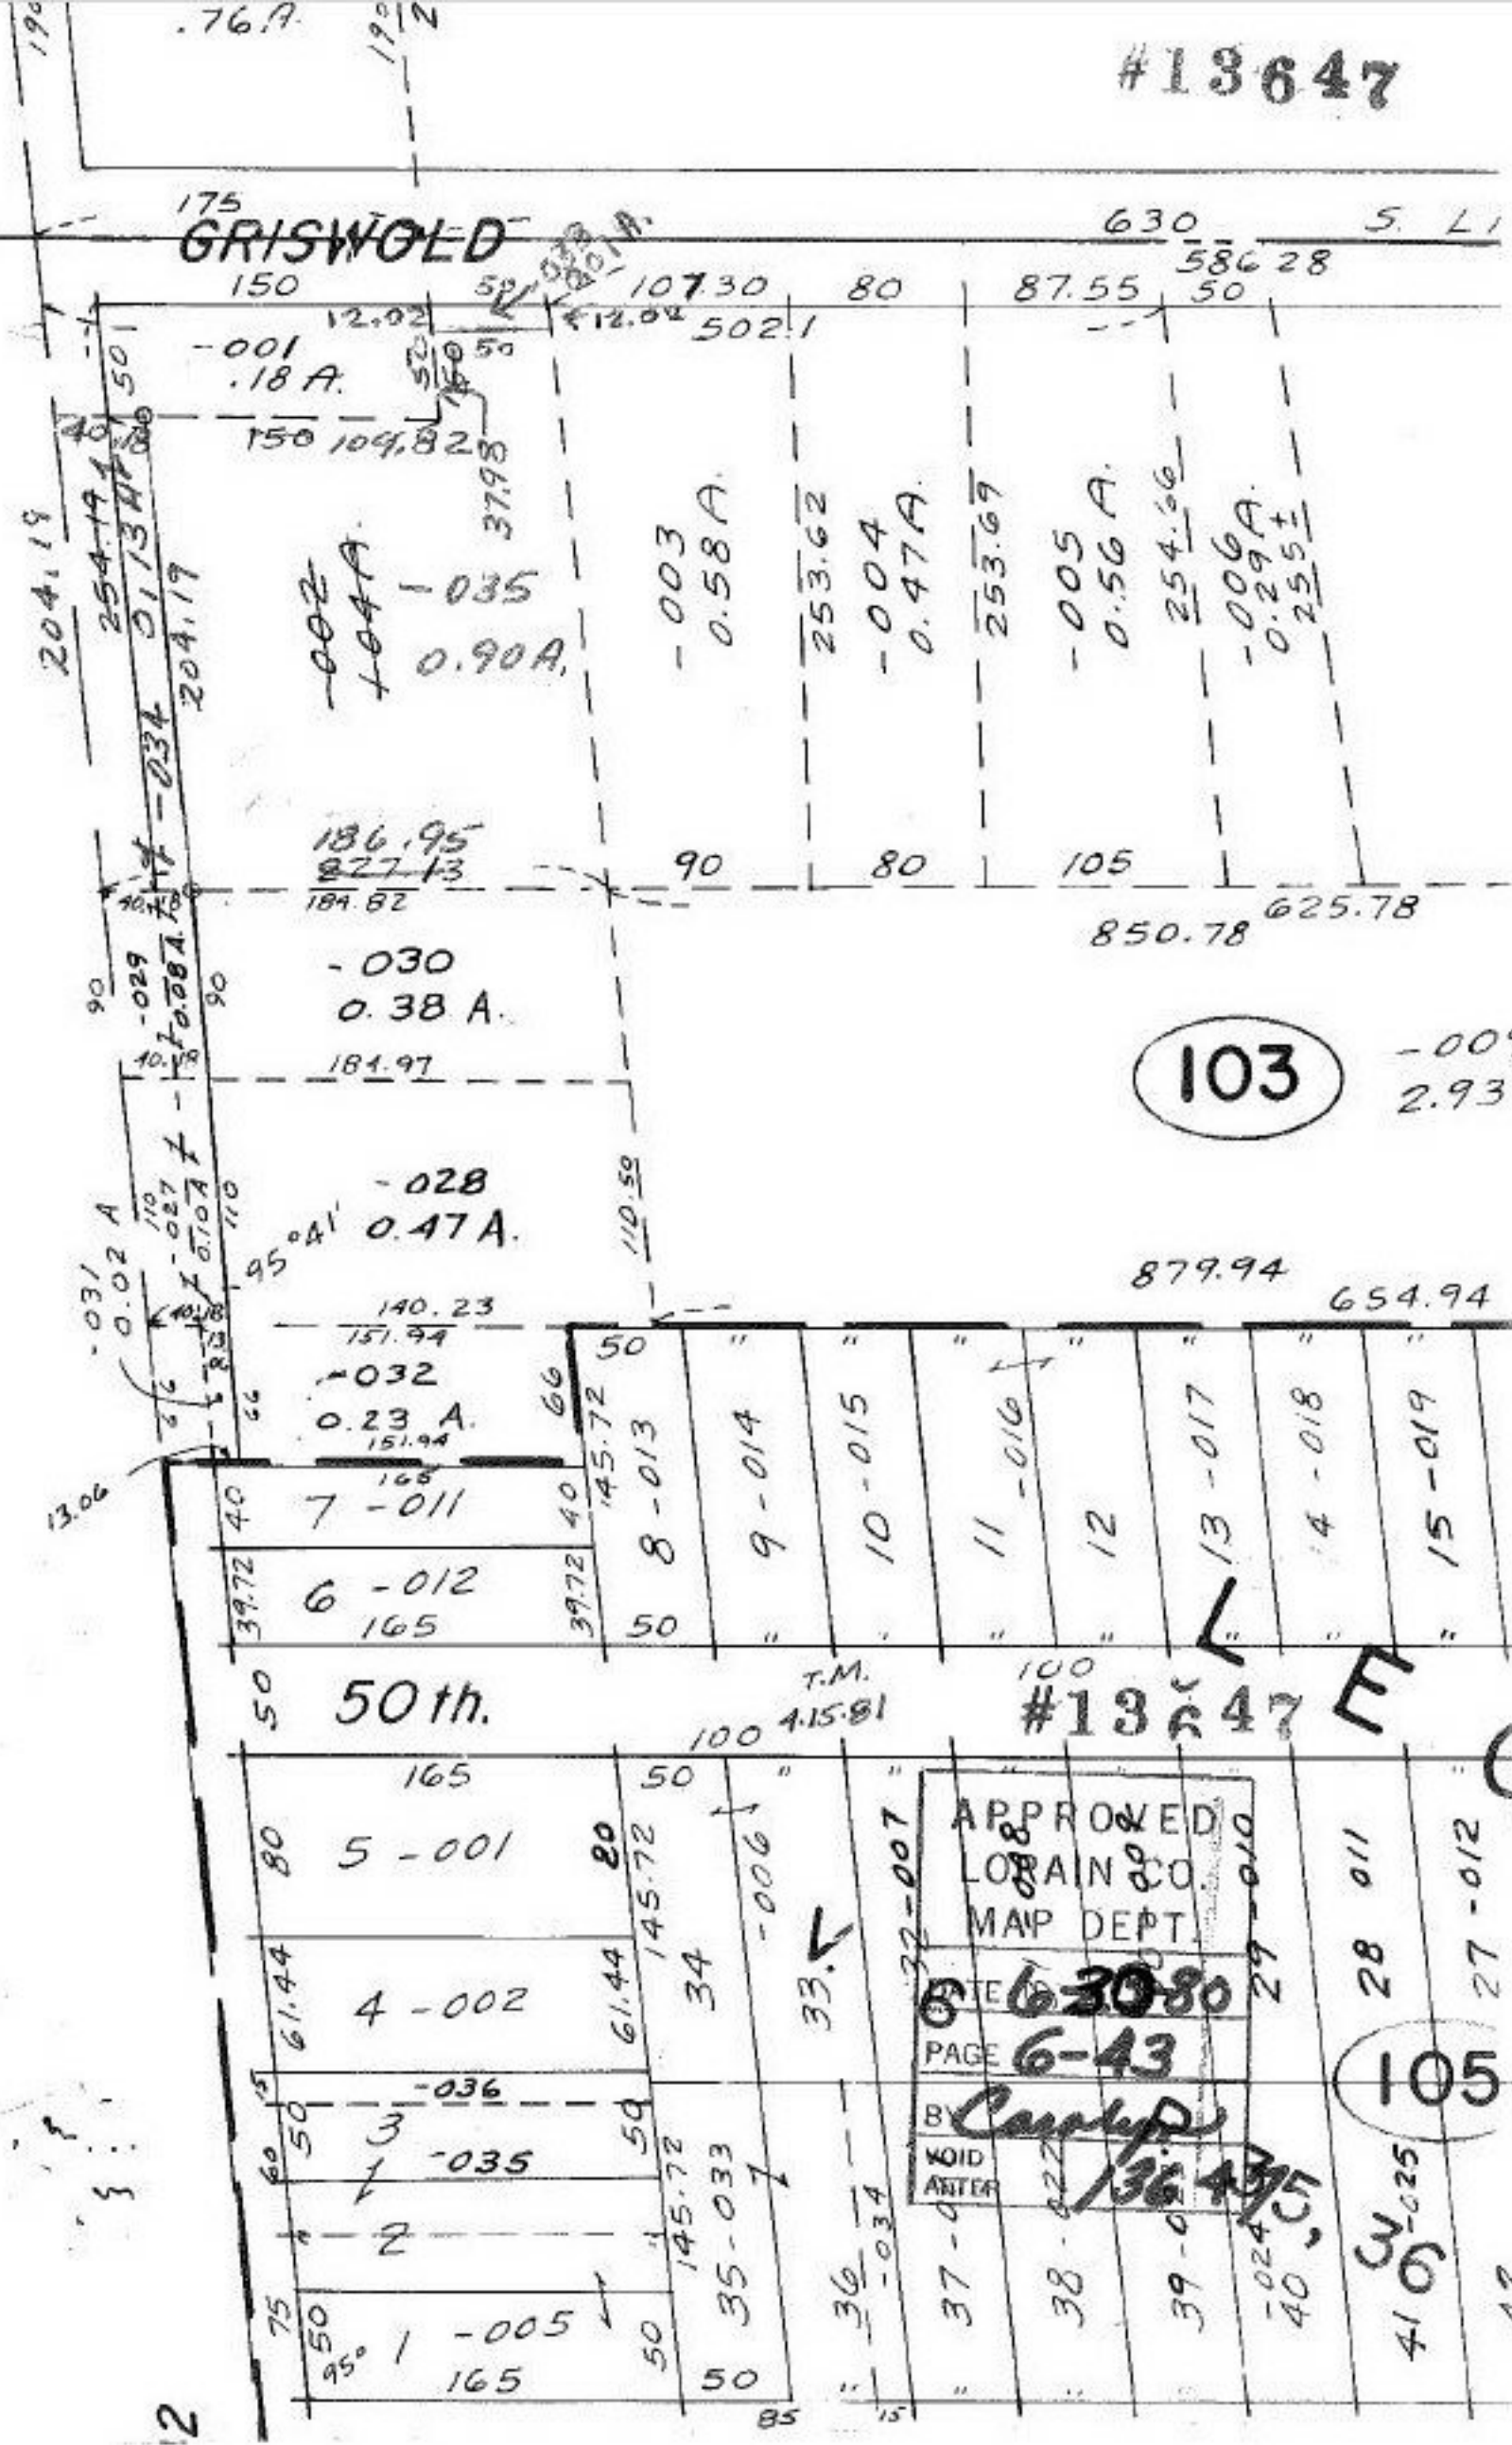

103

50th.

#13647

APPROVED
 LOAN CO.
 MAP DEPT.
 DATE 6-30-80
 PAGE 6-43
 BY *Curlyp*
 VOID AFTER 3643

105

4105-025