


W

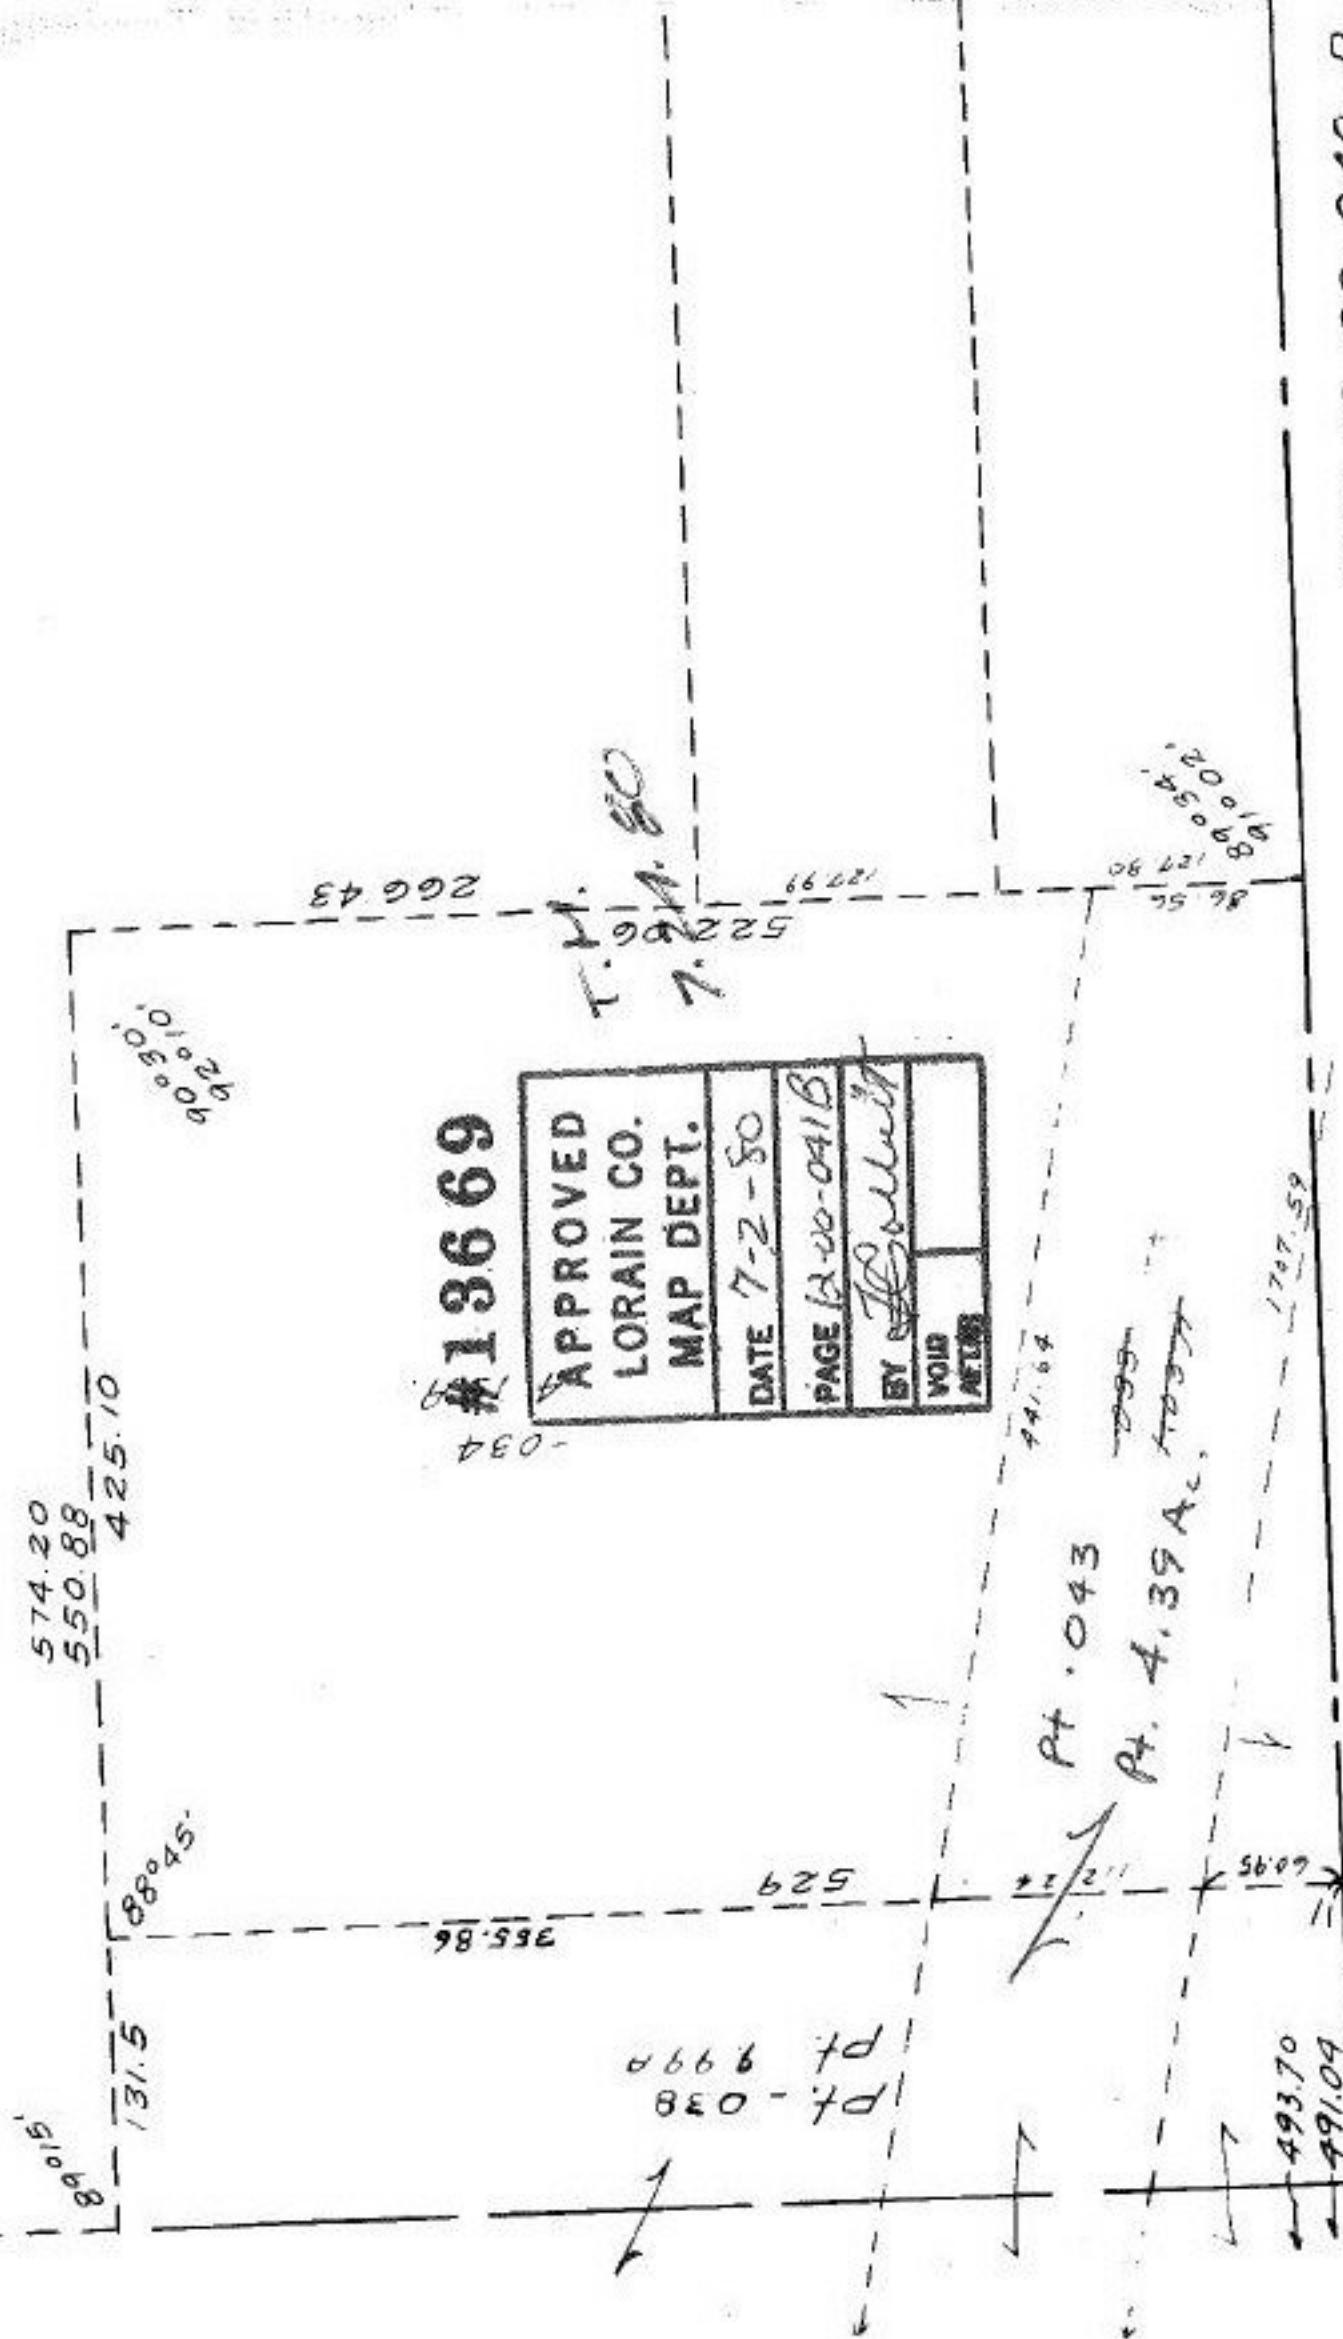

#13669

APPROVED	
LORAIN CO.	
MAP DEPT.	
DATE	7-2-80
PAGE	12-00-041B
BY	J. J. Corbett
VOID	
REUSE	

SEE 12-00-042-B

COLUMBIA TWP.

SCALE: 1" = 100'

EI