


SEE 3-

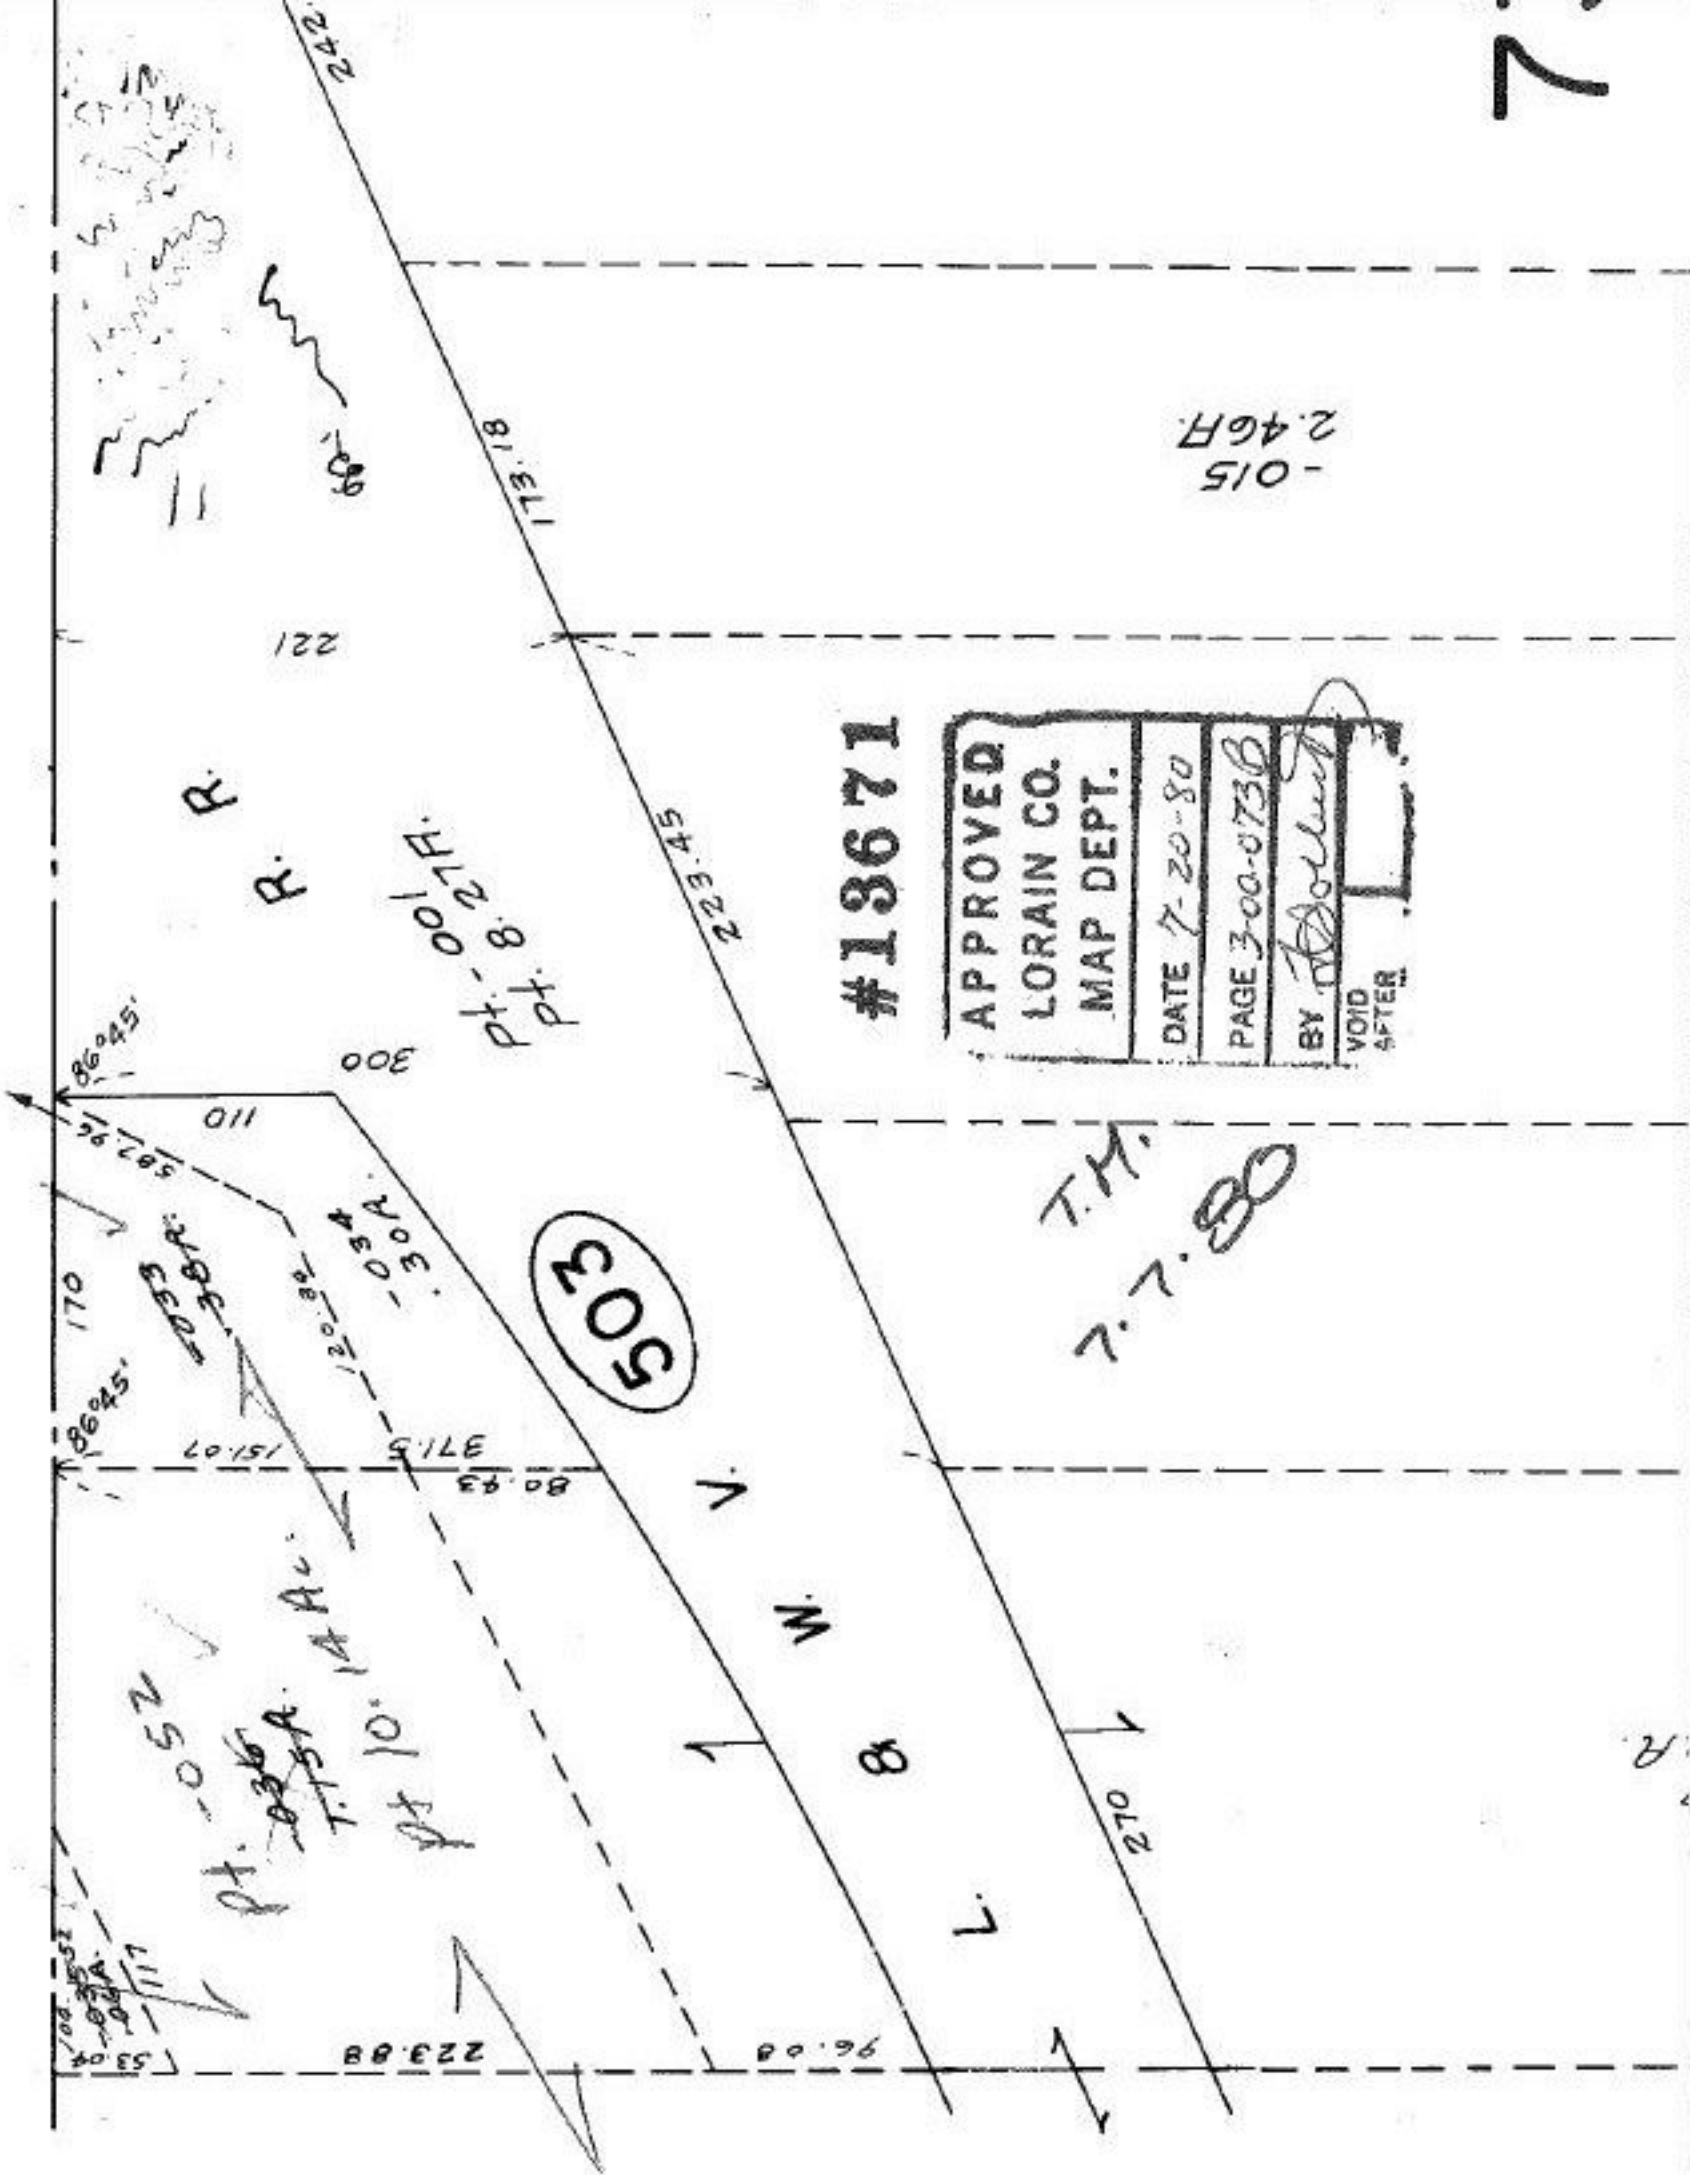

#13671

APPROVED  
 LORAIN CO.  
 MAP DEPT.

DATE 7-20-80  
 PAGE 3-00-073B  
 BY [Signature]  
 VOID AFTER [Signature]

503

T.M.  
7.7.80

3

7