


0-00-004-A

3-00-003-A

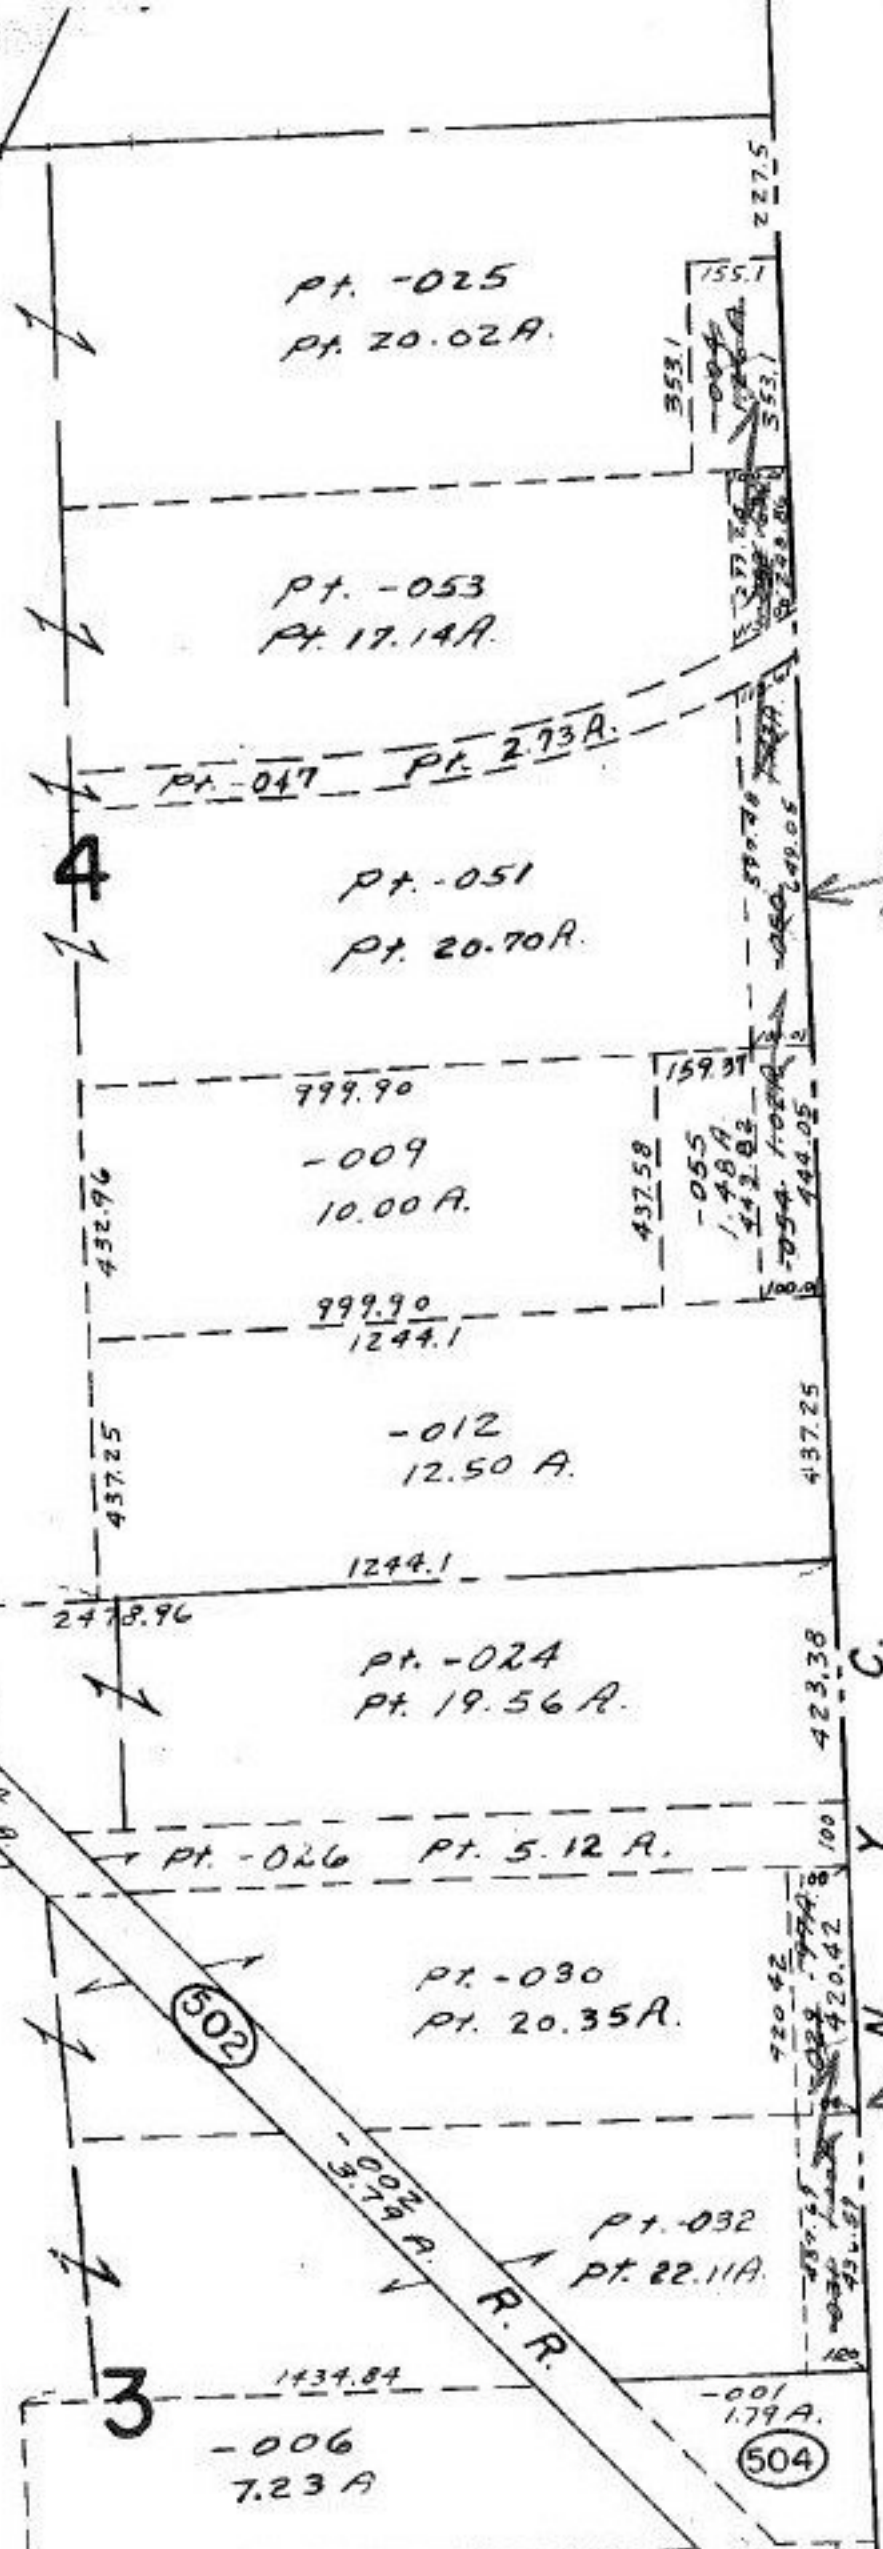

#13671

APPROVED
LORAIN CO.
MAP DEPT.
DATE 7-2-80
PAGE 3-L
BY <i>J. Barber</i>
VOID AFTER

T.M.  
7.3.80

041  
1.97Ac.

TU