


#13673

SEE 2-02-

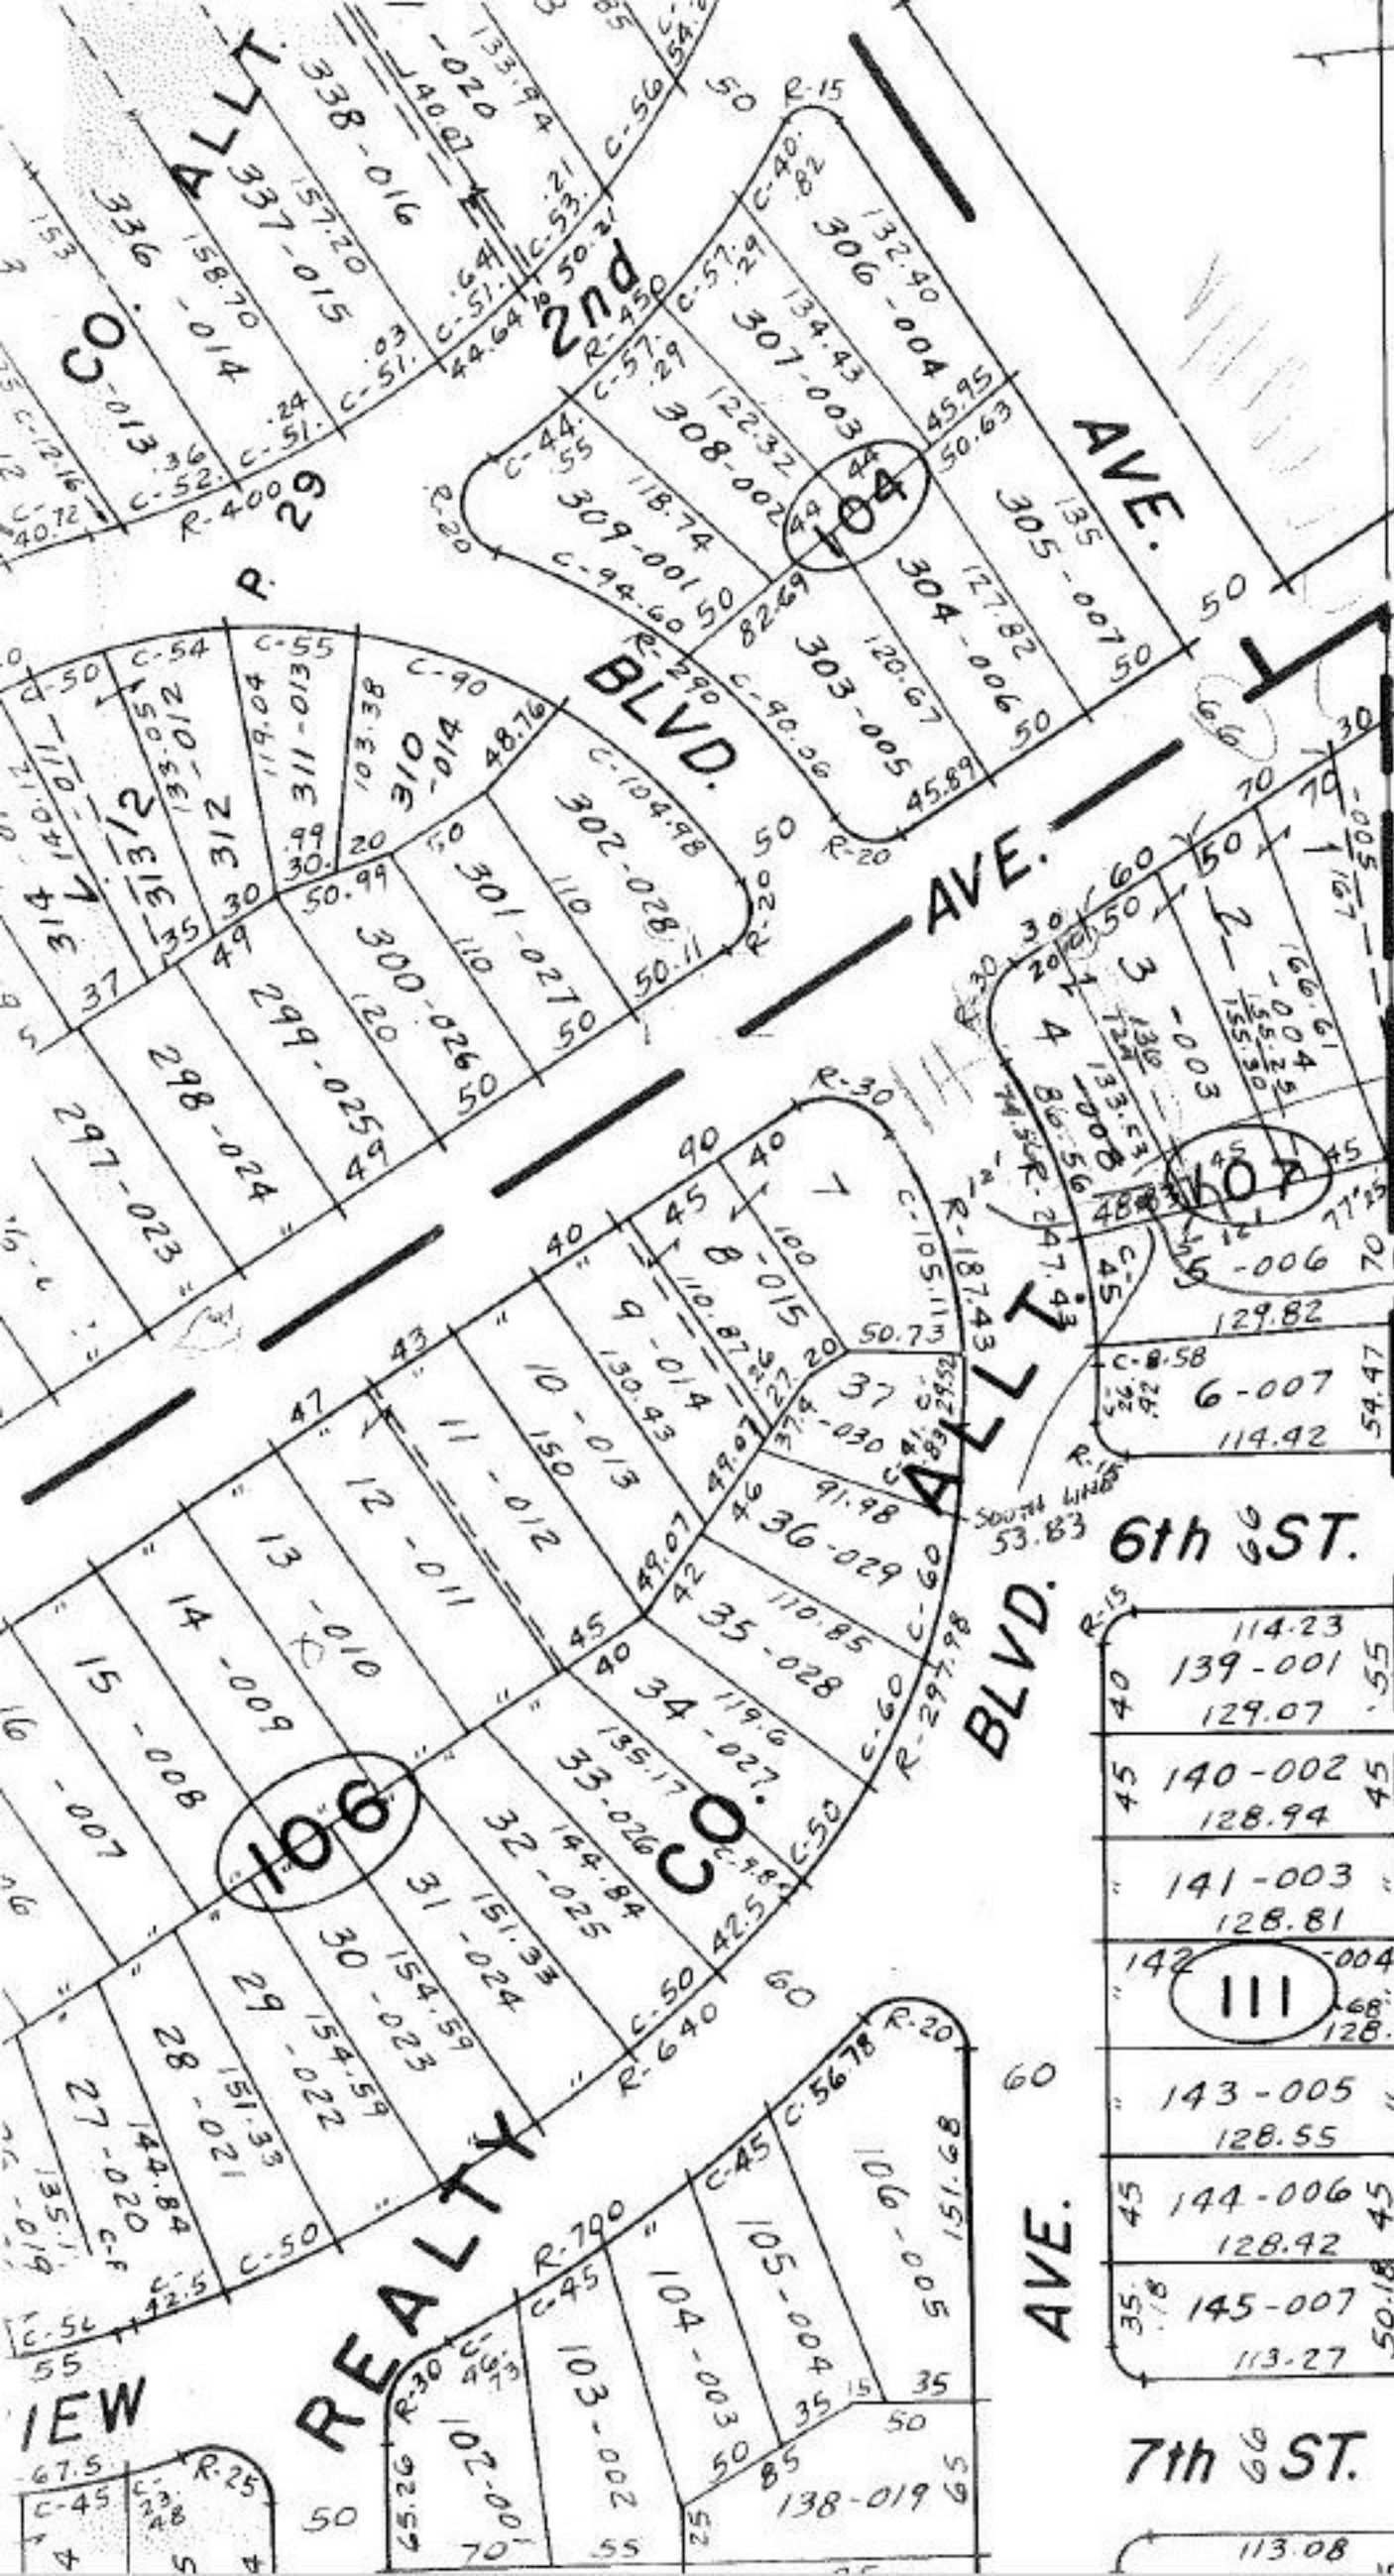

NORTH LINE  
53.83

-009  
12x53.83

86.56  
12  
74.56

6th ST.

#13673

APPROVED  
LORAIN CO.  
MAP DEPT.

DATE 7-8-80

PAGE 02-02-02

BY T.M. Yain

VOID  
AFTER

T.M.  
3-18-81

40	114.23	45
40	139-001	45
40	129.07	45
45	140-002	45
45	128.94	45
45	141-003	45
45	128.81	45
42	142-004	45
45	143-005	45
45	128.55	45
45	144-006	45
45	128.92	45
35	145-007	50.18
35	113.27	50.18

7th ST.

113.08