


SEE 4-B

500

N. Y. C. & B. ST. L.

R. R.

83

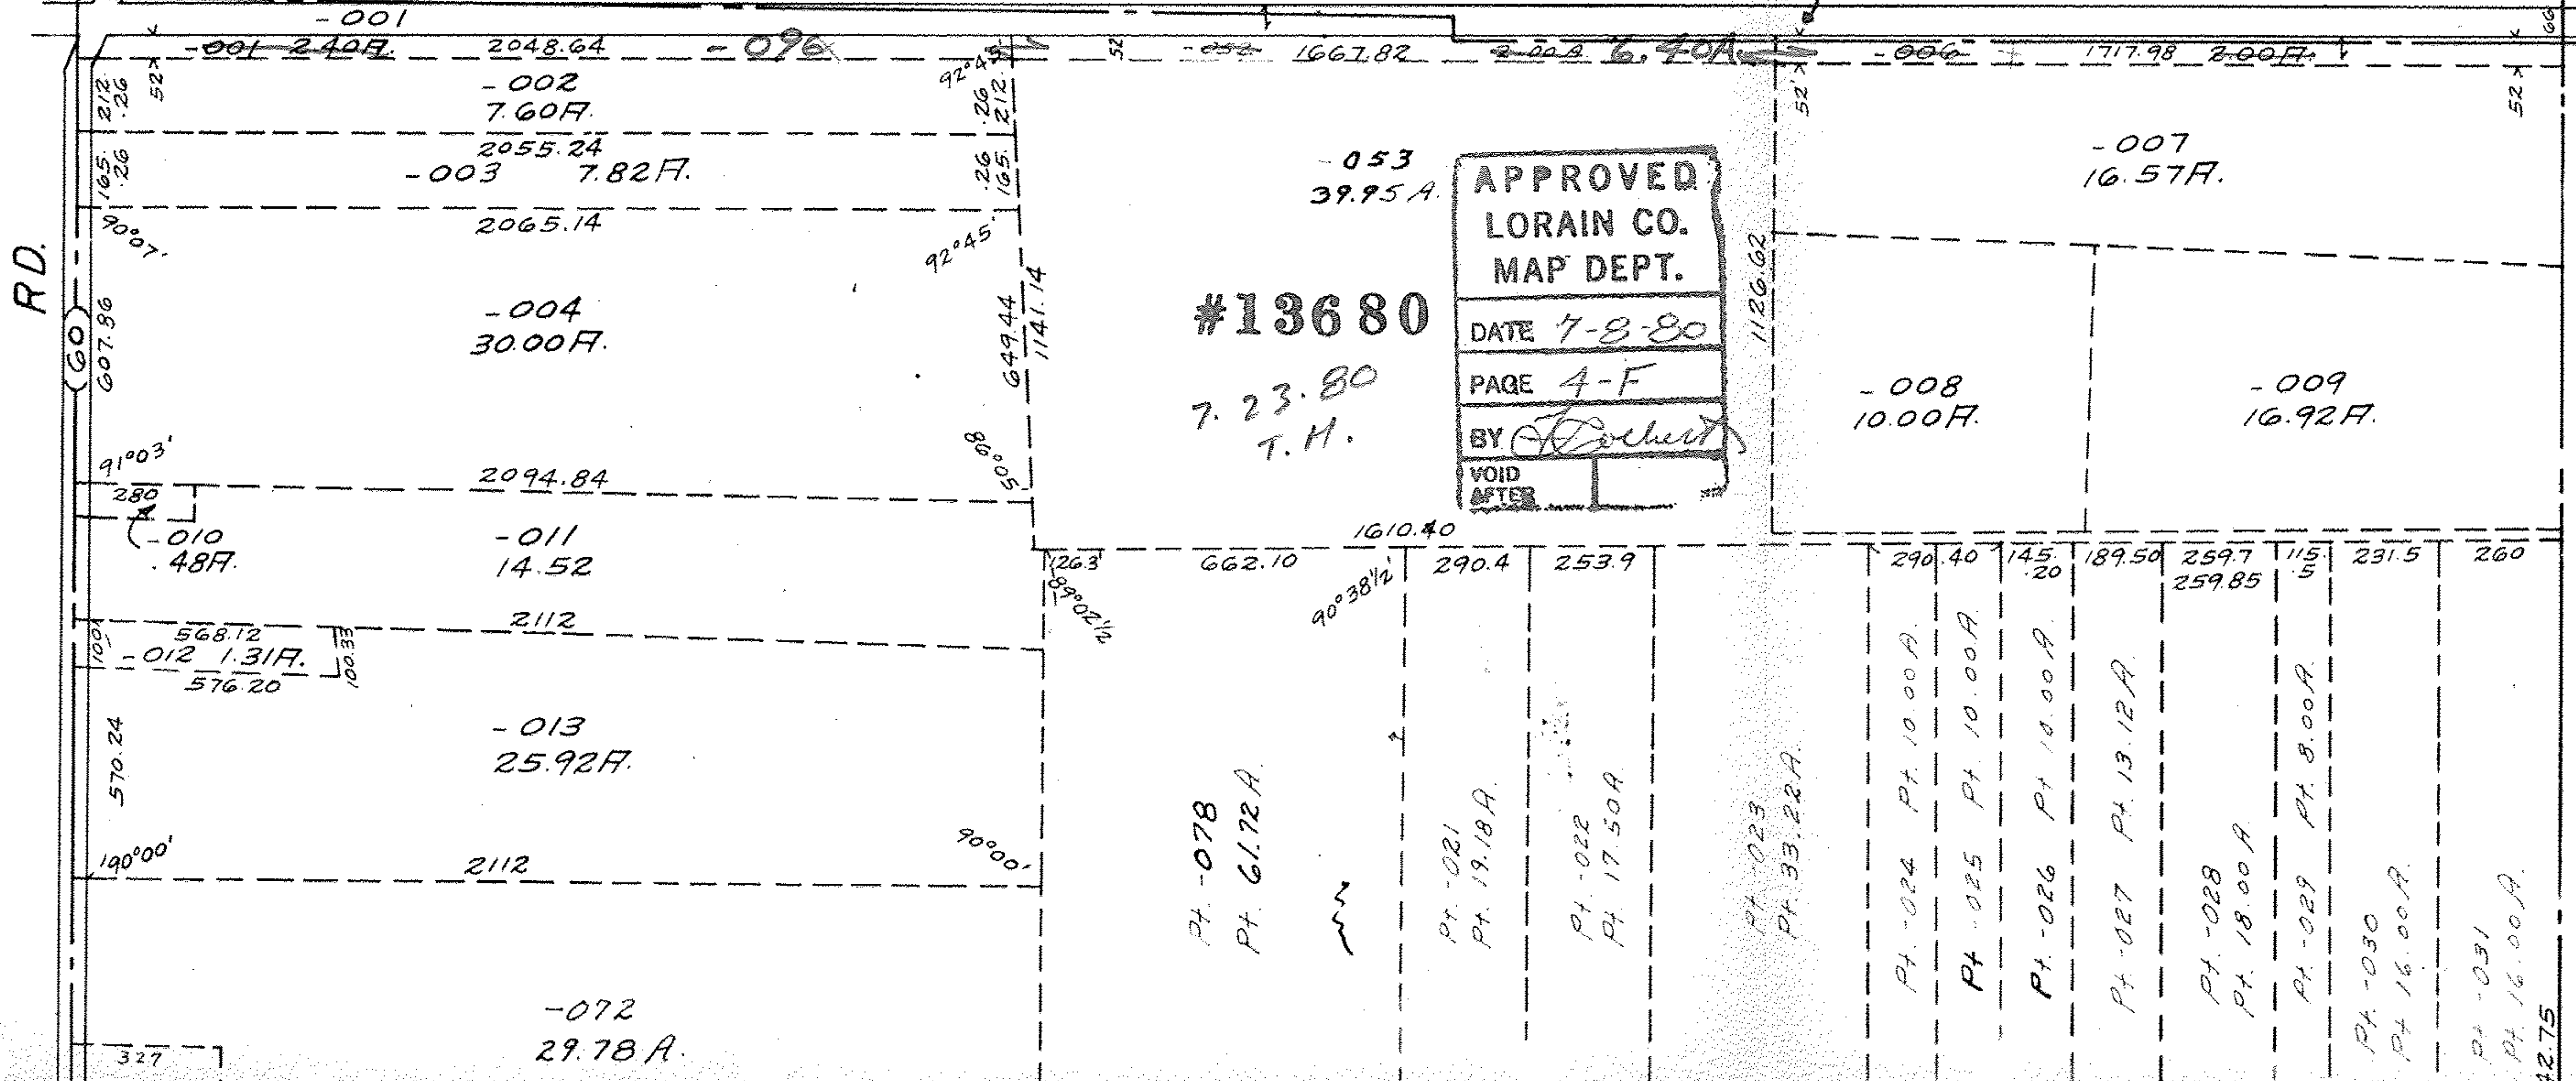

#13680

7.23.80 T.H.

APPROVED  
LORAIN CO.  
MAP DEPT.  
DATE 7-8-80  
PAGE 4-F  
BY [Signature]  
VOID AFTER [Signature]

Pt. -078  
Pt. 61.72A.

Pt. -021  
Pt. 19.18A.

Pt. -022  
Pt. 17.50A.

Pt. -023  
Pt. 33.22A.

Pt. -024 Pt. 10.00A.

Pt. -025 Pt. 10.00A.

Pt. -026 Pt. 10.00A.

Pt. -027 Pt. 13.12A.

Pt. -028  
Pt. 18.00A.

Pt. -029 Pt. 8.00A.

Pt. -030  
Pt. 16.00A.

Pt. -031  
Pt. 16.00A.

Pt. -032  
Pt. 142.75

SEE

4-00-016-A

SEE

4-00-016-B

RD.

60