

#13681
Pt. -085
Pt. 32.46 Ac.

(101)

Pt. -045
Pt. 26.01

196.18
372.25
568.43

#13683
#13682
#13681


APPROVED
LORAIN CO.
MAP DEPT.
DATE 7-5-50
PAGE 4-10-100 G
BY (Signature)
YEAR 1950

T.M.
7-23-50

6/2

SEE 4-00-006-B

13681 #
28
28
28

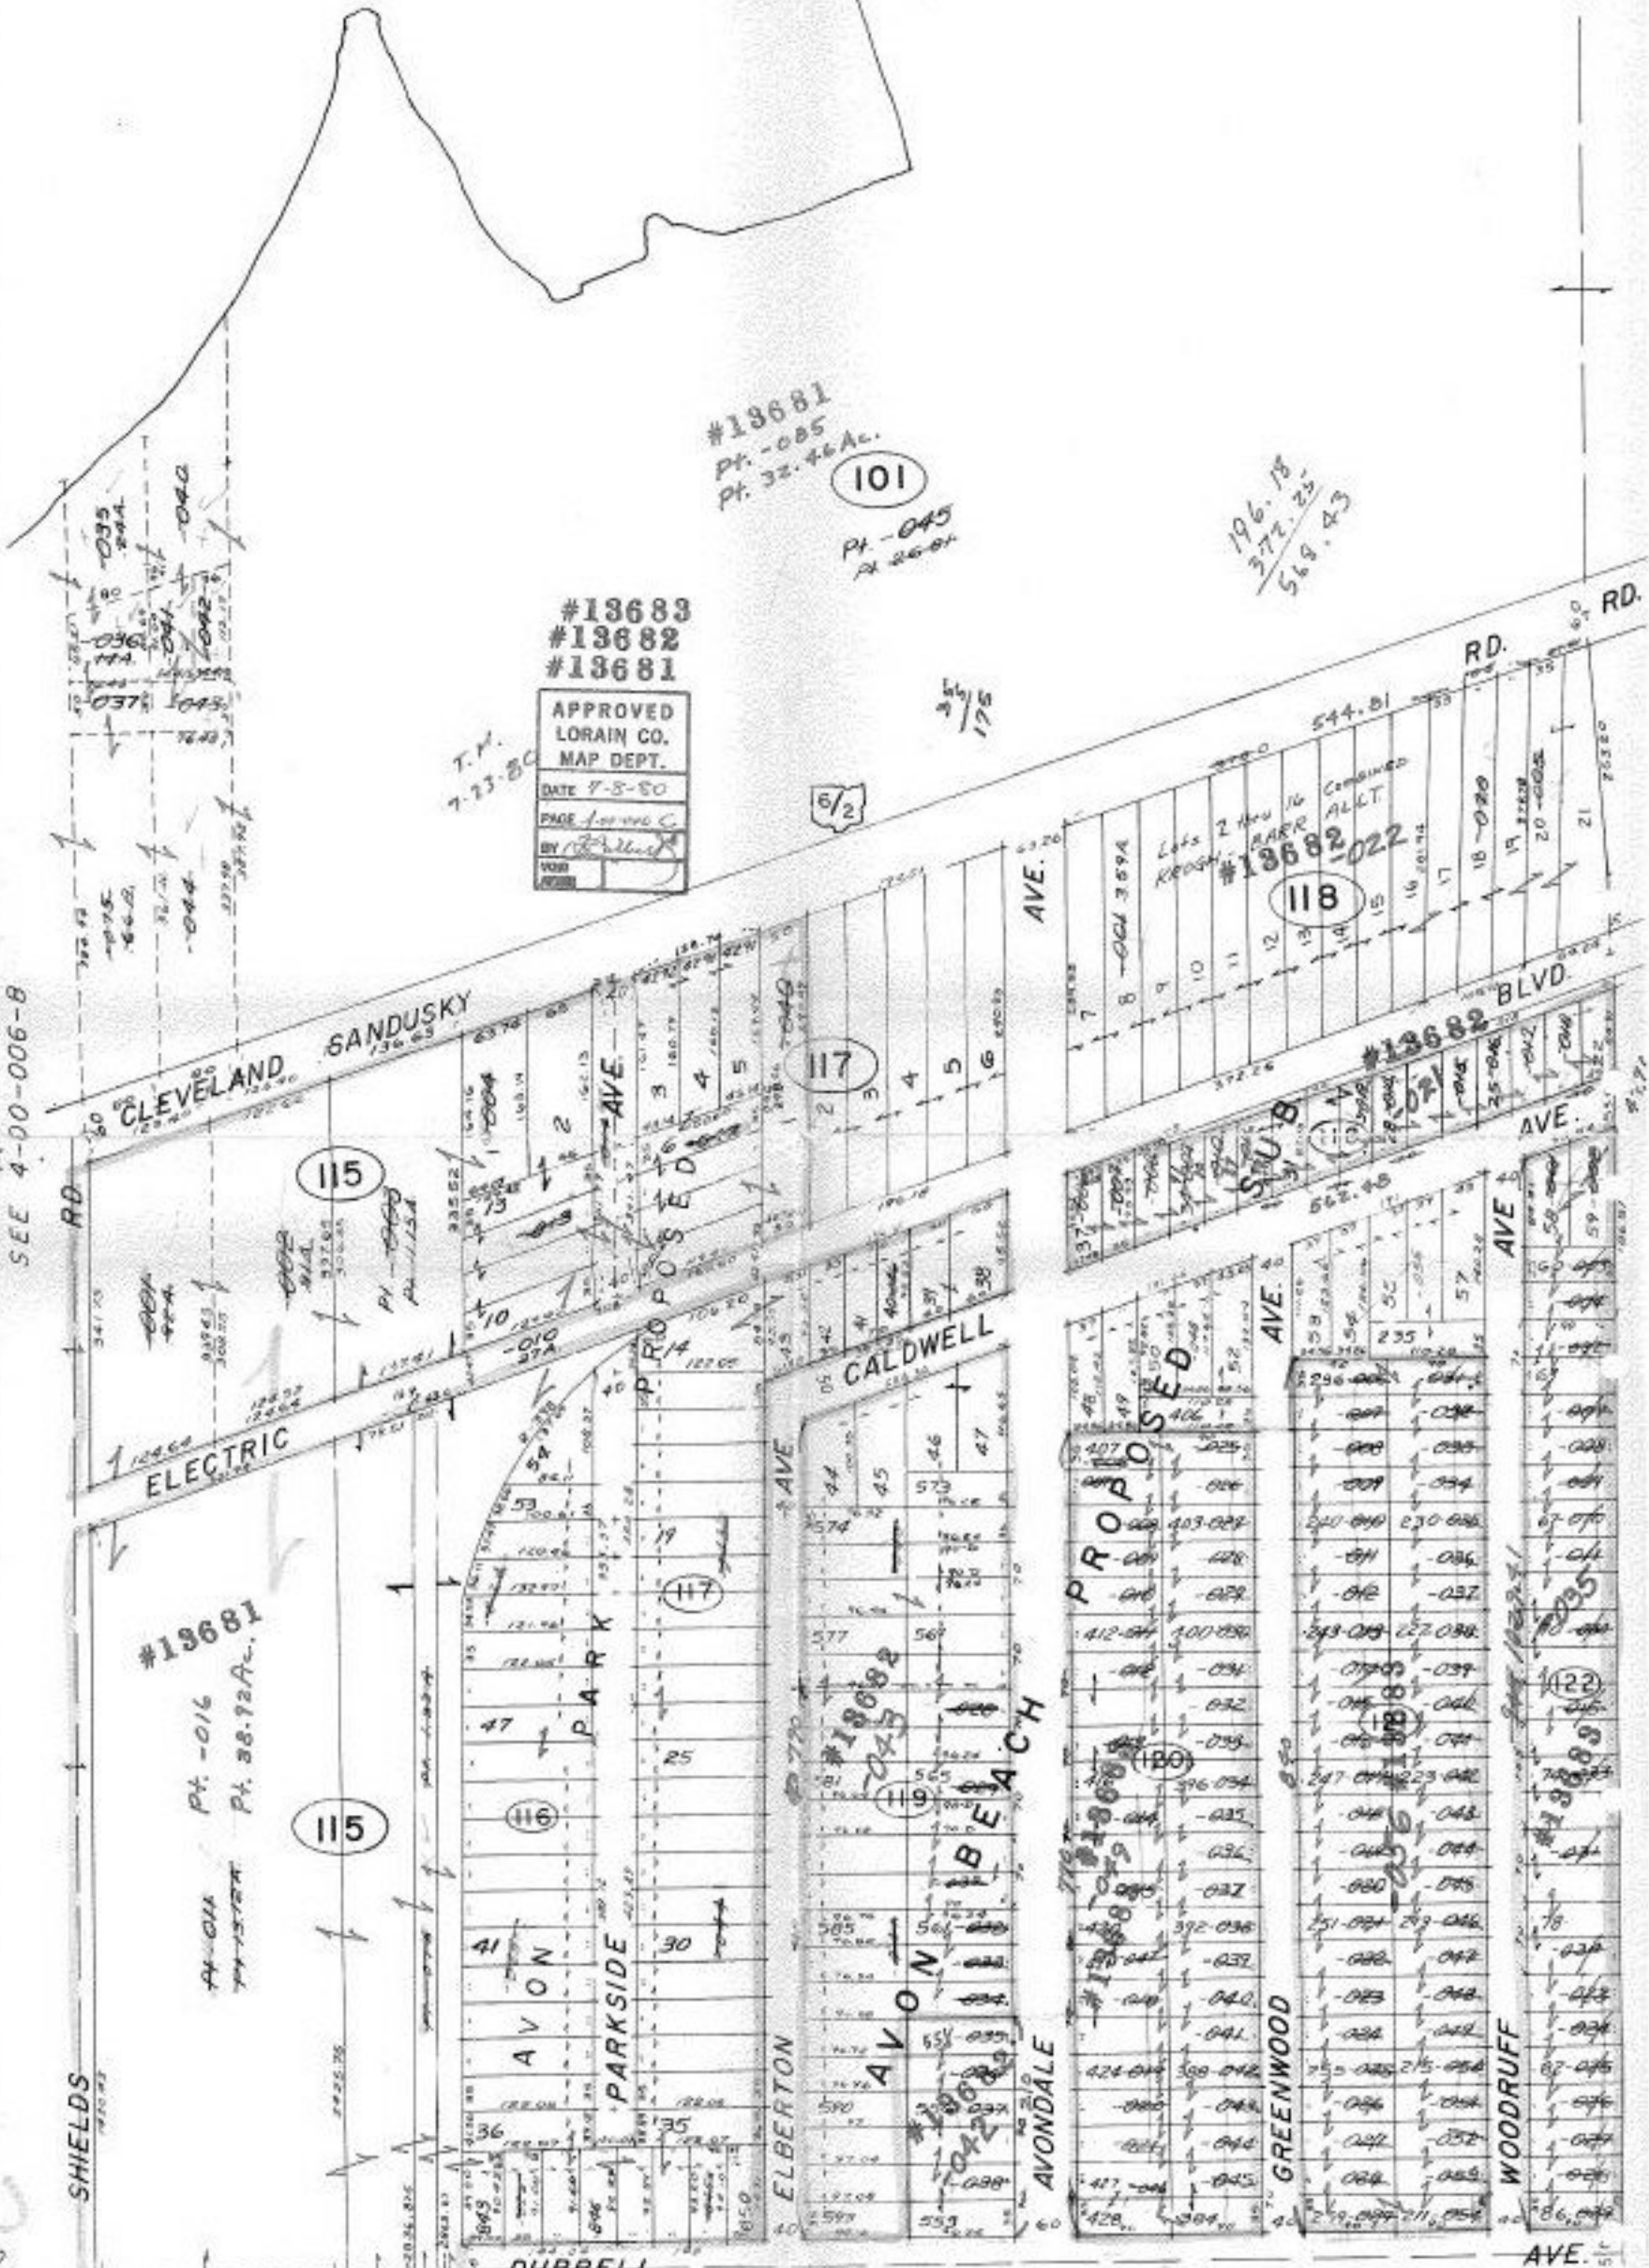

SEE 4-00-006-G
#13681-82-83