


DURRELL

AVE.

#13687
#13686
#13685
#13684
#13681

APPROVED
LORAIN CO.
MAP DEPT.
DATE 7-18-20
PROJECT
BY
YOUR
FILE

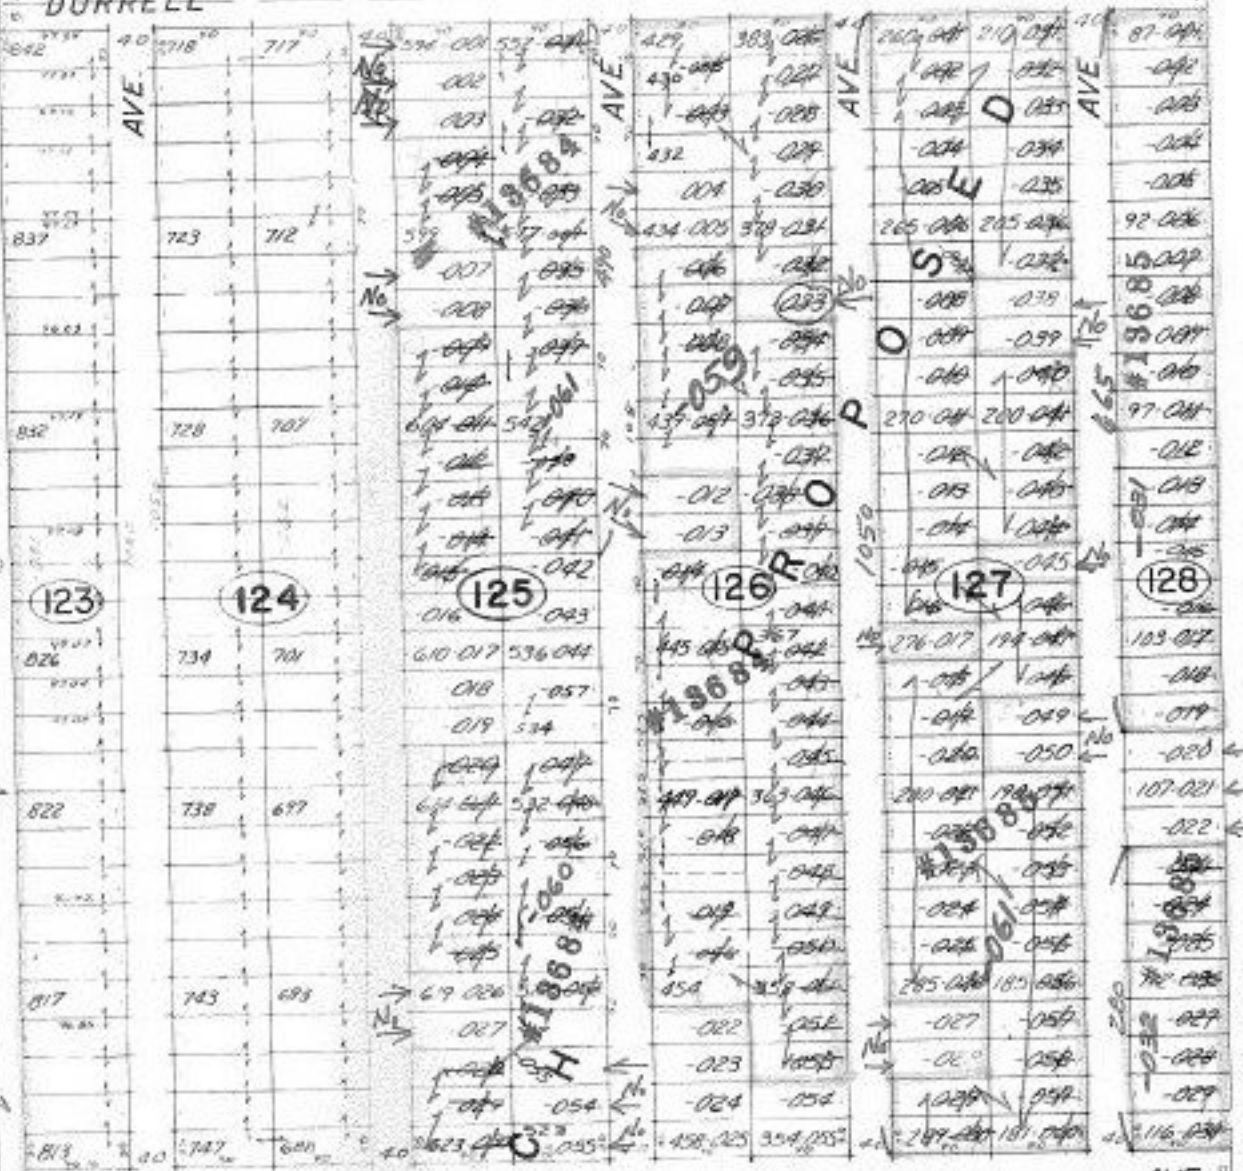

CLINTON

#13681
Pt. 016
Pt. 18.92 A.C.



SEE 4-00-006-F

13681
13682
13683
13684
13685
13686
13687

WALKER

13681-84-85-86-87

RD.