


DURRELL

AVE.

#13687
#13686
#13685
#13684
#13681

| |
|--------------|
| APPROVED |
| LORAIN CO. |
| MAP DEPT. |
| DATE 7-18-20 |
| PROJECT |
| BY |
| YOUR |
| FILE |

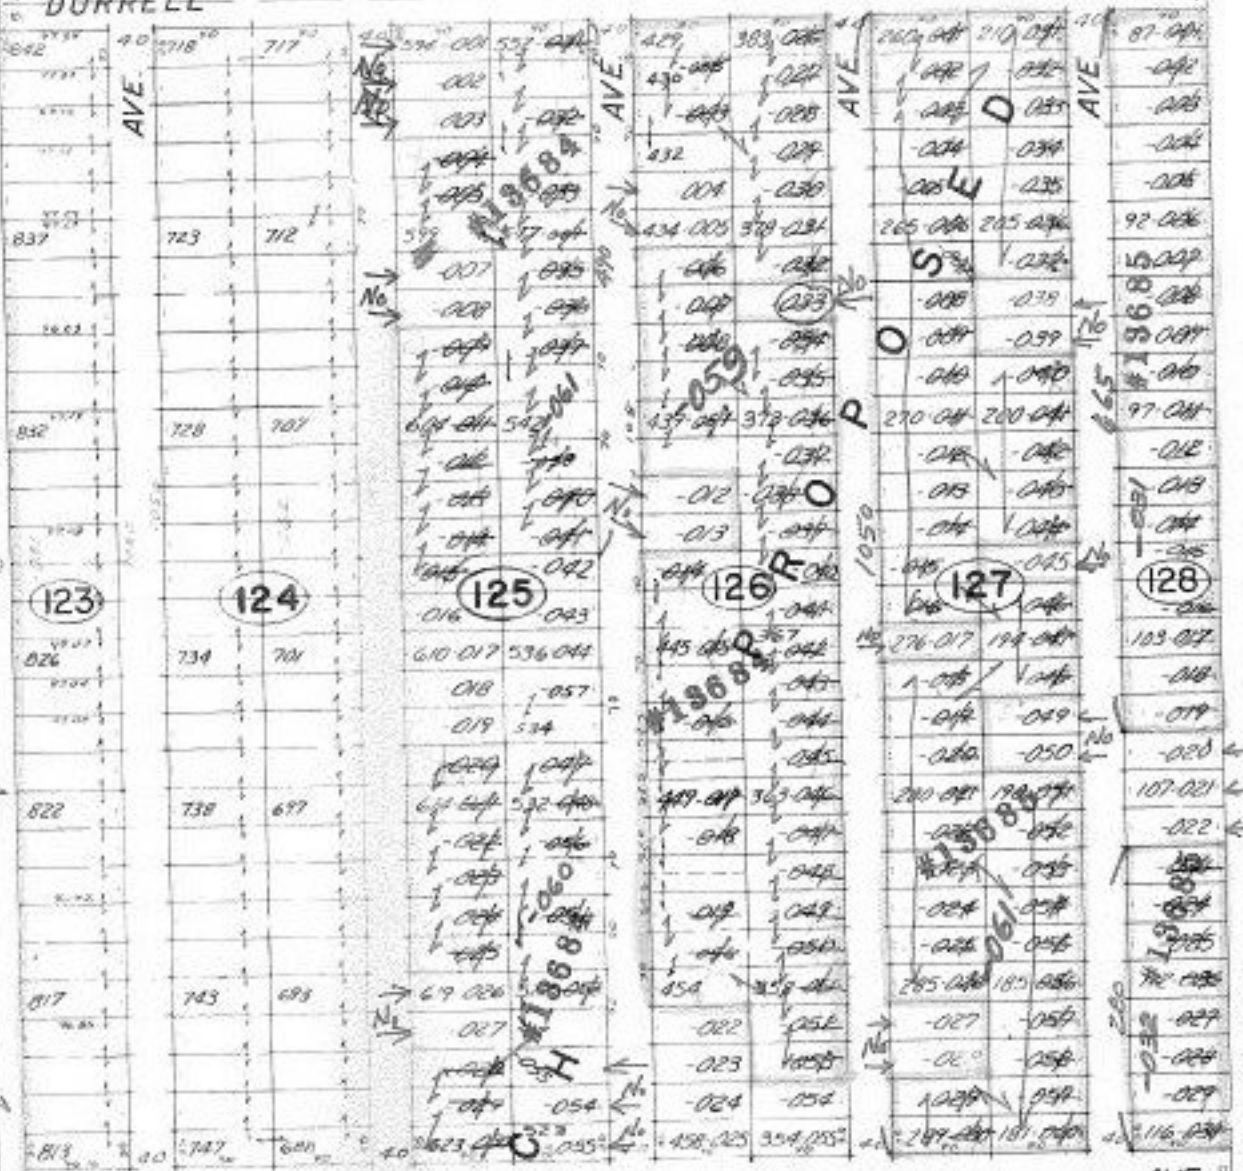

CLINTON

#13681
Pt. 016
Pt. 18.92 A.C.

115



SEE 4-00-006-F

SHIELDS

012
028A

WALKER

13681-84-85-86-87

RD.