

Black

River

#13693

APPROVED  
LORAIN CO.  
MAP DEPT.

DATE 8-25-18

PAGE 2-00-051-B

BY T.M. Mac

VOID AFTER

NOTE: THIS IS REVISED  
MAP AS FIRST ONE  
WAS LOST

T.M.  
3.18.01

126.80  
126.80  
-032  
8.28 A.


139

6.90  
30.14  
-028  
0.01 A.  
28.12  
6.68

DETAIL

IDAHO

BRIDGE

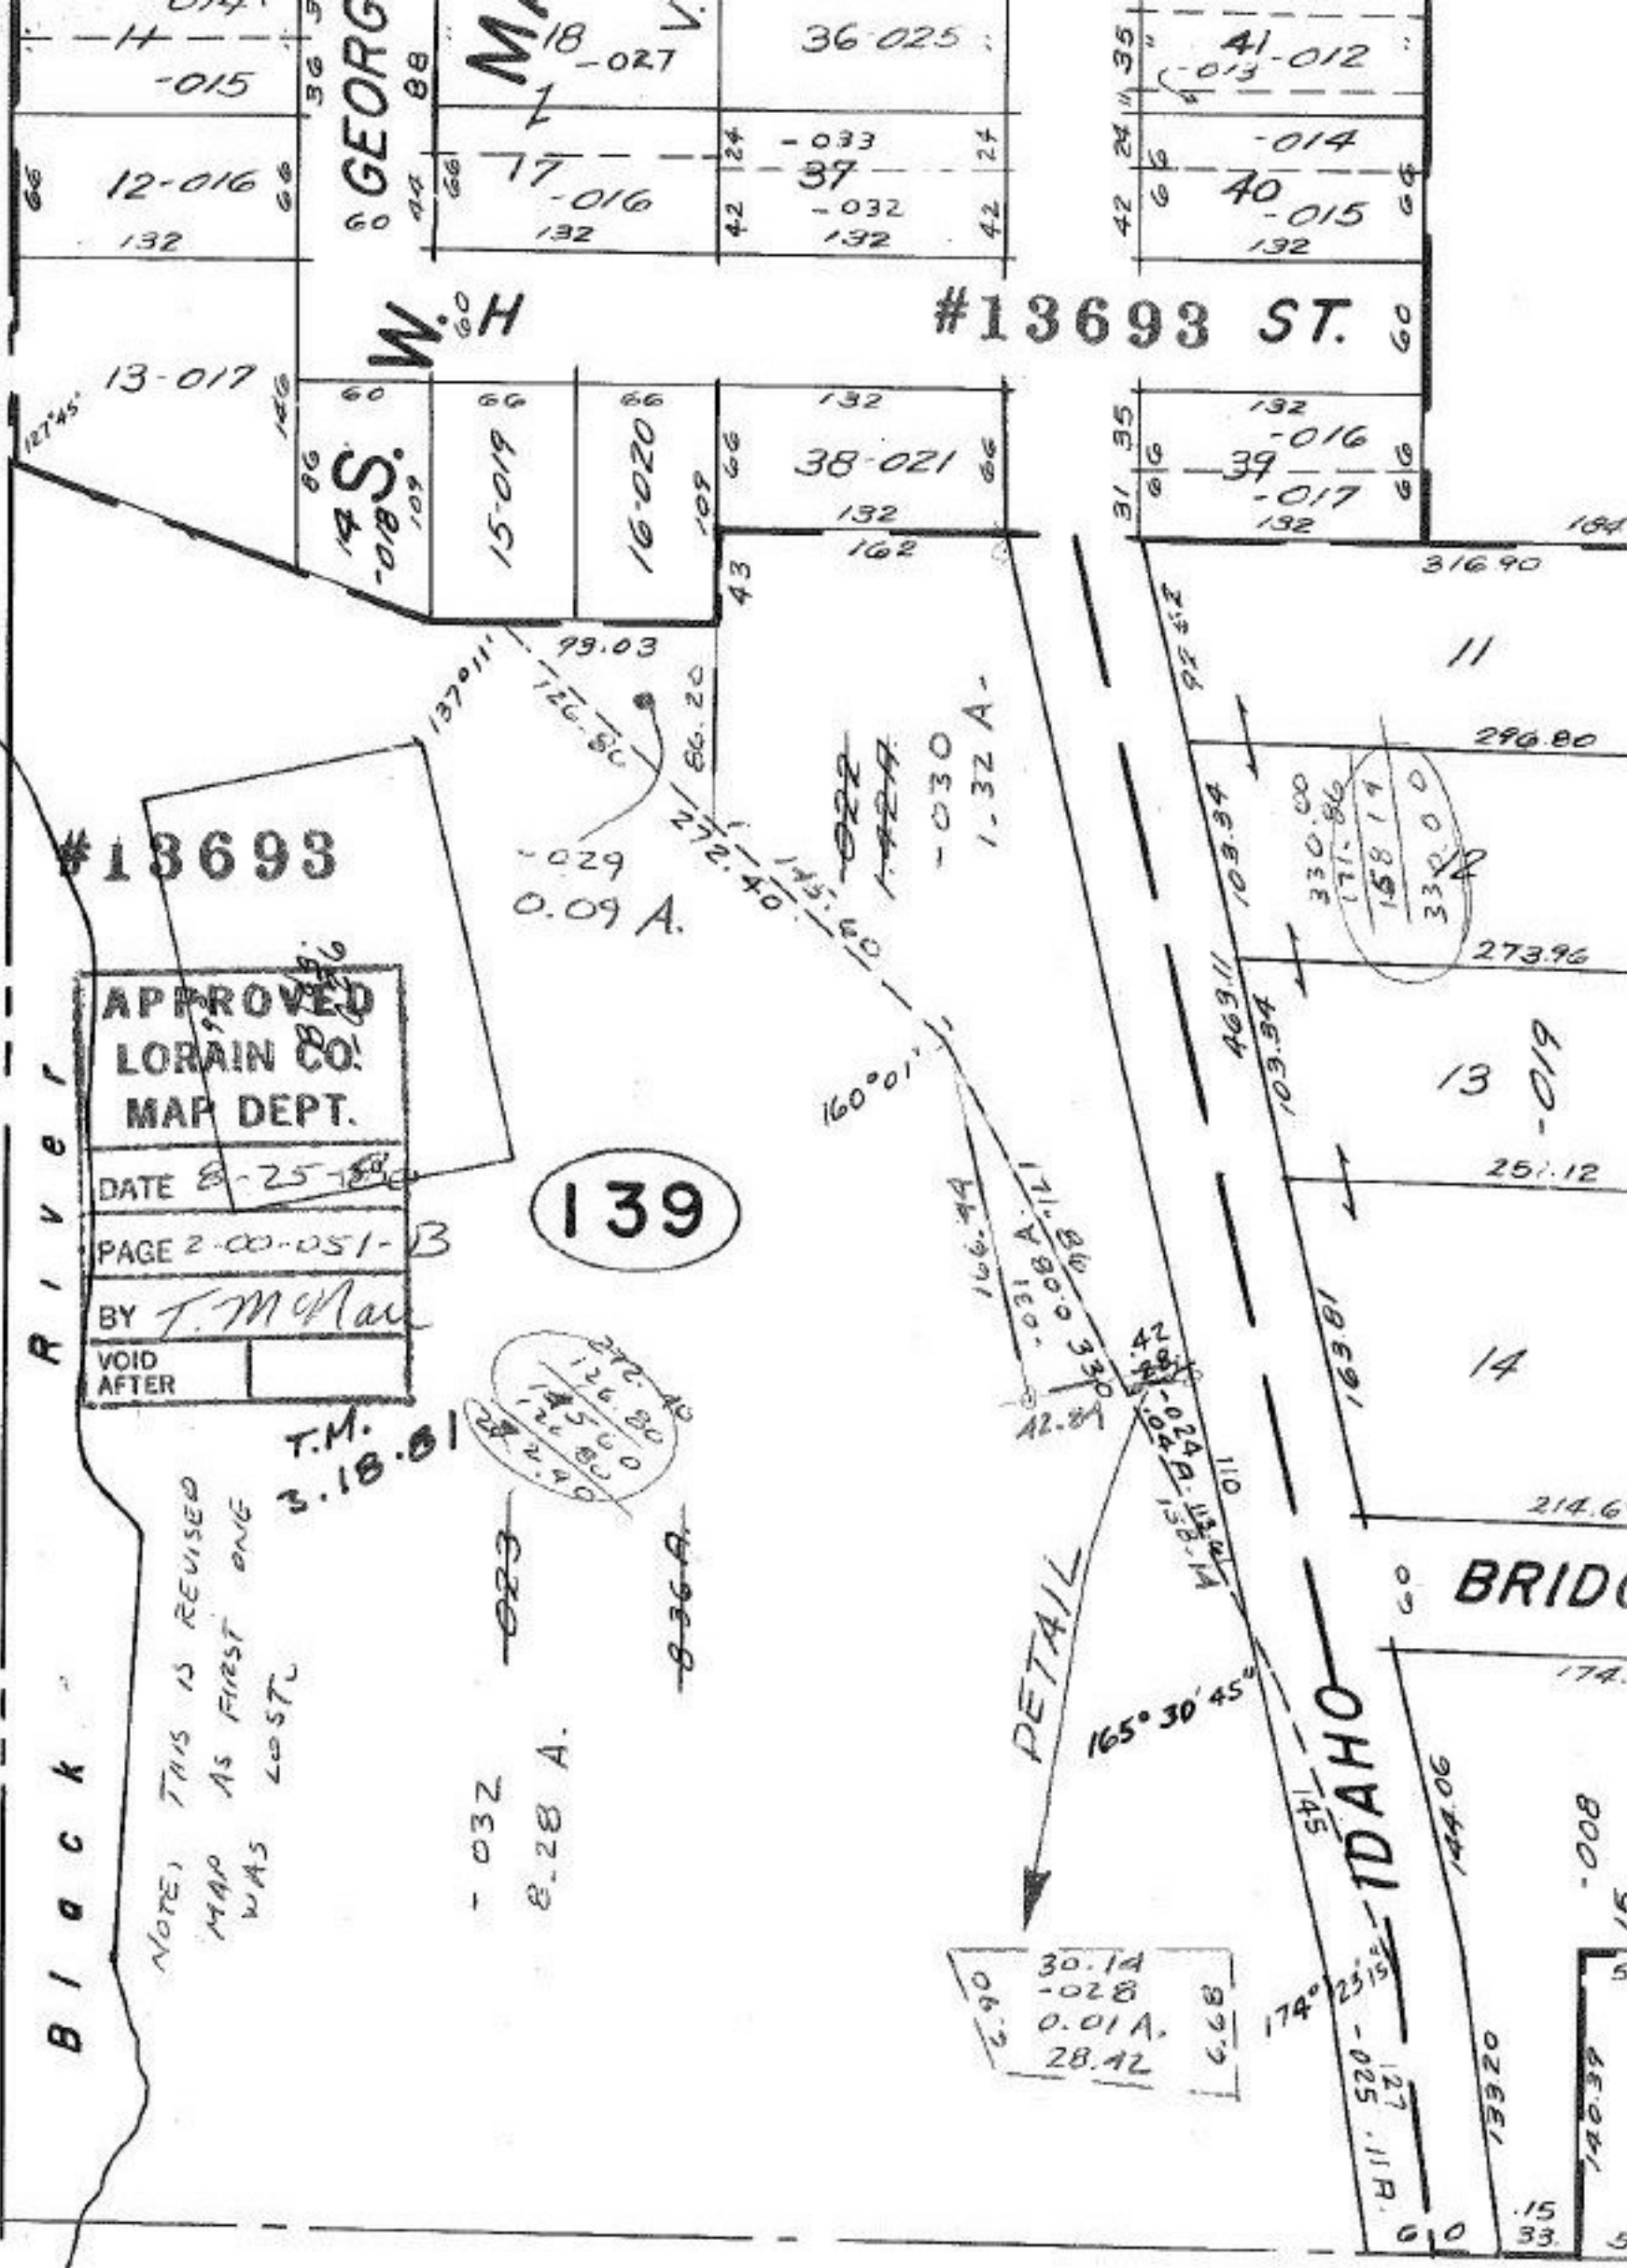

GEORG

M 18-027

36-025

41-012

12-016  
132

17-016  
132

37-032  
132

40-015  
132

W.H

#13693 ST.

13-017

14 S. 018

15-019

16-020

38-021

39-017

#13693

APPROVED  
LORAIN CO.  
MAP DEPT.

DATE 8-25-18

PAGE 2-00-051-B

BY T.M. Mac

VOID AFTER

NOTE: THIS IS REVISED  
MAP AS FIRST ONE  
WAS LOST

T.M.  
3.18.01

126.80  
126.80  
-032  
8.28 A.

139

6.90  
30.14  
-028  
0.01 A.  
28.12  
6.68

DETAIL

IDAHO

BRIDGE