


Pt. -062  
Pt. 27.38A.

*Handwritten note:* 27.38A

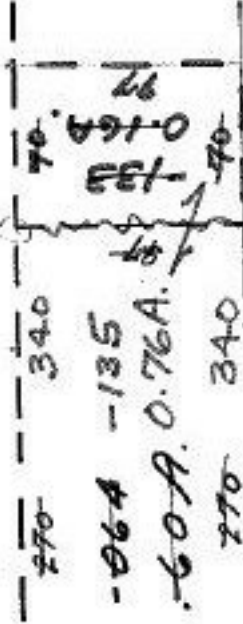

#13697

APPROVED.
LORAIN CO.
MAP DEPT.
DATE 7-14-80
PAGE 4-00-013 G
BY <i>J. G. ...</i>
VOID AFTER

-134  
~~-063~~  
9.27A.  
9.11A.  
#13697

T.M.  
7.24.80

-065  
7.67A.